



Post Office Box 3005
2831 Talleyrand Avenue
Jacksonville, Florida 32206-0005
www.jaxport.com

January 30, 2025

ADDENDUM NO. 01

TO SPECIFICATIONS AND CONTRACT DOCUMENTS FOR INVITATION TO BID CRUISE TERMINAL NEW GANGWAY JPA CONTRACT NO.: C-2017C

The item(s) of this Addendum shall modify and become a part of the contractual documents for this project as of this date.

(Failure to acknowledge this addendum will be grounds for rejection of proposal)

PHYSICAL CHANGES TO CONTRACT SPECIFICATIONS

Item No. 01

Reference to “**DRAWINGS**”, **DELETE** in its entirety and **REPLACE** with **REVISED “DRAWINGS”**.
(See Attachment No. 5)

Item No. 02

Reference to “**BID FORM, Pages BF-1 to BF-3**”, **DELETE** in its entirety and **REPLACE** with **REVISED “BID FORM, Pages BF-1 to BF-3”**. (See Attachment No. 6)

ATTACHMENTS TO CONTRACT SPECIFICATIONS

Attachment No. 1 - Optional Pre-Bid Meeting Minutes held on Tuesday, January 21, 2025 at 10:00 AM (ET)

Attachment No. 2 - Optional Site Visit Attendance held on Tuesday, January 21, 2025 at 2:00 PM (ET)

Attachment No. 3 - Response to Questions submitted by Email and in Trimble Unity Construct (e-Builder)

Attachment No. 4 - Summary of Changes

Attachment No. 5 - Revised Drawings

Attachment No. 6 - Revised Bid Form, Pages BF-1 to BF-3

Attachment No. 7 - Existing Gangway Drawings from ITB_C-1642 (See Addendum Question #3)

Acknowledgment of the following addenda is hereby made:

Addendum #1, Dated: _____ Initials _____

Company _____

NOTE: THIS ADDENDUM SHALL BE ACKNOWLEDGED IN YOUR BID SUBMISSION, FAILURE TO ACKNOWLEDGE ADDENDUM MAY BE GROUNDS FOR REJECTION OF BID.

PLEASE VISIT [HTTP://WWW.JAXPORT.COM/PROCUREMENT/ACTIVE-SOLICITATIONS](http://www.jaxport.com/procurement/active-solicitations) PRIOR TO THE BID OPENING TO DETERMINE IF ANY ADDENDA HAVE BEEN RELEASED ON THIS CONTRACT.

PRE-BID MEETING MINUTES
JPA Contract: ITB C-2017C
CRUISE TERMINAL NEW GANGWAY

Date: Tuesday, January 21, 2025

Time: 10:00 AM

Good morning! It is now **10:00 AM** on **Tuesday, January 21, 2025** and the Pre-Bid Meeting for JPA Contract No. **ITB_C-2017C CRUISE TERMINAL NEW GANGWAY** will now begin.

This meeting is being held via **ZOOM Meeting** teleconference which allows interested persons to view and participate remotely.

This meeting is subject to Florida Sunshine Laws and therefore, is being recorded.

We will begin the meeting by introducing JAXPORT Staff Members:

Outside companies asked to please type their full name and the company they were representing in the "Chat Box" as I introduced the JAXPORT Staff in attendance.

JAXPORT STAFF IN ATTENDANCE:

- | | |
|---|---------------------------------------|
| ☒ Name: Jerrie Gunder | Title: Sr. Contract Specialist |
| ☒ Name: Retta Rogers | Title: Director, Procurement Services |
| ☒ Name: Sandra Platt | Title: Manager, Procurement Services |
| ☒ Name: Terri Lemon-Scott | Title: Contract Specialist |
| ☒ Name: Jose Vazquez | Title: Director, Project Management |

IDENTIFY MEMBERS OF PUBLIC ATTENDEES

Please clearly state your name and the company you are representing. *(Allow time for each person to speak, add their name to the Attendance list, and ask again at the conclusion of the meeting for verification).*

COMPANIES' ATTENDANCE RECORD OF PRE-BID MEETING <i>(listed in alphabetical order by company's name)</i>	
REPRESENTING AGENT	COMPANY'S NAME
1. Rafael Caldera	Arkest, LLC
2. Ria Skinner	Callan Marine
3. Mike Deen	J. Lane Construction
4. Patrick Rogers	J. Lane Construction
5. Ali Hakimi	Pars Constructions

Instructions for all participants/members of the public –

To avoid any microphones transmitting sounds that causes feedback, echoes or sounds what will otherwise cause a disruption to this meeting, participants (regardless of how they are accessing this meeting) are asked to keep their microphones on “mute” at all times when not speaking. PLEASE TAKE A MOMENT AND “MUTE” YOUR MICs FOR THIS MEETING.

- i. Any individual who wishes to speak, should “*unmute*” their microphones and wait to be recognized by the host before speaking.
- ii. When called upon, please announce your name and the company you are representing.
- iii. Each person speaking should do so clearly and slowly to ensure they are heard and understood for recording purposes and by other participants and attendees.

KEY DATES:

- **Bids Due: TUESDAY, FEBRUARY 11, 2025 at 2:00 PM (ET).** Invitation to Bids and all required supplemental material listed in the bid documents, must be submitted in **PDF Format Only** through E-Builder. **The PDF file name should read “C-2017C”.** JAXPORT no longer is accept any bid packages submitted by Email, Fax, Mail or Hand-Deliveries. Bids and supplemental documents submitted other than through Trimble Unity Construct (E-Builder) will not be accepted or considered. **Please visit JAXPORT’s website at www.jaxport.com for more information and updates.**
- **Site Visit:** A Site Visit will be held at **2:00 PM (TODAY), Tuesday, January 21, 2025.** Attendees of the SITE VISIT will meet at **JAXPORT Access Control Center (ACC), located at 9620 Dave Rawls Blvd., (Parking Lot), Jacksonville, FL 32226.** Due to the secure area of the project, attendees will be transported by JAXPORT Bus to the Cruise Terminal (DPCT) project location. **ALL ATTENDEES MUST WEAR A HARD HAT, SAFETY BOOTS AND VEST.**

To have a projective of attendance, immediately following this meeting please email me at Jerrie.Gunder@jaxport.com or call at (904) 357-3455 to have your name added to the attendance list. I will need Verification of a valid driver’s license or TWIC badge acknowledgement when adding your name to the roster.

NO QUESTIONS WILL BE ANSWERED DURING THE SITE VISIT. ATTENDANCE BY A REPRESENTATIVE OF EACH PROSPECTIVE BIDDER IS ENCOURAGED.

- **Questions:** The deadline to submit questions my e-mail at jerrie.gunder@jaxport.com or through eBuilder by **Friday, January 24, 2025 by 4:00 PM (ET).** Any questions regarding this project must be submitted in writing with the **SUBJECT NOTED AS: ITB_C-2017C.** Please do not send questions to anyone else. Any questions received will be address via an addendum to all potential bidders registered in E-builder and posted on the JAXPORT’s website.

ARE THERE ANY QUESTION REGARDING “HOW” TO SUBMIT YOUR BIDS?

SEB Requirements: There are no SEB Goals on this project, however, participation is encouraged. Questions regarding SEB information or to obtain a list of possible Subcontractors and Suppliers, please contact Michael McCoy at (904) 357-3003.

Scope of Services: Jose Vazquez will give an overview of the Scope of Work for this project.

INVITATION TO BID DOCUMENTS

The Invitation to Bid document can be reviewed from our website: <https://www.jaxport.com/procurement/active-solicitations/>

- **Site Visit:** A **Site Visit** will be held at **2:00 PM (TODAY), Tuesday, January 21, 2025**. Attendees of the SITE VISIT will meet at **JAXPORT Access Control Center (ACC), located at 9620 Dave Rawls Blvd., (Parking Lot), Jacksonville, FL 32226**. Due to the secure area of the project, attendees will be transported by JAXPORT Bus to the Cruise Terminal (DPCT) project location. **ALL ATTENDEES MUST WEAR A HARD HAT, SAFETY BOOTS AND VEST.**

To have a projective of attendance, immediately following this meeting please email me at Jerrie.Gunder@jaxport.com or call at **(904) 357-3455** to have your name added to the attendance list. I will need Verification of a valid driver's license or TWIC badge acknowledgement when adding your name to the roster.

- **Bidder Requirements:** Page BCF-1 *(list of documents required to be submitted with bid. It is mandatory that all required documents be uploaded in e-Builder when submitting your bids.)*
- **Question & Answers:** **4:00 PM (ET), FRIDAY, JANUARY 24, 2025** and submitted only to my email at Jerrie.Gunder@jaxport.com or in Trimble Unity Construct (e-Builder). Any questions received will be address via an addendum.
- **Acknowledgment of Addenda** *(It is mandatory that the bidder acknowledge all addenda, the system will not allow you to submit your proposal until the addenda is acknowledged).*
- **Bids Due:** **Bids must be uploaded in E-Builder prior to 2:00 PM (ET), TUESDAY, FEBRUARY 11, 2025. The submit button will deactivate exactly at 2:00 PM and you will not be permitted to submit your bid regardless of where you are in the process. Please Plan accordingly.**
- If you should have any questions regarding the solicitation package, please submit them **by e-mail to my attention at:** Jerrie.Gunder@jaxport.com or through Trimble Unity Construct (e-Builder).

Note: These minutes shall become a part of the solicitation documents and contract agreement. Any corrections, additions or errors will be brought to the attention of the Project Manager within 5 days after receipt of the minutes. It shall be the responsibility of the contractor submitting a proposal for this contract to ensure that all Subcontractors, Suppliers, and services that are incorporated into his proposal have received benefit of the minutes and any addenda that may be issued.

Please clearly state your name and the company you are representing. *(Allow time for each person to speak, add their name to the Attendance list, and ask again at the conclusion of the meeting for verification).*

Thank you for your participation and we look forward to your bid submission.

Meeting adjourned at **10:12 AM**

Prepared By **Jerrie Gunder, Senior Contract Specialist**

JAXPORT CONTRACT NO.: ITB_C-2017C
CRUISE TERMINAL NEW GANGWAY
Optional Site Visit Attendance List
Tuesday, January 21, 2025 at 2:00 PM

[illegible]



Post Office Box 3005
2831 Talleyrand Avenue
Jacksonville, Florida 32206-0005

ADDENDUM NO. 01

INVITATION TO BID

CRUISE TERMINAL NEW GANGWAY JPA CONTRACT NO.: C-2017C

RESPONSE TO QUESTION(S)

1. With the very restrictive schedule this project requires (150 Days), does Jaxport have plans to start the permitting process before the project is awarded so that process does not hold up the project...the permitting alone could take 120 days.?

ANSWER: The Contractor is responsible to file/obtain applicable permit(s).

2. Is there an alternate to Steel for this gangway? Could it be made of aluminum?

ANSWER: No.

3. Would you have a photo or drawing of a current gangway?

ANSWER: See Addendum Attachment No. 6 for the drawings of existing gangway.

“SUMMARY OF CHANGES”

C-2017C Cruise Terminal New Gangway

Addendum # 1 Summary of drawing revisions: ***(See Attachment No. 5)***

- Structural, Architectural, and Electrical updates for the 1’ elevation adjustment at the connection to the ship. The structure height was reduced by 1’ (structure section that connects to the ship). Main sheets affected: all sheets showing elevations including: S205, S301, S302, S503, A201
- Sheet S302, Section 3: Include hinged kickplate and dimensions (brow/gangway connection side)
- Sheet S104, Plan View/Detail 1: Added callouts for location of swing door(s) referenced in Detail 1/S503

Addendum # 1 summary of Bid Form revisions: ***(See Attachment No. 6)***

- Item # 3.04: added text “Alucobond Panels and” to item description



"REVISED DRAWINGS"

FOR

**CRUISE TERMINAL
NEW GANGWAY**

Project No.: D2025-01


Contract No.: C-2017C

DAMES POINT MARINE TERMINAL

JACKSONVILLE PORT AUTHORITY

DAMES POINT MARINE TERMINAL CRUISE TERMINAL GANGWAY

JPA CONTRACT NO. 5137
RS&H PROJECT NO. 10014153000

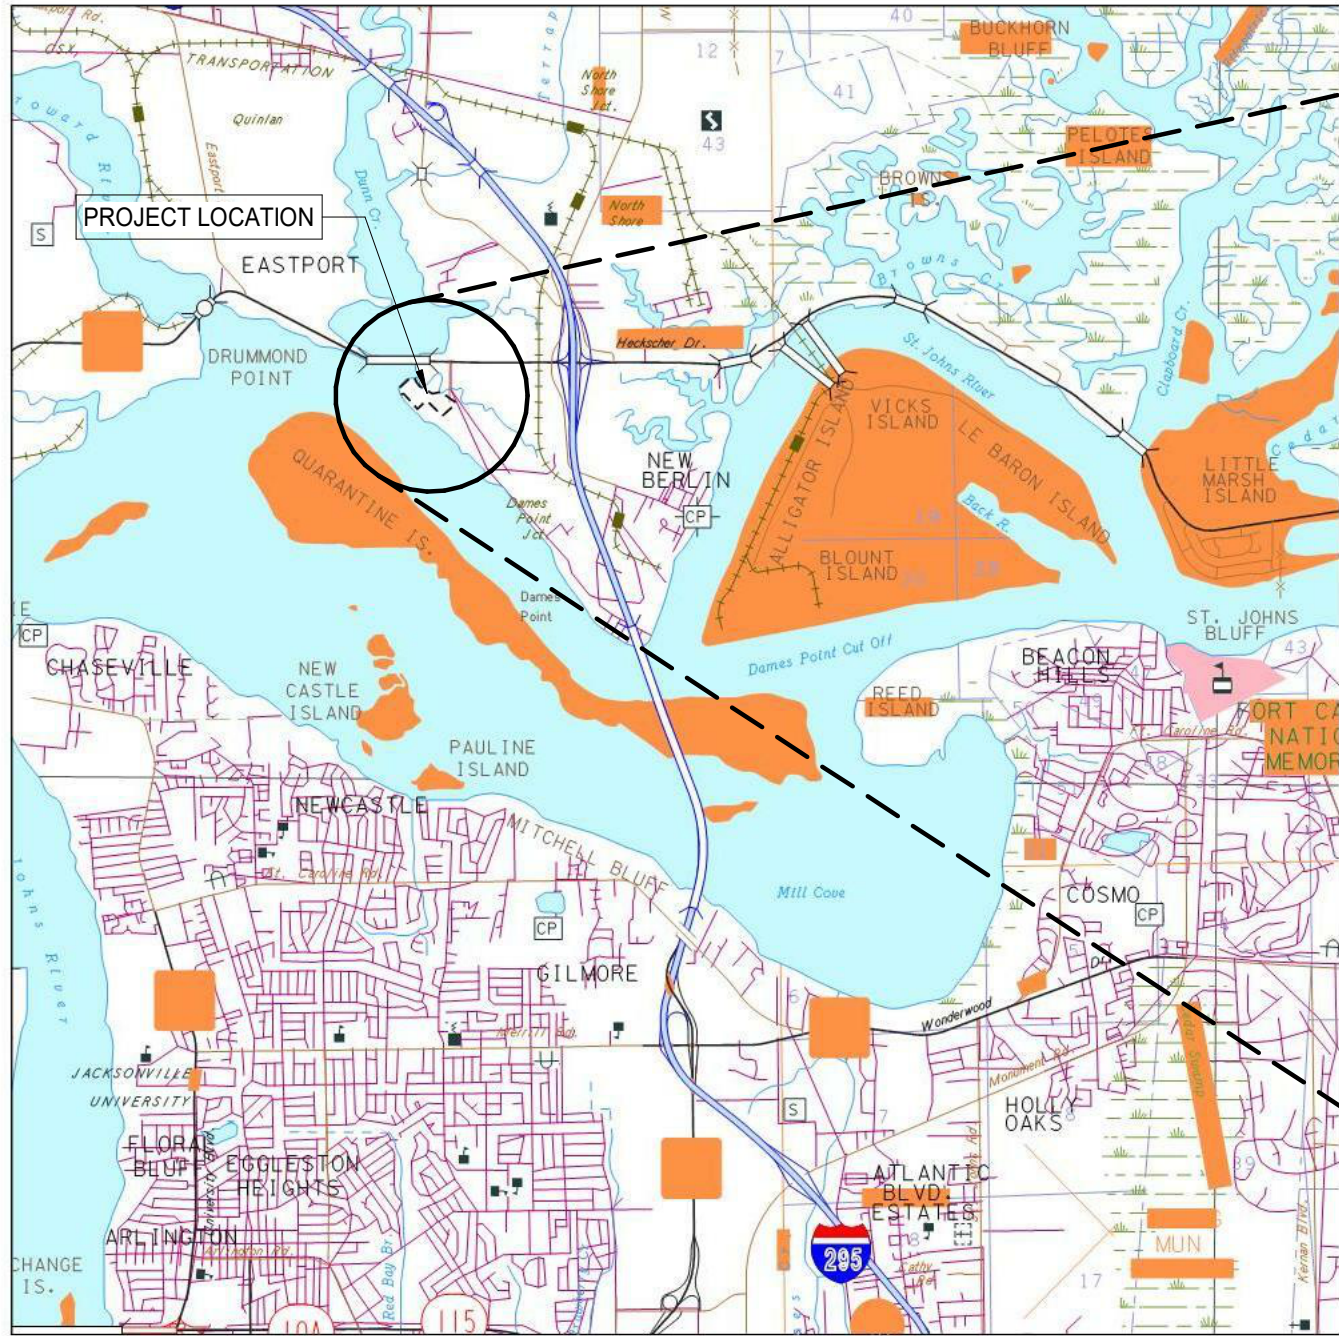

VICINITY MAP
JACKSONVILLE, FLORIDA



LOCATION MAP
JACKSONVILLE, FLORIDA

DRAWING SHEET INDEX	
SHEET NUMBER	SHEET NAME

G001	KEY SHEET AND SHEET INDEX
G002	GENERAL NOTES, ABBREVIATIONS, AND SYMBOLS
G003	SIGNATURE SHEET

S012	STRUCTURAL GENERAL NOTES
S013	STRUCTURAL ISOMETRICS
S101	FOUNDATION PLAN
S104	RAMP FRAMING PLAN - UPPER
S205	FRAMING ELEVATIONS
S301	STRUCTURAL SECTIONS - I
S302	STRUCTURAL SECTIONS - II
S401	ENLARGED LANDING PLANS
S501	FOUNDATION SECTIONS & DETAILS
S502	FRAMING SECTIONS & DETAILS - I
S503	FRAMING SECTIONS & DETAILS - II

A121	ROOF PLAN
A201	ELEVATIONS

E001	ELECTRICAL GENERAL NOTES, SYMBOLS AND ABBREVIATIONS
E002	ELECTRICAL SPECIFICATIONS
E003	ELECTRICAL SPECIFICATIONS
ES101	ELECTRICAL SITE PLAN
E601	ELECTRICAL PANEL SCHEDULES
E701	ELECTRICAL ONE LINE DIAGRAM
E901	ELECTRICAL ISOMETRICS



10748 Deerwood Park Blvd. South
Jacksonville, Florida 32256-0597
904-256-2500 Fax 904-256-2503
www.rsandh.com
FL Cert. Nos. AAC001886 * IB26000956 *
5620 * LCC000210 * GB238




PROJECT TITLE:
JAXPORT CRUISE TERMINAL
GANGWAY MODIFICATION

PROJECT ADDRESS:
9810 AUGUST DRIVE
JACKSONVILLE, FL 32226

REVISIONS		
NO.	DESCRIPTION	DATE

DATE ISSUED: 01/24/2025
REVIEWED BY: PFM
DRAWN BY: JAM
DESIGNED BY: LAP

PROJECT NUMBER:
10014153000

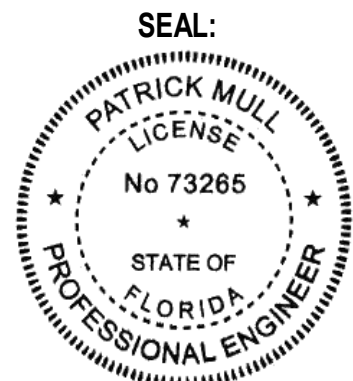

SHEET TITLE:
KEY SHEET AND
SHEET INDEX

SHEET ID:

G001

PROJECT STATUS:
100% SUBMITTAL
FOR CONSTRUCTION

ARCHITECTURAL ABBREVIATIONS			
& @ A.B. A.F.S. ADJ AFF ALUM ANOD. ANSI APPROX. ARCH AVG B.H.M.I. B.O. BIM BLDG. BM. C.J. CFMF CL CLG. CLR. COL. COLS. CONC. CONT. D.S. DIA. DR. DTL. OR DET. DWG. E.F.S. E.J. E.O.S. E.P. E.T.D. EA. ELEC. ELEV. ENG. EQ. EQUIP. EXIST. EXP. EXT. F.F. F.F.E. F.O. F.O.B. F.O.P. F.V. FDC FDN FIN. FLR. FRP FT. FTG. G.P. GA. GALV. GID GL H.P. HB HGT. OR HT. HKS HM HORIZ. HVAC I.D. I.e. I.F.S. IN. INSUL. INT.	AND AT ANCHOR BOLT ABOVE FLOOR SLAB ADJUSTABLE ABOVE FINISHED FLOOR ALUMINUM ANODIZED AMERICAN NATIONAL STANDARDS INSTITUTE APPROXIMATE OR APPROXIMATELY ARCHITECTURE, ARCHITECTURAL AVERAGE BUILDER'S HARDWARE MANUFACTURER'S ASSOCIATION, INC. BOTTOM OF BUILDING INFORMATION MODELING BUILDING BEAM CONTROL JOINT COLD FORMED METAL FRAMING CENTERLINE CEILING CLEAR COLUMN /COLUMNS COLUMNS CONCRETE CONTINUOUS DOWNSPOUT DIAMETER DOOR DETAIL DRAWING EXTERIOR FACE OF SHEATHING EXPANSION JOINT EDGE OF SLAB ELECTRICAL PANEL ESTIMATED TRAVEL DISTANCE EACH ELECTRIC, ELECTRICAL ELEVATION ENGINEER, ENGINEERING EQUAL EQUIPMENT EXISTING EXPANSION, EXPOSED EXTERIOR FINISHED FLOOR FINISHED FLOOR ELEVATION FACE OF FACE OF BRICK FACE OF POST FIELD VERIFY FIRE DEPARTMENT CONNECTION FOUNDATION FINISH, FINISHED FLOOR FIBER REINFORCED PANEL FEET FOOTING GLOSSY PAINT GAUGE GALVANIZED GATE INFORMATION DISPLAY GLASS HIGH POINT HOSE BIB HEIGHT HOOKS HOLLOW METAL HORIZONTAL HEATING VENTILATION & AIR CONDITIONING INSIDE DIAMETER THAT IS, SUCH AS INTERIOR FACE OF STUD INCH, INCHES INSULATION INTERIOR	JST. JT. LB. LDG. LONG. LT. LTG. MATL. MAX. MECH MEP MFR. MGR. MIN. MOD MSC. MTL MUFID N.I.C. N.T.S. N/A NFPA NO. O.C. O.D. OPG OPP. OSHA OVHD PDU PLYWD. PNL. PR. PRE-FAB PSF PSI PT R R.O. REF. REQD. REV. S.F. S.G.P. SC SCHED. SECT. SHT. SHTS. SIM. SPECS. SQ. SQ. IN. STD. STL. STOR. STRUCT SUSP. T&G T.O. STL T.O.B. T.O.S. T.O.SH T.O.W. TYP. U.L. U.O.N. VDC VERT. WI WCO WMP WWF YD. Ø	JOIST JOINT POUND LANDING LONGITUDINAL LIGHT LIGHTING MATERIAL MAXIMUM MECHANICAL MECHANICAL, ELECTRICAL, & PLUMBING MANUFACTURER MANAGER MINIMUM MODIFIED MISCELLANEOUS METAL MULTI-USER FLIGHT INFORMATION DISPLAY NOT IN CONTRACT NOT TO SCALE NOT APPLICABLE NATIONAL FIRE PROTECTION ASSOCIATION NUMBER ON CENTER OUTSIDE DIAMETER OPENING OPPOSITE OCCUPATIONAL SAFETY AND HEALTH ACT OVERHEAD POWER DISTRIBUTION UNIT PLYWOOD PANEL PAIR PRE-FABRICATED POUNDS PER SQUARE FOOT POUNDS PER SQUARE INCH PAINT, PRESSURE TREATED RADIUS ROUGH OPENING REINFORCING, REINFORCEMENT REQUIRED REVISED, REVISION SQUARE FEET SEMI-GLOSS PAINT SEALED CONCRETE SCHEDULE SECTION SHEET SHEETS SIMILAR SPECIFICATIONS SQUARE SQUARE INCHES STANDARD STEEL STORAGE STRUCTURAL, STRUCTURE SUSPENDED TONGUE & GROOVE TOP OF STEEL TOP OF BRICK, TOP OF BEAM TOP OF STEEL, TOP OF SLAB TOP OF SHEATHING TOP OF WALL TYPICAL UNDERWRITERS LABORATORIES UNLESS OTHERWISE NOTED VIRTUAL DESIGN & CONSTRUCTION VERTICAL WITH WALL CLEANOUT WIRE MESH PARTITION WELDED WIRE FABRIC YARD DIAMETER

GENERAL NOTES	
1. ALL DIMENSIONS ARE IN FEET / INCHES UNLESS NOTED OTHERWISE. 2. THESE GENERAL NOTES ARE NOT INTENDED TO REPLACE SPECIFICATIONS - REFER TO SPECIFICATIONS FOR REQUIREMENTS IN ADDITION TO GENERAL NOTES. 3. AREAS AND PERIMETERS ARE APPROXIMATE AND FOR REFERENCE ONLY. VERIFY QUANTITIES AND DIMENSIONS IN FIELD. 4. NO DEVIATIONS FROM THESE CONTRACT DOCUMENTS MUST BE MADE WITHOUT THE PRIOR WRITTEN APPROVAL OF THE ARCHITECT. 5. DO NOT SCALE DIMENSIONS FROM DRAWINGS - THE CONTRACTOR MUST REQUEST NECESSARY DIMENSIONS NOT SHOWN ON THE DRAWINGS FROM THE ARCHITECT. 6. ALL DIMENSIONS ORIGINATE FROM EXISTING FACE OF WALLS UNLESS NOTED OTHERWISE. 7. DETAILS SHOWN ON DRAWINGS ARE TYPICAL FOR ALL SIMILAR CONDITIONS. 8. DRAWING NOTES AND SPECIFICATIONS ARE INSTRUCTIONS TO THE CONTRACTOR AND APPLY TO ALL THE WORK UNLESS MORE SPECIFIC INFORMATION IS SHOWN ELSEWHERE ON THE DRAWINGS OR WRITTEN IN THE SPECIFICATIONS - IN THE EVENT OF CONFLICTING INSTRUCTIONS, THE ARCHITECT MUST DETERMINE WHAT CONTROLS THE CONTRACT DOCUMENTS ARE COMPLEMENTARY WHAT IS REQUIRED BY ONE MUST BE REQUIRED BY ALL. 9. STRUCTURAL DRAWINGS AND SPECIFICATIONS REPRESENT THE FINISHED STRUCTURE, AND, EXCEPT WHERE SPECIFICALLY SHOWN, DO NOT INDICATE THE METHOD OR MEANS OF CONSTRUCTION - THE CONTRACTOR MUST SUPERVISE CONSTRUCTION MEANS, METHODS, PROCEDURES, TECHNIQUES, SEQUENCE, AND APPLICABLE SAFETY REGULATIONS TO BE FOLLOWED. 10. CONTRACTOR MUST BE RESPONSIBLE FOR SCHEDULING AND COORDINATING THE WORK OF THE SUB-CONTRACTORS - THE CONTRACTOR MUST BE RESPONSIBLE TO COORDINATE WITH THE BUILDING OWNER, TENANT OR HIS REPRESENTATIVES THE DELIVERY AND INSTALLATION OF ITEMS BEING PROVIDED AND INSTALLED BY OTHERS. 11. PLUMBING AND ELECTRICAL WORK RELATED TO DEMOLITION AND NEW INSTALLATION OF COMPONENTS MUST COMPLY WITH ALL APPLICABLE CODES. 12. ALL MATERIALS, FABRICATION AND INSTALLATION MUST COMPLY WITH THE APPLICABLE REQUIREMENTS AND SPECIFICATIONS FOR EACH DIVISION OF WORK. 13. CONSTRUCTION MUST COMPLY WITH APPLICABLE CODES AND ORDINANCES, LAWS AND SAFETY ORDERS AS DIRECTED BY LOCAL JURISDICTION. 14. CONTRACTOR MUST BE RESPONSIBLE FOR THE TIMELY ORDERING OF MATERIALS INCLUDED IN THESE CONTRACT DOCUMENTS - SOME ITEMS IN THESE DOCUMENTS MAY REQUIRE LONG LEAD TIMES OR SPECIAL COORDINATION. SUBSTITUTIONS WILL NOT BE ALLOWED FOR MATERIAL NOT ORDERED IN A TIMELY FASHION. 15. CONTRACTOR MUST CHECK AND VERIFY ALL DIMENSIONS AND EXISTING CONDITIONS, (BOTH NEW AND EXISTING) REPORTING ANY DISCREPANCIES TO THE ARCHITECT PRIOR TO ORDERING MATERIALS OR PROCEEDING WITH ANY PHASE OF THE WORK. 16. CONTRACTOR MUST CHECK AND VERIFY ALL DIMENSIONS PRIOR TO COMMENCING CONSTRUCTION - ALL DISCREPANCIES MUST BE NOTED AND SENT TO THE ARCHITECT WITH ADEQUATE TIME TO REVIEW PRIOR TO STARTING THAT PORTION OF THE WORK IN ORDER TO AVOID PROJECT DELAYS. 17. CONTRACTOR MUST CLEAN, PATCH AND REPAIR ALL SURFACES DAMAGED BY DEMOLITION, ALTERATION OR INSTALLATION OF THE WORK. 18. ALL REQUESTS FROM INFORMATION PROMPTED BY THE BUILDING OFFICIALS MUST INCLUDE A COPY OF THE BUILDING OFFICIALS' COMMENTS AND THE BUILDING INSPECTORS FIELD REPORT TO ENSURE AN ACCURATE AND TIMELY RESPONSE. 19. CONTRACTOR AND SUBCONTRACTOR MUST ALL BE LICENSED TO PERFORM THEIR REQUESTED DUTIES AS REQUIRED IN ACCORDANCE WITH LOCAL STANDARDS. 20. CONTRACTOR MUST COMPARE STRUCTURAL SECTIONS WITH ARCHITECTURAL SECTIONS AND REPORT ANY DISCREPANCY TO THE ARCHITECT PRIOR TO FABRICATION OR INSTALLATION OF STRUCTURAL MEMBERS. 21. ALL EXISTING EQUIPMENT AND FINISHES THAT ARE SCHEDULED OR NOTED TO REMAIN WILL BE PROTECTED BY THE CONTRACTOR. PHOTOGRAPHS OF EXISTING CONDITIONS MUST BE PROVIDED BY THE CONTRACTOR TO DOCUMENT PRE-EXISTING DAMAGE & FINISH CONDITIONS. 22. THE CONTRACTOR MUST COORDINATE ALL DEMO AND NEW WORK ACTIVITIES WITH THE AUTHORITY PRIOR TO PROCEEDING. 23. THE CONTRACTOR IS TO PROTECT EXISTING FINISHES, AND MAKE REPAIRS TO THE EXISTING FINISHES, AS PART OF THE NEW WORK ASSOCIATED WITH THIS PROJECT. 24. ALL NON-GALVANIZED EXTERIOR EXPOSED STEEL TO RECEIVE HIGH PERFORMANCE COATING. 25. DO NOT OBSTRUCT ACCESS TO EXISTING EXITS, OR REDUCE THE WIDTH OF PUBLIC CORRIDORS. 26. FINISH FLOOR ELEVATIONS ARE TO TOP OF CONCRETE UNLESS OTHERWISE NOTED.	

PLAN SYMBOLS		
VIEW TITLE		LEVEL HEAD
XX View Name SCALE:1/8" = 1'-0"		Name Elevation
BUILDING SECTION		DETAIL SECTION
A1 A101 SIM A1 A101 SIM		A1 A101 SIM
ELEVATION - EXTERIOR		ELEVATION - INTERIOR
1 A-101		0 A-101 0 0
WALL SECTION		CALLOUT HEAD & REGION
A1 A101 SIM		A1 A101 SIM
NORTH ARROW		VIEW REFERENCE
PN N		
DOOR TAG		REVISION TAG
XXX		1
		KEYNOTE
		0

RS&H

10748 Deerwood Park Blvd. South Jacksonville, Florida 32256-0597 904-256-2500 Fax 904-256-2503 www.rsandh.com FL Cert. Nos. AAC001886 * 1B26000956 * 5620 * LCC000210 * GB238

JAXPORT

JACKSONVILLE PORT AUTHORITY

PROJECT TITLE:

JAXPORT CRUISE TERMINAL GANGWAY MODIFICATION

PROJECT ADDRESS:

9810 AUGUST DRIVE JACKSONVILLE, FL 32226

REVISIONS

NO.	DESCRIPTION	DATE

DATE ISSUED:

01/24/2025

REVIEWED BY:

SDP

DRAWN BY:

ALH

DESIGNED BY:

CMV

PROJECT NUMBER:

10014153000

SEAL:

PATRICK MULL

LICENSE

No 73265

STATE OF FLORIDA

PROFESSIONAL ENGINEER

SHEET TITLE:


GENERAL NOTES, ABBREVIATIONS, AND SYMBOLS

SHEET ID:

G002

PROJECT STATUS:

100% SUBMITTAL FOR CONSTRUCTION

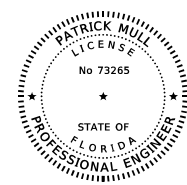

THIS ITEM HAS BEEN DIGITALLY
SIGNED AND SEALED BY

ON THE DATE ADJACENT TO THE SEAL

PRINTED COPIES OF THIS DOCUMENT ARE
NOT CONSIDERED SIGNED AND SEALED
AND THE SIGNATURE MUST BE VERIFIED
ON ANY ELECTRONIC COPIES.

RS&H, INC.
10748 DEERWOOD PARK BLVD. SOUTH
JACKSONVILLE, FLORIDA 32256
PATRICK MULL, P.E. NO. 73265

SHEET NUMBER	SHEET NAME
G001	KEY SHEET AND SHEET INDEX
G002	GENERAL NOTES, ABBREVIATIONS, AND SYMBOLS
G003	SIGNATURE SHEET
S012	STRUCTURAL GENERAL NOTES
S013	STRUCTURAL ISOMETRICS
S101	FOUNDATION PLAN
S104	RAMP FRAMING PLAN - UPPER
S205	FRAMING ELEVATIONS
S301	STRUCTURAL SECTIONS - I
S302	STRUCTURAL SECTIONS - II
S401	ENLARGED LANDING PLANS
S501	FOUNDATION SECTIONS & DETAILS
S502	FRAMING SECTIONS & DETAILS - I
S503	FRAMING SECTIONS & DETAILS - II




THIS ITEM HAS BEEN DIGITALLY
SIGNED AND SEALED BY

ON THE DATE ADJACENT TO THE SEAL

PRINTED COPIES OF THIS DOCUMENT ARE
NOT CONSIDERED SIGNED AND SEALED
AND THE SIGNATURE MUST BE VERIFIED
ON ANY ELECTRONIC COPIES.

RS&H, INC.
1715 N. WESTSHORE BLVD., SUITE 600
TAMPA, FLORIDA 33607
CAROLINA M. VALLADARES, R.A. NO. 102352

SHEET NUMBER	SHEET NAME
G003	SIGNATURE SHEET
A121	ROOF PLAN
A201	ELEVATIONS

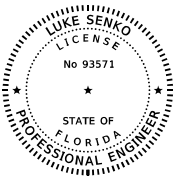

THIS ITEM HAS BEEN DIGITALLY
SIGNED AND SEALED BY

ON THE DATE ADJACENT TO THE SEAL

PRINTED COPIES OF THIS DOCUMENT ARE
NOT CONSIDERED SIGNED AND SEALED
AND THE SIGNATURE MUST BE VERIFIED
ON ANY ELECTRONIC COPIES.

RS&H, INC.
1715 N. WESTSHORE BLVD., SUITE 600
TAMPA, FLORIDA 33607
LUKE SENKO, P.E. NO. 93571

SHEET NUMBER	SHEET NAME
G003	SIGNATURE SHEET
E001	ELECTRICAL GENERAL NOTES, SYMBOLS AND ABBREVIATIONS
E002	ELECTRICAL SPECIFICATIONS
E003	ELECTRICAL SPECIFICATIONS
ES101	ELECTRICAL SITE PLAN
E601	ELECTRICAL PANEL SCHEDULES
E701	ELECTRICAL ONE LINE DIAGRAM
E901	ELECTRICAL ISOMETRICS

RS&H

10748 Deerwood Park Blvd. South
Jacksonville, Florida 32256-0597
904-266-2500 Fax 904-266-2503
www.rsandh.com
FL Cert. Nos. AAC001886 * IB26000956 *
5620 * LCC000210 * GB238



PROJECT TITLE:
JAXPORT CRUISE TERMINAL
GANGWAY MODIFICATION

PROJECT ADDRESS:
9810 AUGUST DRIVE
JACKSONVILLE, FL 32226

REVISIONS		
NO.	DESCRIPTION	DATE


DATE ISSUED: 01/24/2025

REVIEWED BY: VV

DRAWN BY: AC

DESIGNED BY: AC

PROJECT NUMBER:
10014153000

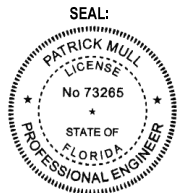

SHEET TITLE:
SIGNATURE SHEET

SHEET ID:

G003

PROJECT STATUS:
100% SUBMITTAL
FOR CONSTRUCTION

SYMBOLS & ABBREVIATIONS

AB	ANCHOR BOLT	IAW	IN ACCORDANCE WITH
ADJ	ADJACENT	IF	INSIDE FACE
ADF	ABOVE FINISH FLOOR	INT	INTERIOR
B/	BOTTOM OF	JT	JOINT
BC	BOTTOM CHORD		
BLDG	BUILDING	KSI	KIPS PER SQUARE INCH
BM	BEAM		
BOTT	BOTTOM	LLH	LONG LEG HORIZONTAL
BRG	BEARING	LLV	LONG LEG VERTICAL
BTW	BETWEEN	LOC	LOCATION
		LSV	LONG SIDE VERTICAL
CCJ	CONTRACTION CONTROL JOINT	M	MECHANICAL
CFMF	COLD FORMED METAL FRAMING	MAX	MAXIMUM
CL	CENTER LINE	MC	MOMENT CONNECTION
CLR	CLEAR	MFR	MANUFACTURER
CMU	CONCRETE MASONRY UNIT	MIN	MINIMUM
COL	COLUMN	MSL	MEAN SEA LEVEL
CONC	CONCRETE		
CONT	CONTINUOUS	OAE	OR APPROVED EQUAL
		OC	ON CENTER
D	DEEP	OF	OUTSIDE FACE
DET	DETAIL	OH	OPPOSITE HAND
DIA	DIAMETER		
E	ELECTRICAL	PAF	POWDER ACTUATED FASTENER
EA	EACH	PL	PLATE
ECC	ECCENTRIC	PSF	POUNDS PER SQUARE FOOT
EJ	EXPANSION JOINT	PSI	POUNDS PER SQUARE INCH
EL	ELEVATION		
EMBED	EMBEDMENT	R	RADIUS
EOD	EDGE OF DECK	REINF	REINFORCEMENT
EP	EMBEDDED PLATE		
EPS	EXPANSIVE POLYSTYRENE GEOFOAM	SIM	SIMILAR
EQ	EQUAL	SLV	SHORT LEG VERTICAL
EQUIP	EQUIPMENT	STD	STANDARD
EX	EXISTING	STL	STEEL
EXIST	EXISTING		
EXP	EXPANSION	T&B	TOP AND BOTTOM
EXT	EXTERIOR	TI	TOP OF THICK
		TRANS	TRANSVERSE
FDN	FOUNDATION	TYP	TYPICAL
FTG	FOOTING		
FV	FIELD VERIFY	UNO	UNLESS NOTED OTHERWISE
		VERT	VERTICAL
GALV	GALVANIZED		
GR	GRADE	W	WIDE
		WI	WITH
HDS	HOT DIPPED GALVANIZED	WF	WIDE FLANGE
HORIZ	HORIZONTAL	WP	WORK POINT
HSA	HEADED STUD ANCHOR		
HSS	HOLLOW STEEL SECTION		
HT	HEIGHT		

STRUCTURAL STEEL:

- STRUCTURAL STEEL MUST BE DESIGNED PER AISC 360-16.
WIDE FLANGE SHAPES _____ ASTM A992
HSS RECTANGULAR _____ ASTM A500, GR C, F_y = 50 KSI
HSS ROUND _____ ASTM A500, GR C, F_y = 46 KSI
STEEL PIPES _____ ASTM A53, GRADE B, TYPE S
CHANNELS _____ ASTM A992, GRADE 50
PLATES _____ ASTM A572, GRADE 50
ANGLES _____ ASTM A572, GRADE 50
BOLTS _____ ASTM A325 (3/4"Ø UON)
ANCHOR RODS _____ ASTM F1554 (GRADE 36 UON)
ALL OTHER STEEL _____ ASTM A36
- WELDING MUST UTILIZE E70XX ELECTRODES CONFORMING TO ANSI/AWS D1.1.
- MINIMUM SIZE OF ALL FILLET WELDS MUST CONFORM TO TABLE J2.4 OF AISC SPECIFICATIONS EVEN IF SHOWN OTHERWISE ON ARCHITECTURAL AND STRUCTURAL DRAWINGS.
- FABRICATOR MUST SUBMIT SHOP DRAWINGS TO STRUCTURAL ENGINEER FOR REVIEW PRIOR TO START OF FABRICATION. FABRICATION MUST CONFORM TO AISC SPECIFICATIONS.
- ALL STRUCTURAL STEEL MUST BE FIELD PAINTED PER THE SPECIFICATIONS.

BENCHMARKS (EXISTING MONUMENTS):

ID	NUMBER	NORTHING	EASTING	DESCRIPTION
GTBM3	BM1	N=2209048.31	E=472651.84	DRILL HOLE X CUT IN CONCRETE BULKHEAD
GA8	BM2	N=2208911.35	E=472834.77	NAIL IN PAVEMENT

REFER TO S101 FOR CONTROL ELEVATION

DEFERRED SUBMITTALS:

- DEFERRED SUBMITTALS CONSTITUTE ENGINEERING DOCUMENTS DELEGATED IN WRITING BY THE ENGINEER OF RECORD TO A DELEGATED ENGINEER IAW FBC 107.3.4.
- DEFERRED SUBMITTALS:
A. ALUMINUM GANGWAY W/ FABRIC AWNING
B. ALUMINUM COMPOSITE ROOF CANOPIES
C. GUARDRAIL INFILL PANELS
D. HOIST AND MONORAIL SYSTEM
- SUBMITTAL DOCUMENTS FOR DEFERRED SUBMITTALS MUST BE SUBMITTED TO THE ENGINEER OF RECORD WHO MUST REVIEW AND FORWARD THEM TO THE OWNER WITH A NOTATION INDICATING THAT THE DEFERRED SUBMITTAL DOCUMENTS HAVE BEEN REVIEWED AND THAT THEY HAVE BEEN FOUND TO BE IN GENERAL CONFORMANCE WITH THE DESIGN OF THE BUILDING
A. SUBMITTAL DOCUMENTS MUST BE IN ACCORDANCE WITH THE SPECIFICATIONS AND PLANS.
B. SUBMITTAL DOCUMENTS MUST INCLUDE LAYOUTS, SECTIONS, DETAILS, CALCULATIONS, PRODUCT DATA, CERTIFICATES, AND OTHER RELATED DATA. DOCUMENTS MUST BE SIGNED AND SEALED BY A REGISTERED PROFESSIONAL ENGINEER IN THE STATE OF FLORIDA.
C. SUBMITTAL DOCUMENTS FOR DEFERRED SUBMITTALS FOUND NOT TO BE IN CONFORMANCE WITH THE DESIGN DOCUMENTS WILL BE RETURNED FOR CORRECTION OR REJECTED.
- THE DEFERRED SUBMITTAL ITEMS MUST NOT BE FABRICATED OR INTALLED UNTIL THEIR DESIGN AND SUBMITTAL DOCUMENTS HAVE BEEN APPROVED BY THE OWNER.

FOUNDATIONS:

- FOUNDATIONS ON THE RELIEVING PLATFORM ARE DESIGNED FOR A MAXIMUM ALLOWABLE BEARING PRESSURE = 1,500 PSF, SEE S101.

CONCRETE:

- ALL CONCRETE MUST BE DESIGNED PER ACI 318-19.
- ALL CONCRETE MIXES MUST BE DESIGNED BY AN APPROVED LABORATORY, AND THE DESIGN MIX MUST SUBMITTED TO THE ARCHITECT/ENGINEER FOR REVIEW, AND OBTAIN APPROVAL PRIOR TO USE.

LOCATION	STRENGTH @ 28 DAYS
NORMAL WEIGHT CONCRETE	4500 PSI
ALL CONCRETE	
- NO PIPES OR DUCTS MUST BE PLACED IN STRUCTURAL CONCRETE UNLESS SPECIFICALLY DETAILED. SEE ARCHITECTURAL AND MECHANICAL DRAWINGS FOR LOCATION OF SLEEVES. MOULDS, FLOOR HINGES, ETC. TO BE CAST INTO THE CONCRETE.

REINFORCING STEEL:

- REINFORCING STEEL MUST BE DEFORMED BARS CONFORMING TO ASTM SPECIFICATION A615 GRADE 60. ALL MESH REINFORCING MUST CONFORM TO ASTM SPECIFICATION A1064.
- SPLICES IN REINFORCING, WHERE PERMITTED, MUST BE CLASS B TENSION LAP SPLICES, UNO.
- MINIMUM LAP OF MESH REINFORCING MUST BE ONE FULL MESH PLUS 2" OR 6", WHICHEVER IS GREATER.
- UNLESS OTHERWISE SHOWN ON DRAWINGS, MINIMUM COVER FOR REINFORCING MUST BE AS FOLLOWS:

FOOTINGS	3"
SLABS ON GRADE	TOP THIRD
- ALL REINFORCING MUST BE HELD SECURELY IN POSITION WITH STANDARD ACCESSORIES IN CONFORMANCE WITH CRSI MANUAL OF STANDARD PRACTICE AND ACI 531 DURING THE PLACING OF CONCRETE.
- PROVIDE CORNER REINFORCING TO MATCH HORIZONTAL REINFORCING AT ALL CORNERS OF CONTINUOUS FOOTINGS AND TIE BEAMS.
- ALL HOOKS IN REINFORCING BARS MUST BE AN ACI STANDARD HOOK, UNLESS NOTED OTHERWISE.
- REINFORCING BARS CONFORMING TO ASTM A706 MUST BE USED FOR BARS REQUIRING WELDING.

GANGWAY NOTES:

- GANGWAY MUST BE DESIGNED IN ACCORDANCE WITH THE 2023 FLORIDA BUILDING CODE.
- GANGWAY MUST BE DESIGNED FOR A UNIFORM LIVE LOAD OF 100 PSF.
- GANGWAY MUST BE PROVIDED WITH LIFTING LUGS.
- GANGWAY MUST BE FABRICATED FROM 6061-T6 ALUMINUM MATERIAL.
- BREAK ALL EDGES ABOVE DECK LEVEL.
- HANDRAIL, GUARDS AND INFILL MUST COMPLY WITH THE 2023 FLORIDA BUILDING CODE – ACCESSIBILITY.
- PIPE RAIL MUST HAVE A BRUSH FINISH AFTER FABRICATION.
- ATTACHED CANOPY SHADE FABRIC MATERIAL MUST MATCH EXISTING AND MUST HAVE A 10 YEAR WARRANTY AGAINST FADING, ROT, UV DETERIORATION, LOSS OF STRENGTH, COLOR CHANGE OR FAULTY WORKMANSHIP.
- SUBMIT SHOP DRAWINGS FOR APPROVAL PRIOR TO FABRICATION. SHOP DRAWINGS MUST BE SIGNED AND SEALED BY A PROFESSIONAL ENGINEER REGISTERED IN THE STATE OF FLORIDA.
- BASIS OF DESIGN: BELLINGHAM MARINE INDUSTRIES, INC.

GUARDRAIL INFILL NOTES:

- ALL INFILL PANELS MUST BE 6 MM ALUCOBOND PE. PANELS EXCEPT WHERE OTHERWISE NOTED ON THE PLANS. PANELS MARKED WITH AN  MUST BE 6 MM LEXAN XL102UV SHEETS.
COLORS MUST BE SELECTED BY JAXPORT TO MATCH EXISTING. SUBMIT SAMPLES.
- SHEET PRODUCTS MUST BE SAWN AND CUT ACCURATELY USING STANDARD WORKSHOP EQUIPMENT, HOWEVER, MANUFACTURER'S WRITTEN GUIDELINES MUST BE FOLLOWED.
- ALL PANEL BUTT JOINTS MUST BE VERTICAL. NO HORIZONTAL OR SLANTED JOINTS ARE PERMITTED.
- PANELS MUST BE FASTENED TO ALL HORIZONTAL RAILS WITH MIN #8 SS SELF TAPPING, SELF DRILLING SCREWS WITH BONDED WASHERS AT 12" O.C. HOLES IN THE PANELS MUST BE 2 TIMES THE SCREW SIZE AND MUST BE DRILLED WITH STANDARD HIGH SPEED DRILLS IN ACCORDANCE WITH MANUFACTURER'S INSTRUCTIONS. HEAT GENERATION MUST BE KEPT TO AN ABSOLUTE MINIMUM.
- PANELS MUST BE INSTALLED BY A SUBCONTRACTOR WHO HAS SUCCESSFULLY COMPLETED AT LEAST 3 PROJECTS OF SIMILAR SIZE AND SCOPE TO THIS PROJECT.
- ALL EXPOSED PANEL EDGES MUST BE BEVELED OR ROUNDED TO ELIMINATE SHARP EDGES.
- SUBMIT SHOP DRAWINGS SHOWING PROJECT LAYOUT AND ELEVATIONS, FASTENING AND ANCHORING METHODS, DETAIL AND LOCATION OF JOINTS, SEALANTS AND GASKETS, INCLUDING JOINTS NECESSARY TO ACCOMMODATE THERMAL MOVEMENT.
A. BASIS OF DESIGN:
ALUCOBOND: PIEDMONT PLASTICS
2175 MASON AVE, DAYTONA BEACH, FL 32117
(800) 874-7512
CONTACT: DALE SHELTON, TERRITORY MANAGER
(904) 472-8015

LEXAN: SABIC
PITTSFIELD, MA
CONTACT: MICHAEL CORUZZI
(856) 904-3581
MICHAEL.CORUZZI@SABIC.COM

DESIGN CRITERIA:

DESIGN PER THE 2023 FLORIDA BUILDING CODE, 8TH EDITION.

- DEAD LOADS
SELF-WEIGHT OF CONSTRUCTION MATERIALS
- LIVE LOADS (PER ASCE 7-22):
WALKWAYS AND RAMPS _____ 100 PSF
ROOF (CANOPIES) _____ 20 PSF
- WIND LOADS (PER ASCE 7-22):
ULTIMATE DESIGN WIND SPEED, V_{ult} _____ 126 MPH
NOMINAL DESIGN WIND SPEED, V_{ref} _____ 98 MPH
RISK CATEGORY _____ II
WIND EXPOSURE CATEGORY _____ D
INTERNAL PRESSURE COEFFICIENT _____ ± 0.0
COMPONENTS AND CLADDING WIND PRESSURES _____ SEE DETAILS 1/S001
- RAIN LOADS:
100 YR MRI RAIN INTENSITY, 60-MIN DURATION _____ i = 4.50 IN/HR
- FLOOD LOADS:
PROJECT LOCATION IS NOT IN A FLOOD ZONE.

GENERAL:


- THE STRUCTURAL NOTES MUST GOVERN IN MATTERS COVERED ON THE STRUCTURAL DRAWINGS. SEE PROJECT SPECIFICATION AND OTHER DRAWINGS FOR FURTHER REQUIREMENTS. TOTAL PROJECT DEFINITION WILL BE PROVIDED BY COMBINING PROJECT SPECIFICATIONS AND STRUCTURAL DRAWING PACKAGES.
- THE DRAWINGS REPRESENT THE FINISHED STRUCTURE, UNLESS OTHERWISE INDICATED. THEY DO NOT REPRESENT THE METHOD OF CONSTRUCTION.
- THE CONTRACTOR MUST TAKE ALL MEASURES NECESSARY TO PROTECT THE STRUCTURE AND ANY PERSONNEL DURING CONSTRUCTION. SUCH MEASURES SHOULD INCLUDE, BUT NOT BE LIMITED TO TEMPORARY BRACING AND SHORING OF DEAD LOADS, CONSTRUCTION LOADS, WIND LOADS, ETC.
- FOR TYPICAL DETAILS SHOWN BUT NOT BE REFERRED TO EXCEPT HEREIN, CONFORM TO ALL OF THE REQUIREMENTS OF THESE DETAILS TO THE SAME EXTENT AS IF REFERRED TO BY DETAIL NUMBER.
- IF FOOTING ELEVATIONS SHOWN OCCUR IN A DISTURBED, UNSTABLE OR UNSUITABLE SOIL THE ENGINEER MUST BE NOTIFIED.
- CONTRACTOR MUST VERIFY ALL EXISTING CONDITIONS OF EXISTING SITE THAT ARE AFFECTED BY NEW WORK BEFORE PROCEEDING WITH FABRICATION AND CONSTRUCTION.

EXISTING CONDITIONS:

- THE EXISTING CONSTRUCTION SHOWN ON THE DRAWINGS WAS OBTAINED FROM EXISTING DRAWINGS BY W.A. GRISWOLD, JR, PE, DATED 8/29/03. THE CONTRACTOR MUST VERIFY ALL EXISTING CONDITIONS PRIOR TO PROCEEDING WITH WORK. CONTRACTOR MUST NOTIFY ARCHITECT / ENGINEER OF ALL EXCEPTIONS TO ASSUMED CONDITIONS.
- ALL REMOVAL, CUTTING, DRILLING, ETC. OF EXISTING CONSTRUCTION MUST BE PERFORMED WITH GREAT CARE IN ORDER TO NOT DAMAGE THE EXISTING AND JEOPARDIZE THE INTEGRITY OF THE EXISTING BUILDING TO REMAIN.


METAL FLOOR DECK NOTES:

- ALL STEEL FLOOR DECK MUST BE IN CONFORMANCE WITH THE LATEST EDITION OF THE STEEL DECK INSTITUTE (SDI).
- ALL STEEL FLOOR DECK MUST BE GALVANIZED G-120.
- FLOOR DECK MUST BE COMPOSITE DECK EQUAL TO NEW MILLENNIUM TYPE 1.5CD, 18 Ga THICKNESS, WITH MINIMUM YEILD STRENGTH OF 40 ksi.
A. FLOOR DECK MINIMUM PROPERTIES: I_p = 0.279 in⁴/ft, I_n = 0.281 in³/ft, S_p = 0.304 in³/ft, S_n = 0.315 in³/ft.
- FLOOR SLAB MUST HAVE AN OVERALL NOMINAL THICKNESS OF 3 1/2" FROM TOP OF CONCRETE TO BOTTOM OF METAL DECK, UNO. REINFORCE W/ 6X6-W1.4 X W1.4.
- REINFORCING FOR SLAB MUST BE 3/4" BELOW TOP OF SLAB.
- ALL FLOOR DECK MUST BE FASTENED TO STEEL SUPPORTS AT ENDS OF SHEET AND INTERMEDIATE SUPPORTS. MIN BEARING LENGTH = 1 1/2." SUPPORT FASTENERS MUST BE 5/8" DIA PUDDLE WELD, WITH SPACING OF MAX 12" OC.
- DECKING MUST HAVE NESTED OR INTERLOCKING SIDE LAPS. SIDE LAPS MUST BE FASTENED WITH #10 DRILL SCREWS AT MAX 36" OC.
- ALL DECKS MUST ARE DESIGNED FOR SINGLE SPANS. TWO OR MORE SPANS MAY BE USED WHERE GEOMETRY ALLOWS.

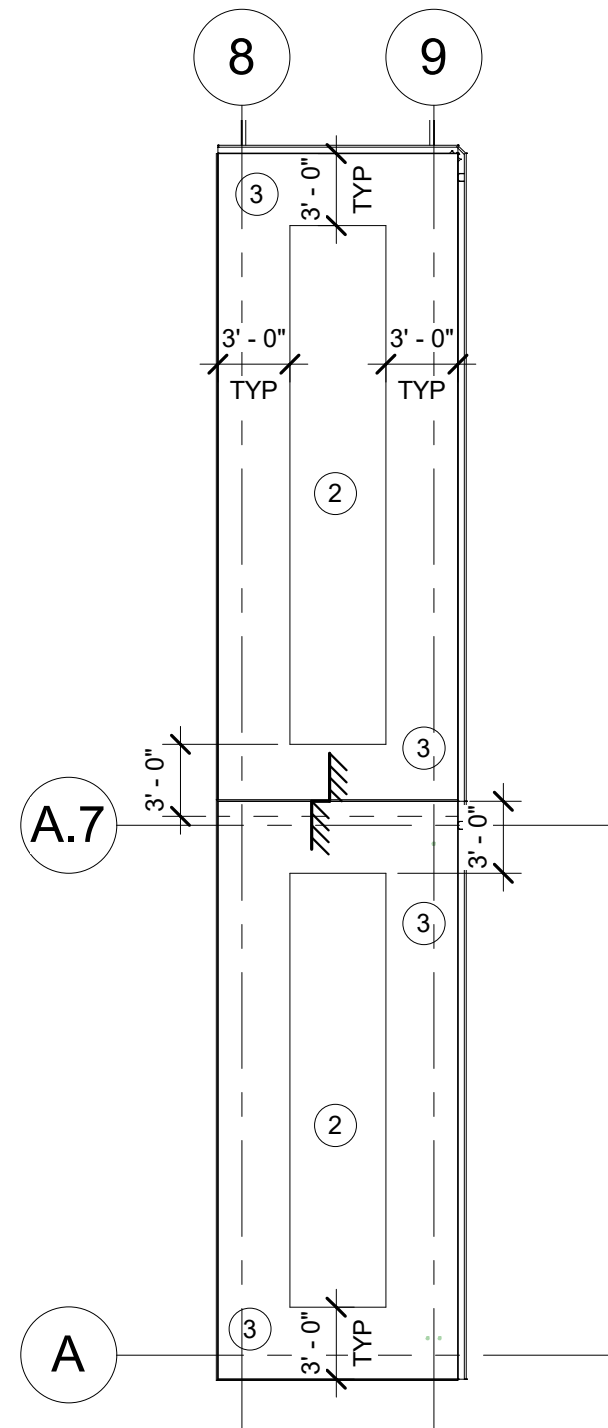

CANOPY ROOF C&C PLAN

SCALE: 1/8" = 1'-0"

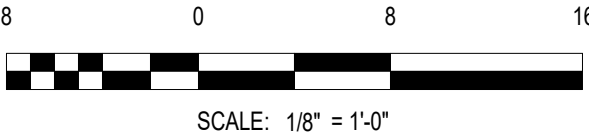

10748 Deerwood Park Blvd. South
Jacksonville, Florida 32256-0597
904-256-2500 Fax 904-256-2503
www.rsandh.com
FL Cert. Nos. AAC001886 * IB26000956 *
5620 * LCC000210 * GB238



PROJECT TITLE:
JAXPORT CRUISE TERMINAL
GANGWAY MODIFICATION

PROJECT ADDRESS:
9810 AUGUST DRIVE
JACKSONVILLE, FL 32226

REVISIONS

NO.	DESCRIPTION	DATE


DATE ISSUED: 01/24/2025

REVIEWED BY: PFM

DRAWN BY: JAM

DESIGNED BY: LAP

PROJECT NUMBER:
10014153000


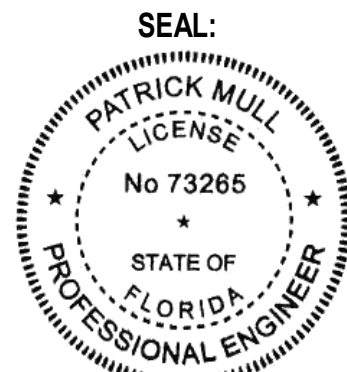


SHEET TITLE:
STRUCTURAL
GENERAL NOTES


SHEET ID:

S012

PROJECT STATUS:
100% SUBMITTAL
FOR CONSTRUCTION

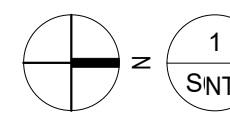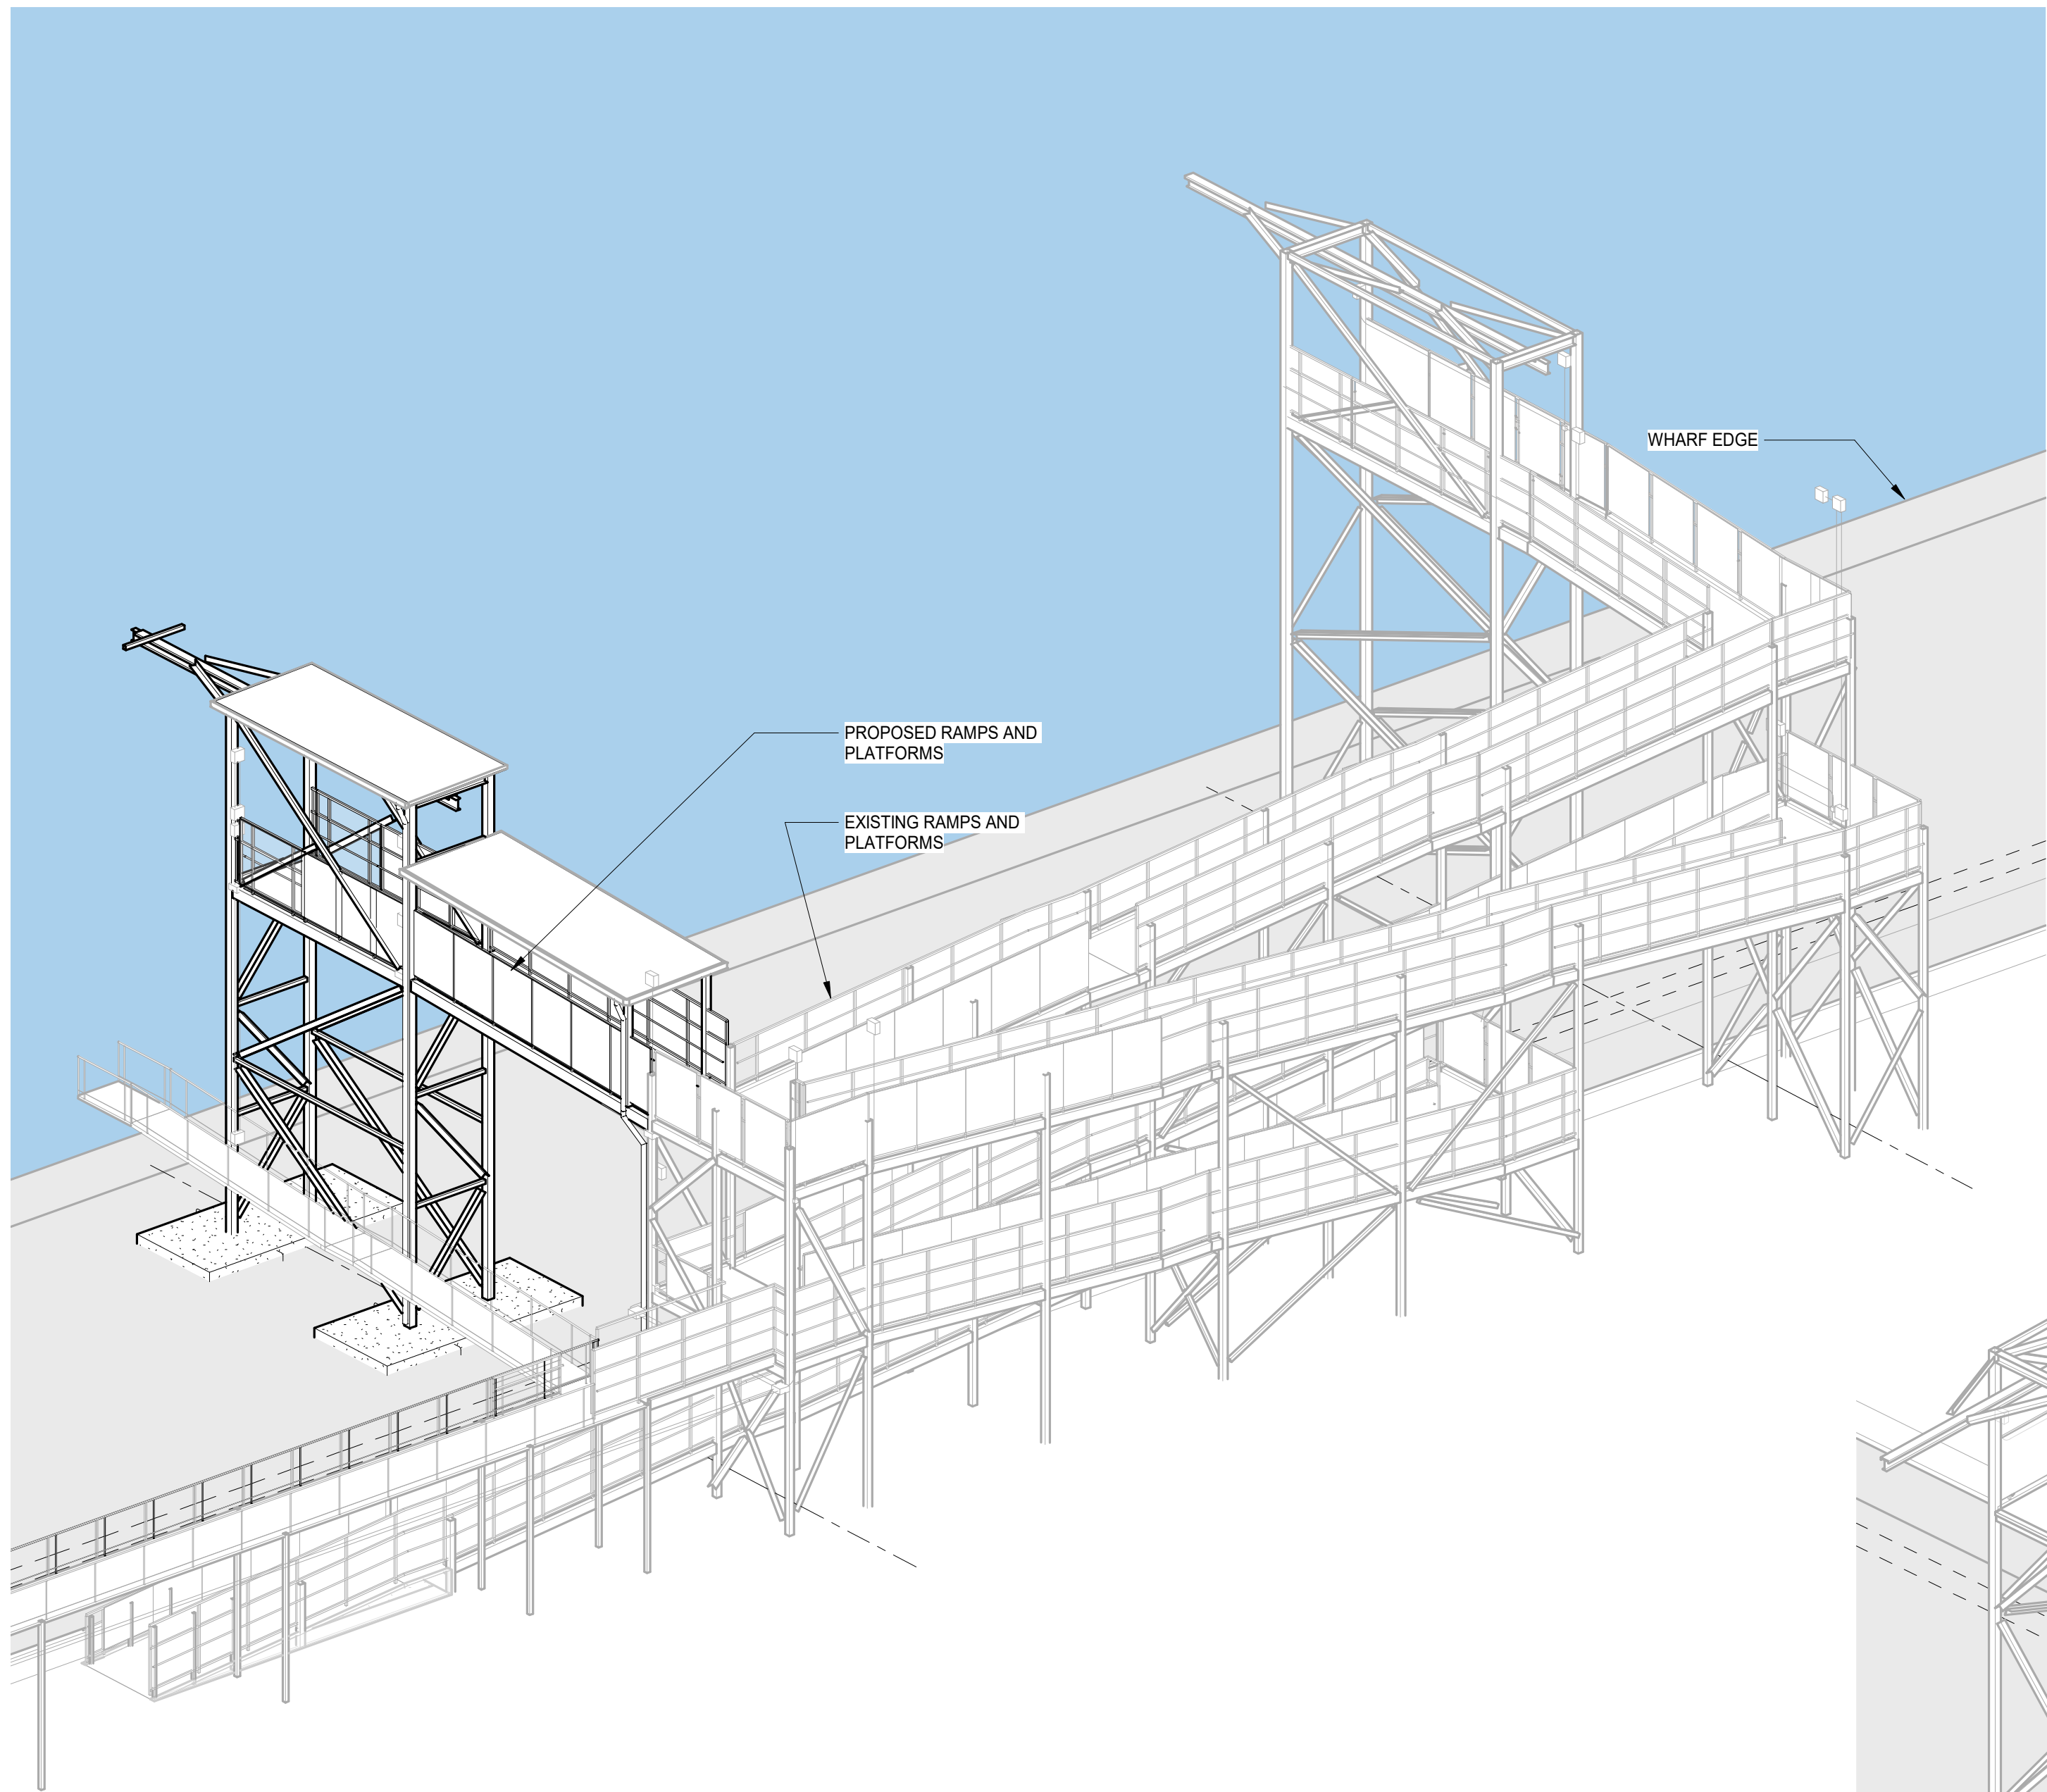

3D PERSPECTIVE - BUILDING SIDE
1
SNTS SCALE:

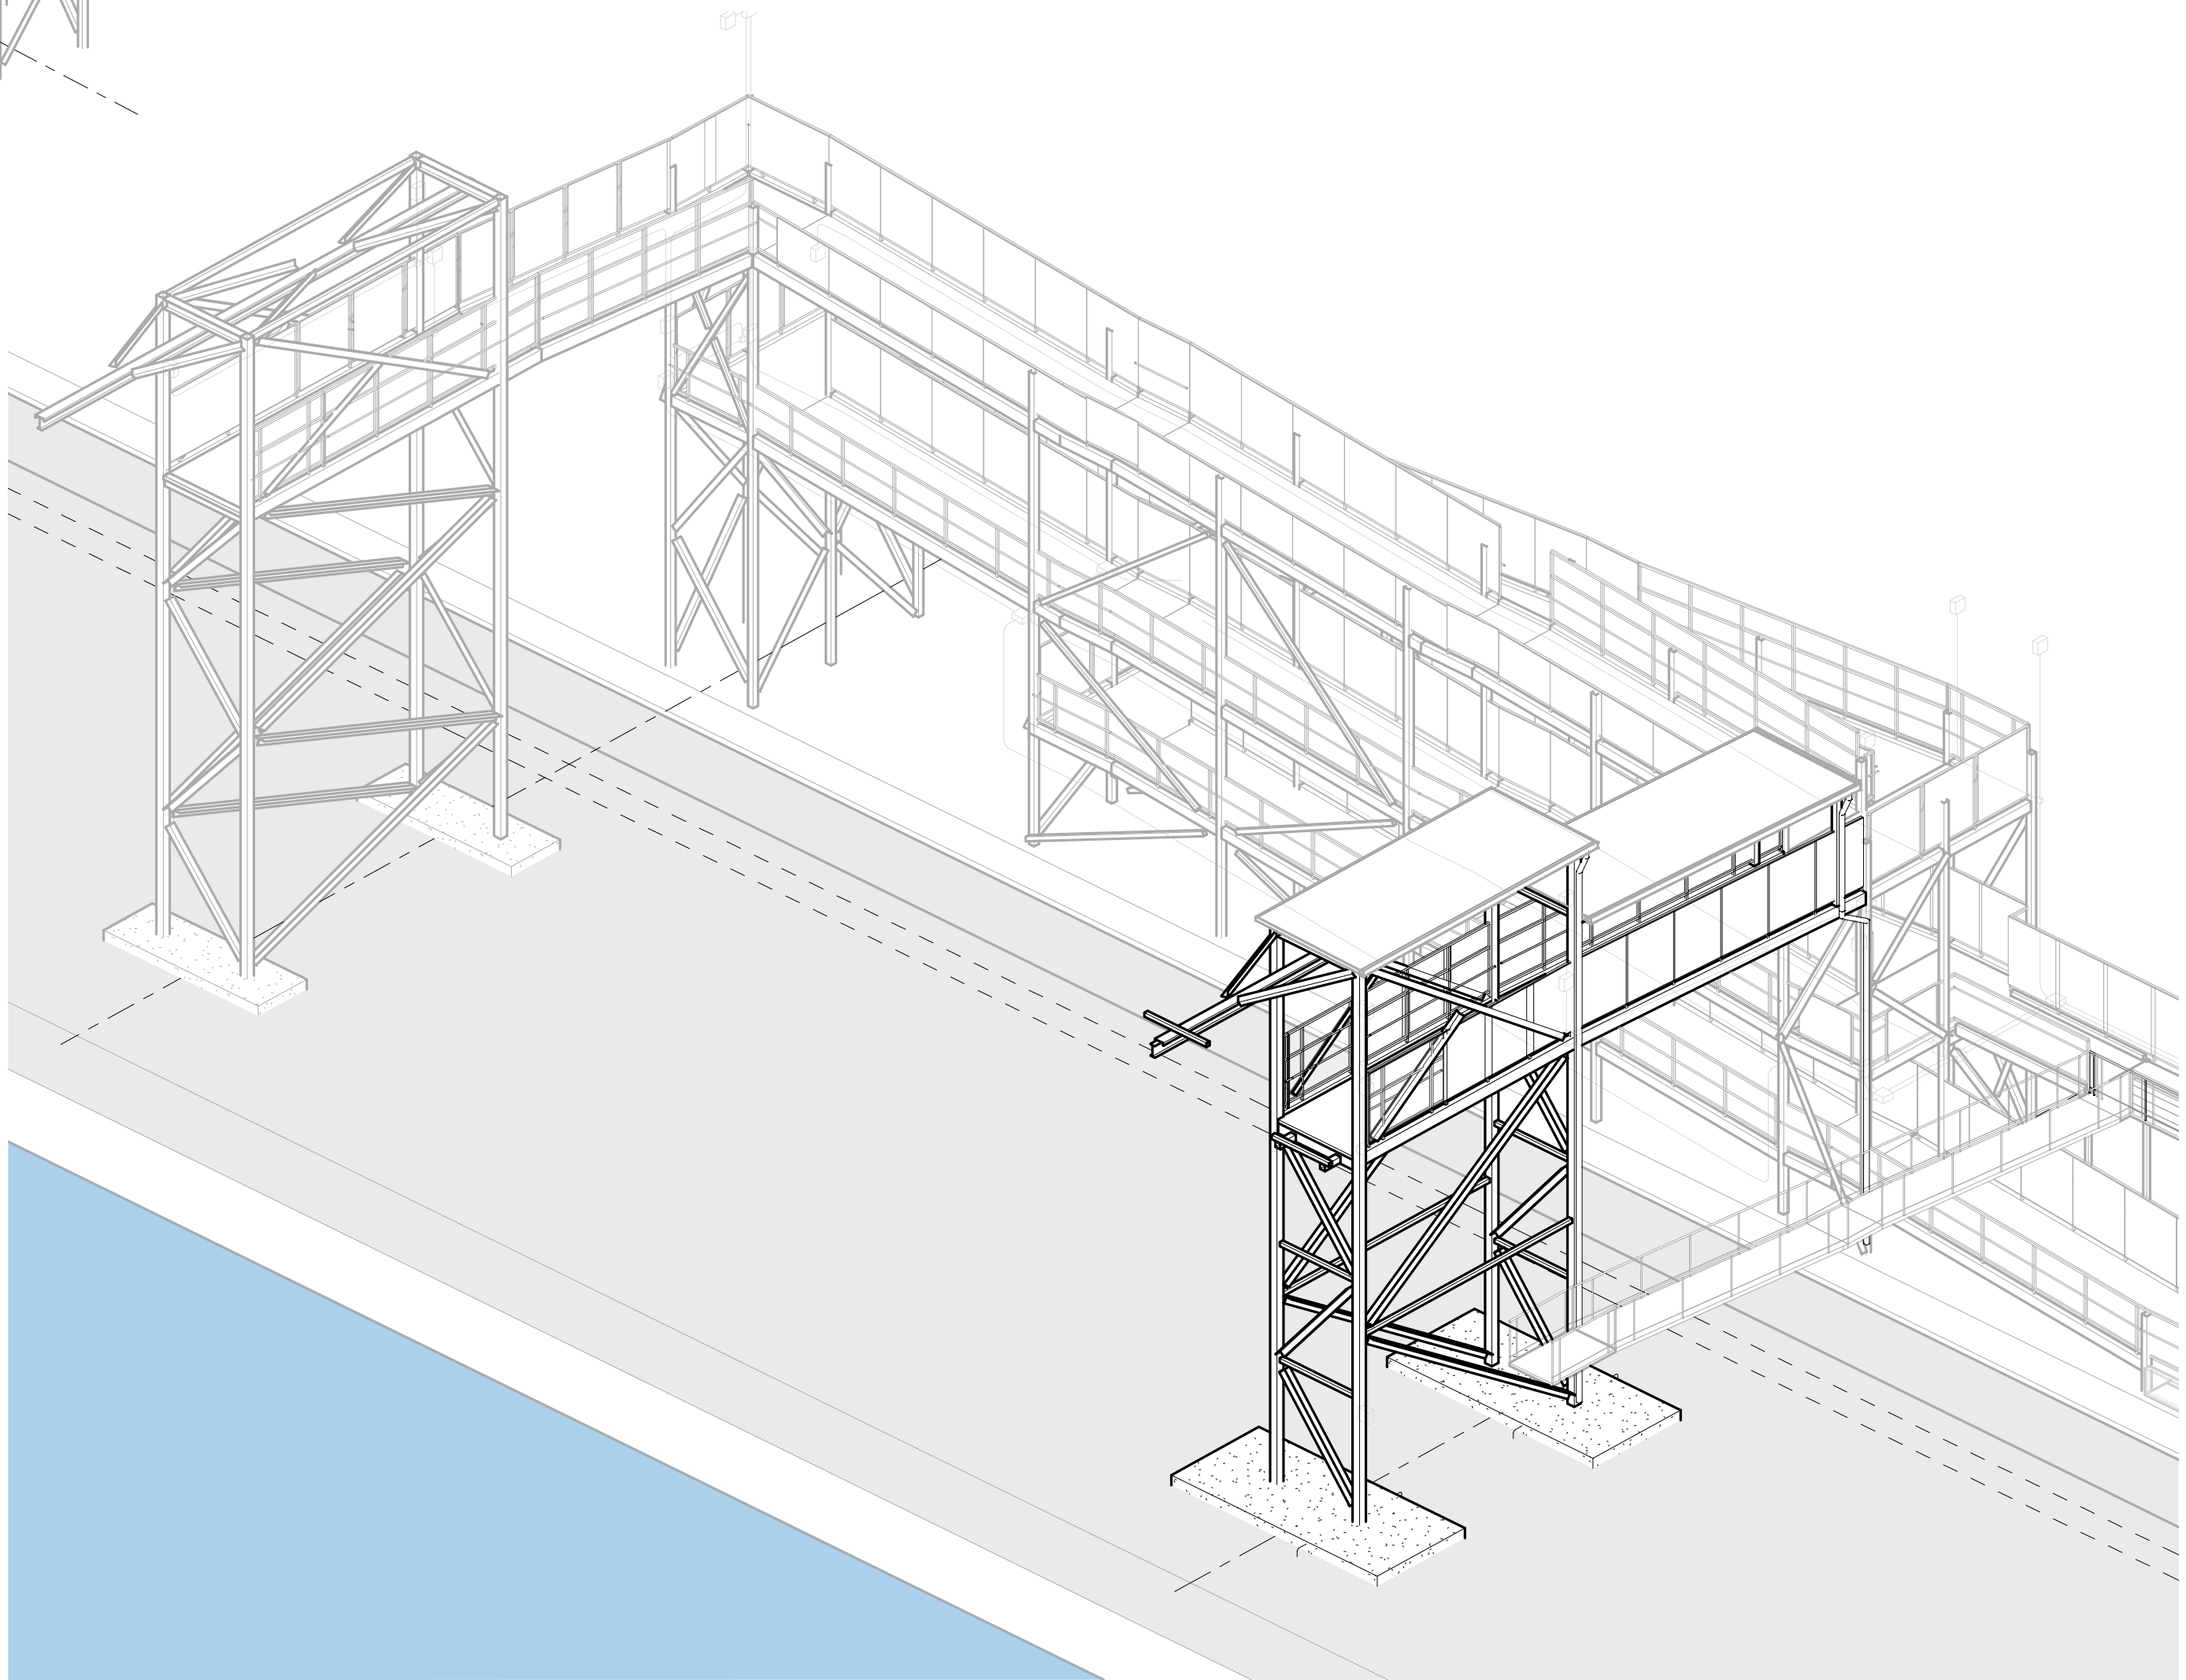

3D PERSPECTIVE - WHARF SIDE
2
NTS3 SCALE:

NOTES:

1. PERSPECTIVE VIEWS ARE PROVIDED FOR REFERENCE ONLY. NOT ALL FRAMING IS NECESSARILY VISIBLE IN VIEW. THESE VIEWS SHOULD NOT BE USED FOR BIDDING, DETAILING, FABRICATION, OR ERECTION PURPOSES.



10748 Deerwood Park Blvd. South
Jacksonville, Florida 32256-0597
904-256-2500 Fax 904-256-2503
www.rsandh.com
FL Cert. Nos. AAC001886 * IB26000956 *
5620 * LCC000210 * GB238



PROJECT TITLE:
JAXPORT CRUISE TERMINAL
GANGWAY MODIFICATION

PROJECT ADDRESS:
9810 AUGUST DRIVE
JACKSONVILLE, FL 32226

REVISIONS

NO.	DESCRIPTION	DATE


DATE ISSUED: 01/24/2025

REVIEWED BY: PFM

DRAWN BY: JAM

DESIGNED BY: LAP

PROJECT NUMBER:
10014153000

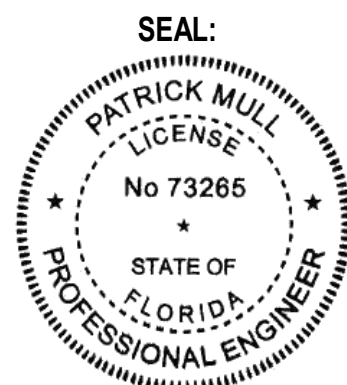

SHEET TITLE:
STRUCTURAL
ISOMETRICS

SHEET ID:

S013

PROJECT STATUS:
100% SUBMITTAL
FOR CONSTRUCTION



PROJECT TITLE:
JAXPORT CRUISE TERMINAL
GANGWAY MODIFICATION

PROJECT ADDRESS:
9810 AUGUST DRIVE
JACKSONVILLE, FL 32226


REVISIONS

[illegible]

DATE ISSUED:	01/24/2025
REVIEWED BY:	PFM
DRAWN BY:	JAM
DESIGNED BY:	LAP

PROJECT NUMBER:
10014153000

EAL:


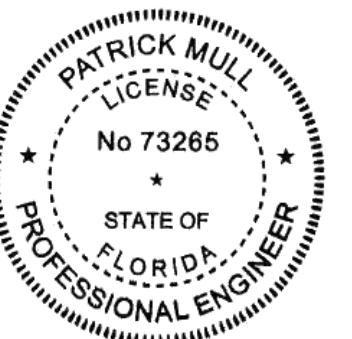


SHEET TITLE:
FOUNDATION PLAN

SHEET ID:

S101

PROJECT STATUS:
100% SUBMITTAL
FOR CONSTRUCTION

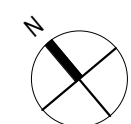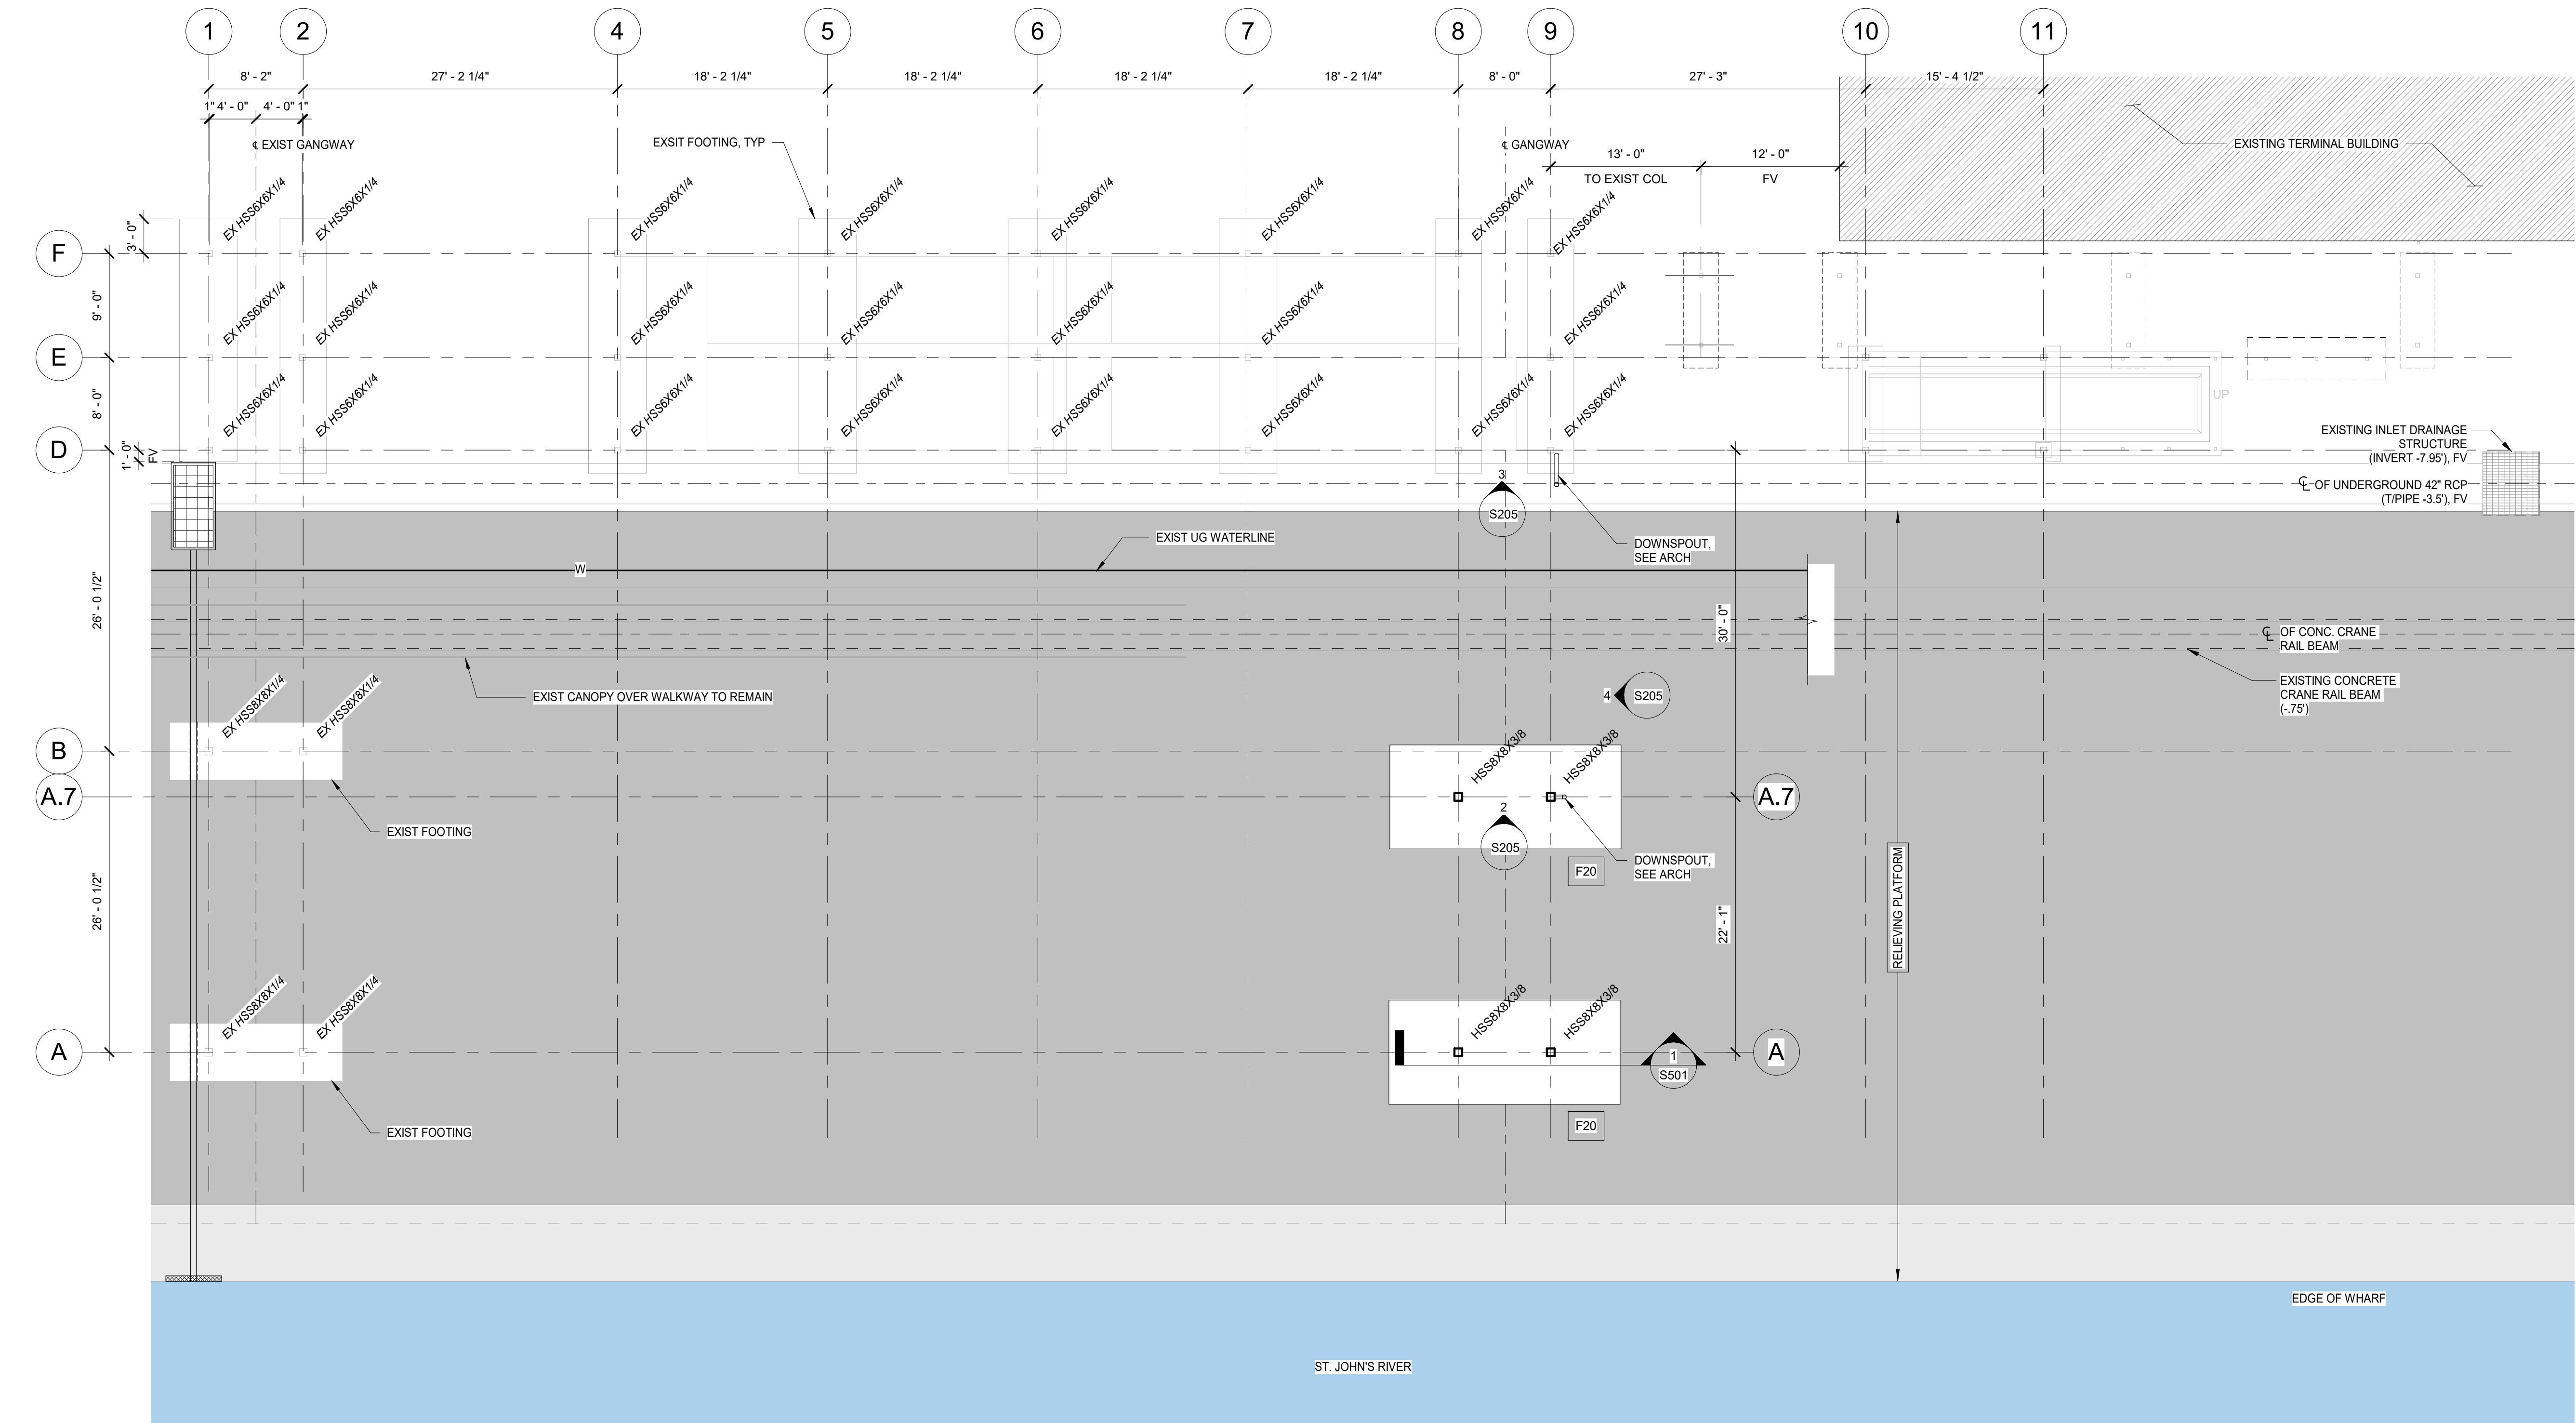

1 FOUNDATION PLAN


SCALE: 1/8" = 1'-0"


FOUNDATION PLAN NOTES:

1. DRAWING ELEVATION 0'-0" = EL. OF T/EXIST FOOTING LOCATED AT THE SOUTHWEST CORNER OF THE EXISTING TERMINAL BLDG (SEE PLAN FOR LOCATION).
2. FXX INDICATES SPREAD FOOTING TYPE. SEE PLAN & SCHEDULE, THIS SHEET.
3. FOR TYP COL BASE PL DETAILS SEE S501.

FOUNDATION SCHEDULE

TYPE	LENGTH	WIDTH	THICKNESS	REINFORCEMENT
F20	20' - 0"	9' - 0"	2' - 10"	10- #7 LONG T & B, 21-#7 SHORT, T & B, SEE 1/S501

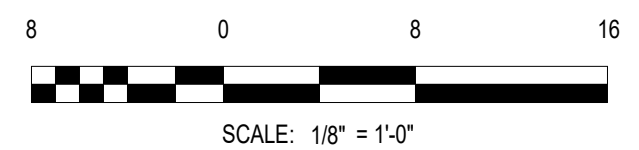


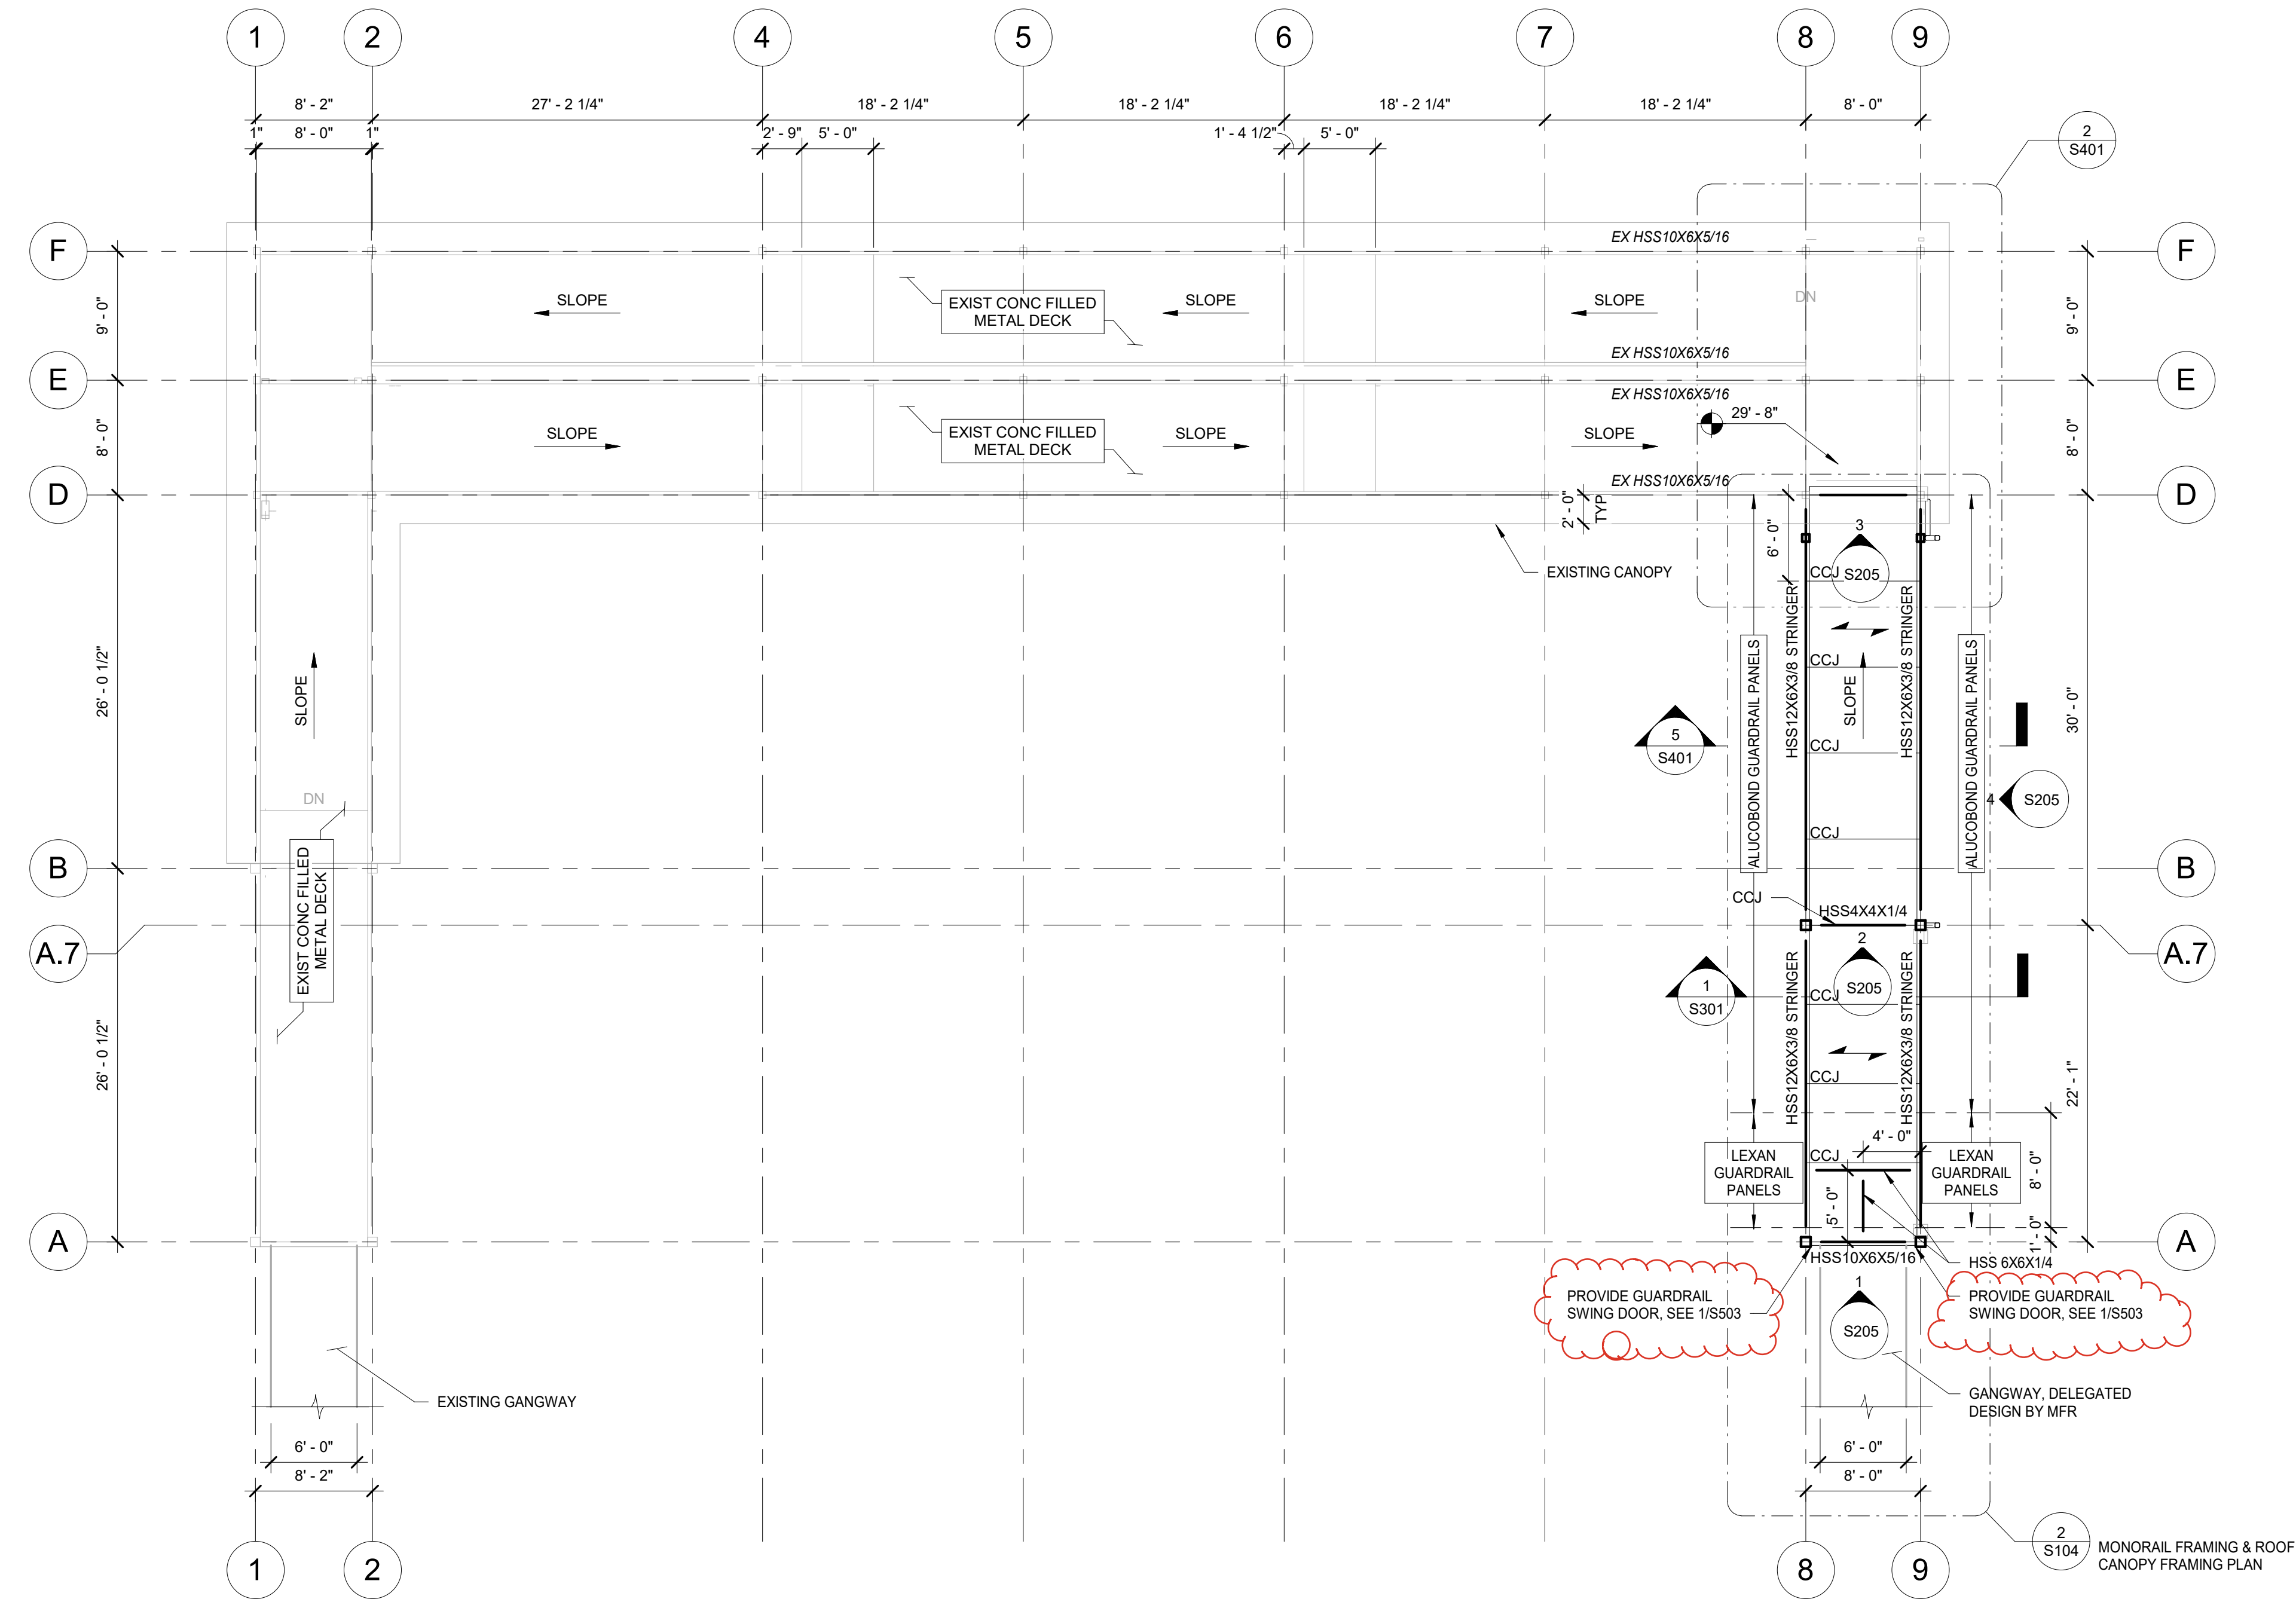


LEVEL 4 FRAMING PLAN
SCALE: 1/8" = 1'-0"

NOTES:

1. T/STL STRINGER AT PLATFORM & RAMP EDGES IS +4" FROM T/DECK. SEE DETAIL 1/S502.
2. FOR TYPICAL CONNECTIONS, SEE SHEET S502 AND S503.
3. CCJ INDICATES CONTRACTION CONTROL JOINT'S AT CONCRETE SURFACE, TYP. SEE 5/S501 FOR DETAIL.
4. INDICATES METAL FLOOR DECK SPAN DIRECTION. SEE SHEET S012 FOR METAL DECK NOTES.
5. FOR GUARDRAIL INFILL PANEL TYPE, SEE PLANS.
6. FOR GUARDRAIL DETAILS, SEE S-502.

MONORAIL FRAMING & ROOF CANOPY PLAN
SCALE: 3/16" = 1'-0"

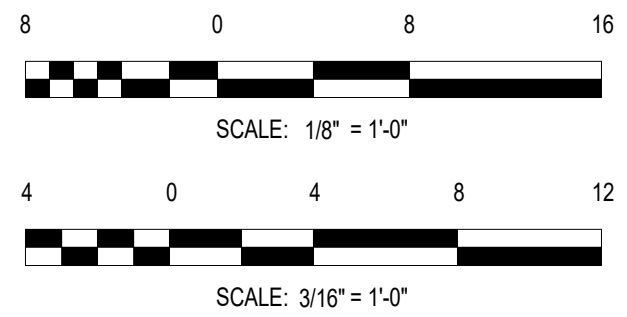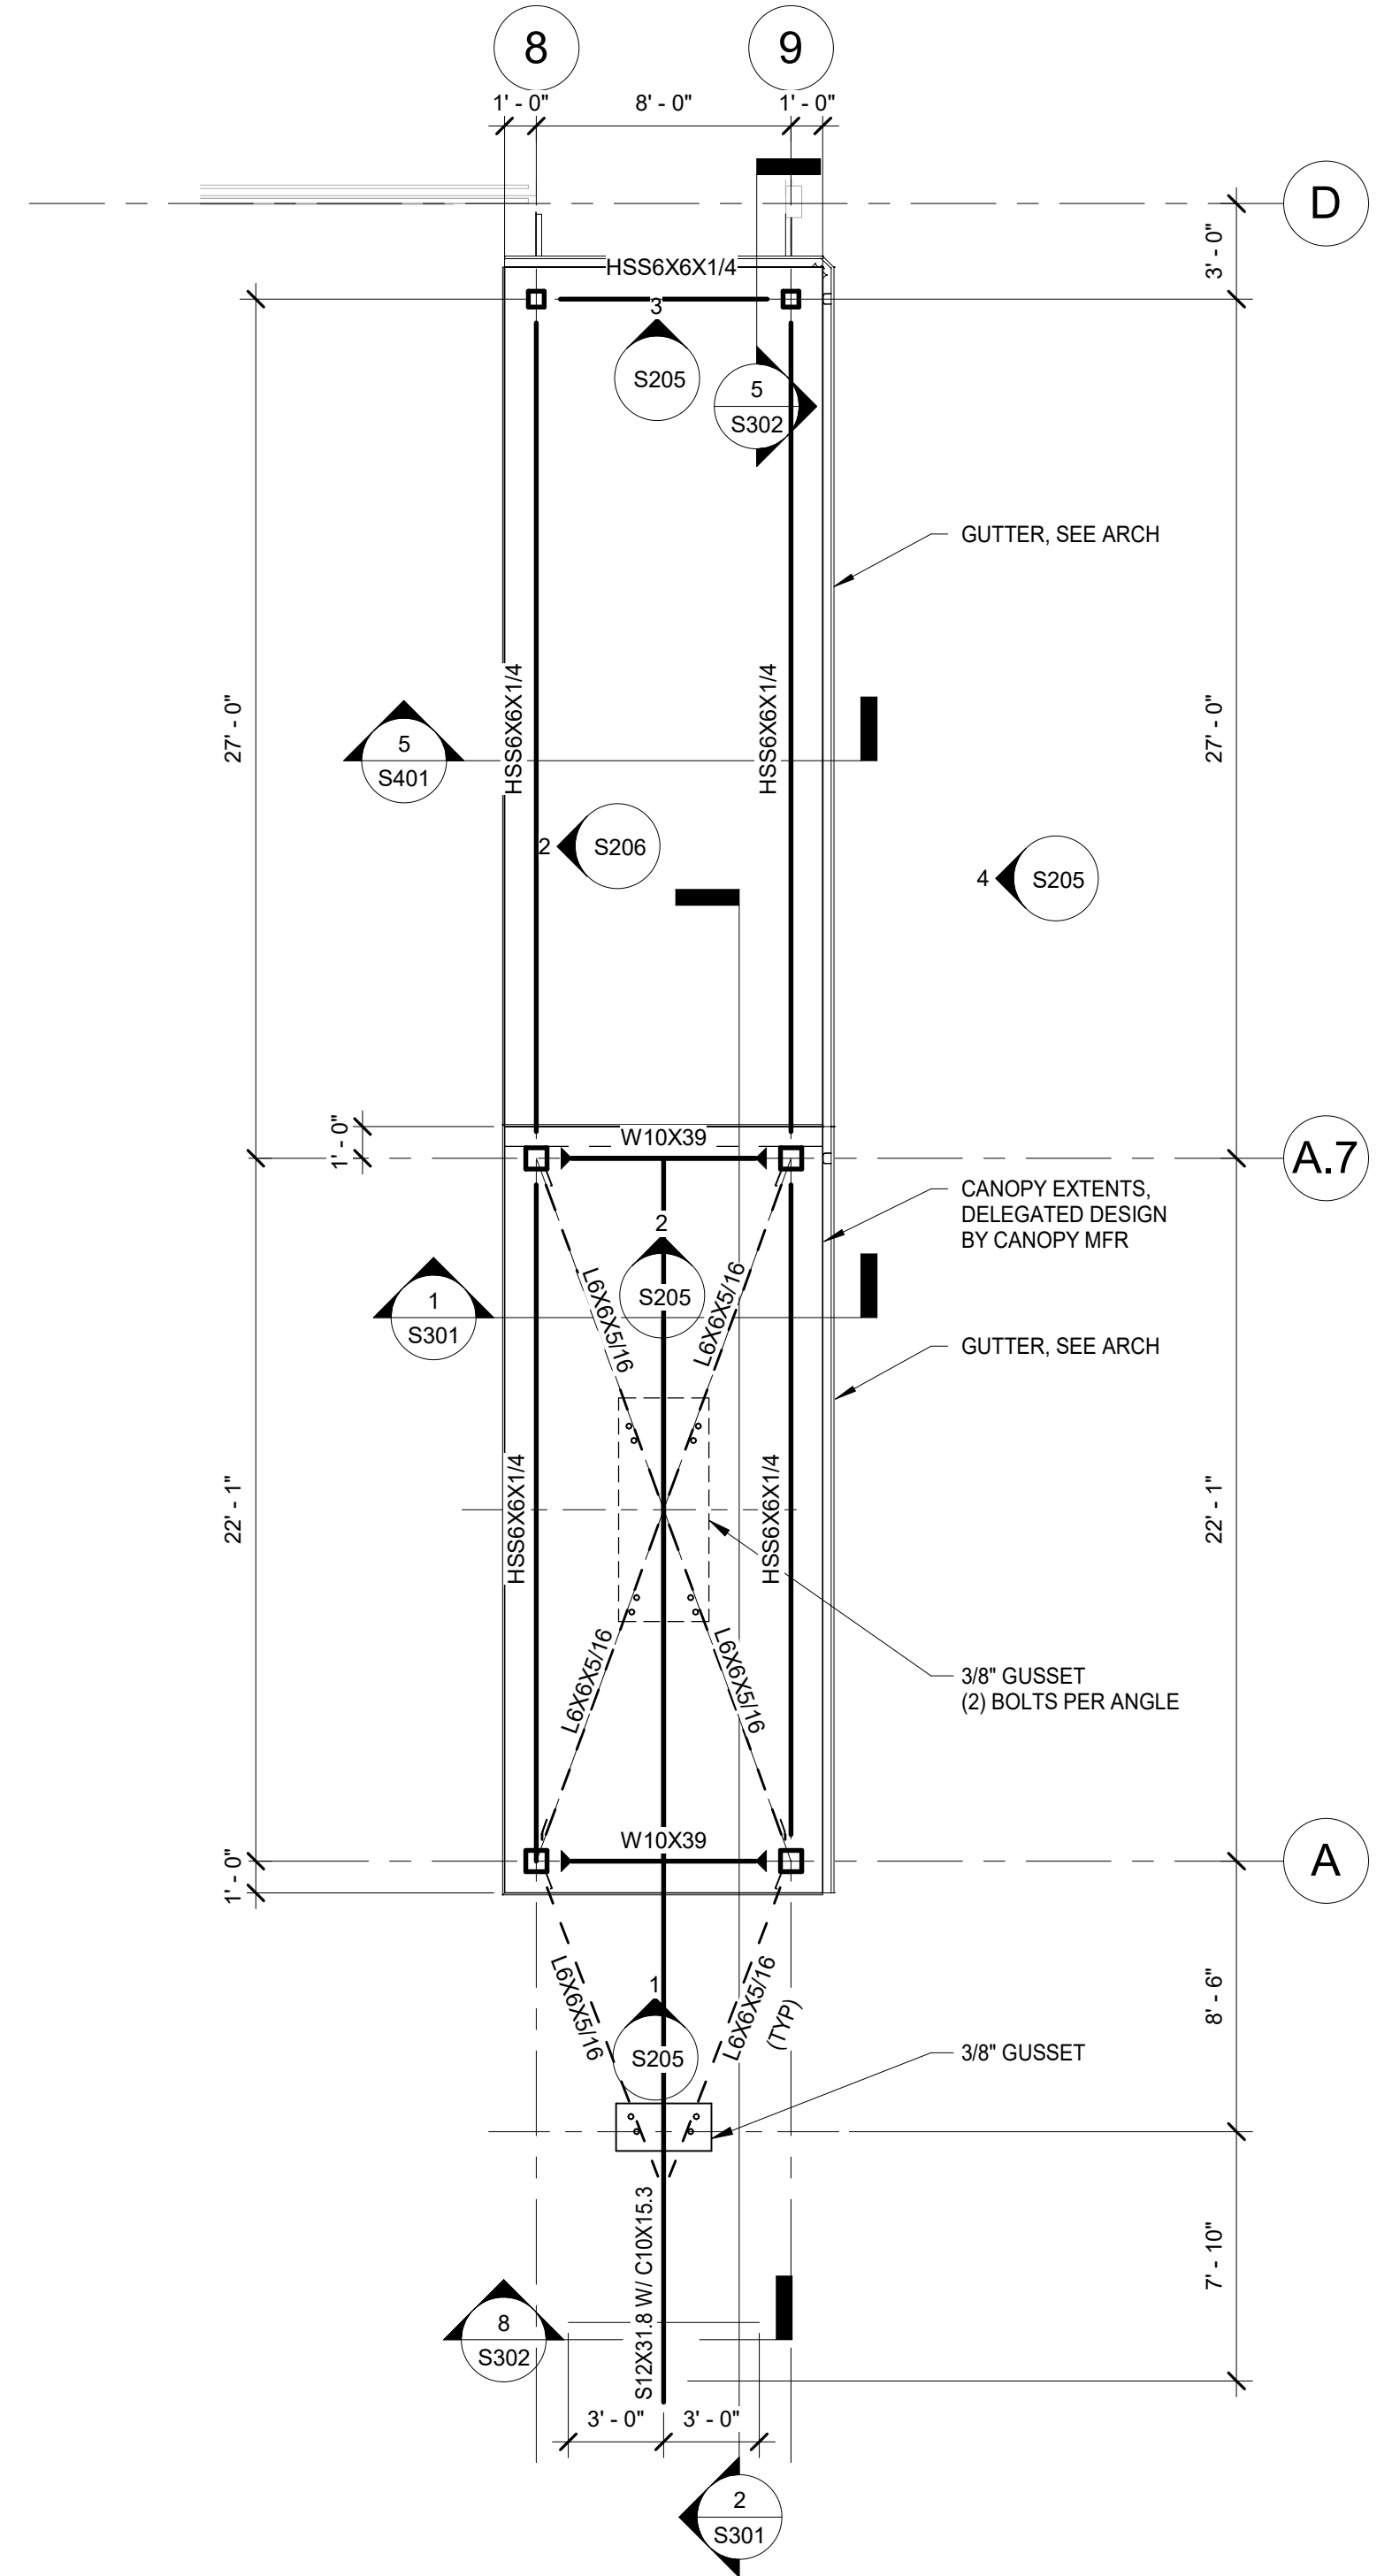

10748 Deerwood Park Blvd. South
Jacksonville, Florida 32256-0597
904-256-2500 Fax 904-256-2503
www.rsandh.com
FL Cert. Nos. AAC001886 * IB26000956 *
5620 * LCC000210 * GB238




PROJECT TITLE:
JAXPORT CRUISE TERMINAL
GANGWAY MODIFICATION

PROJECT ADDRESS:
9810 AUGUST DRIVE
JACKSONVILLE, FL 32226

REVISIONS

NO.	DESCRIPTION	DATE

DATE ISSUED: 01/24/2025
REVIEWED BY: PFM
DRAWN BY: JAM
DESIGNED BY: LAP
PROJECT NUMBER:
10014153000

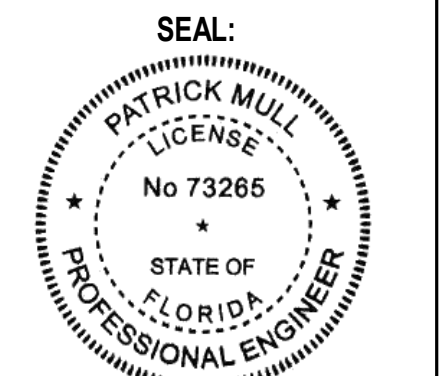

SHEET TITLE:
RAMP FRAMING PLAN -
UPPER

SHEET ID:

S104

PROJECT STATUS:
100% SUBMITTAL
FOR CONSTRUCTION

FRAMING ELEVATION NOTES:

- INDICATES TOP OF RAMP ELEVATION.
- (+/- X'-X") INDICATES WORK POINT ELEVATION ABOVE OR BELOW TOP OF RAMP.
- T/STL STRINGER IS +4" FROM T/DECK. SEE DETAIL 1/S502.
 - FOR LANDING DIMENSIONS AND ELEVATIONS, SEE FRAMING PLANS.
 - FOR TYPICAL CONNECTIONS, SEE SHEET S502 AND S503.
 - (ECC) INDICATES ECCENTRIC BRACE, FACE OF BRACE IS ALIGNED TO FACE OF SUPPORTING HSS MEMBERS AT END CONNECTIONS.
 - PROVIDE (2) INTERMEDIATE CONNECTORS AT EQ SPACING ALONG LENGTH.



10748 Deerwood Park Blvd. South
Jacksonville, Florida 32256-0597
904-256-2500 Fax 904-256-2503
www.rsandh.com
FL Cert. Nos. AAC001886 * IB26000956 *
5620 * LCC000210 * GB238




PROJECT TITLE:
JAXPORT CRUISE TERMINAL
GANGWAY MODIFICATION

PROJECT ADDRESS:
9810 AUGUST DRIVE
JACKSONVILLE, FL 32226

REVISIONS		
NO.	DESCRIPTION	DATE


DATE ISSUED: 01/24/2025
REVIEWED BY: PFM
DRAWN BY: JAM
DESIGNED BY: LAP
PROJECT NUMBER: 10014153000

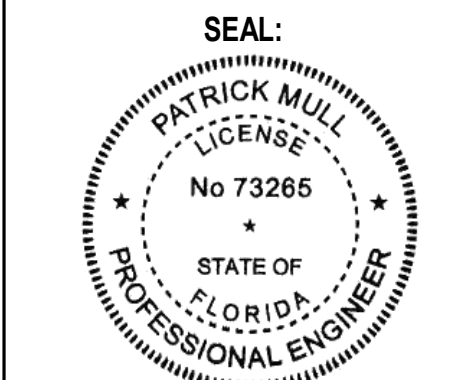


SHEET TITLE:
FRAMING ELEVATIONS

SHEET ID:
S205


PROJECT STATUS:
100% SUBMITTAL
FOR CONSTRUCTION

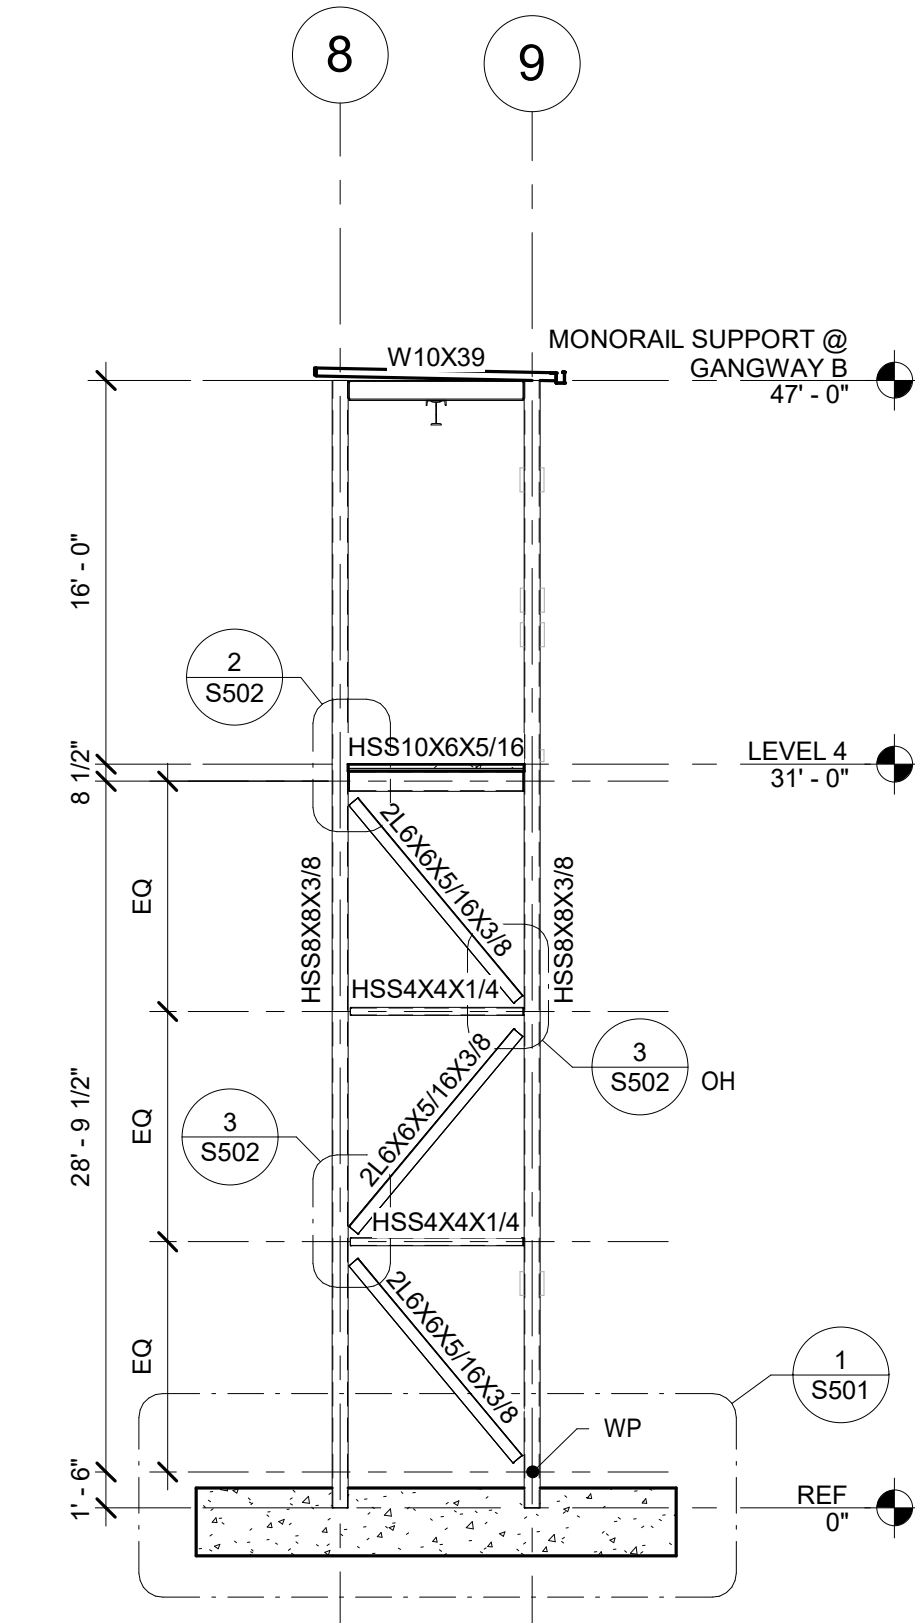


1 GRID A FRAMING ELEVATION
S205 SCALE: 1/8" = 1'-0"

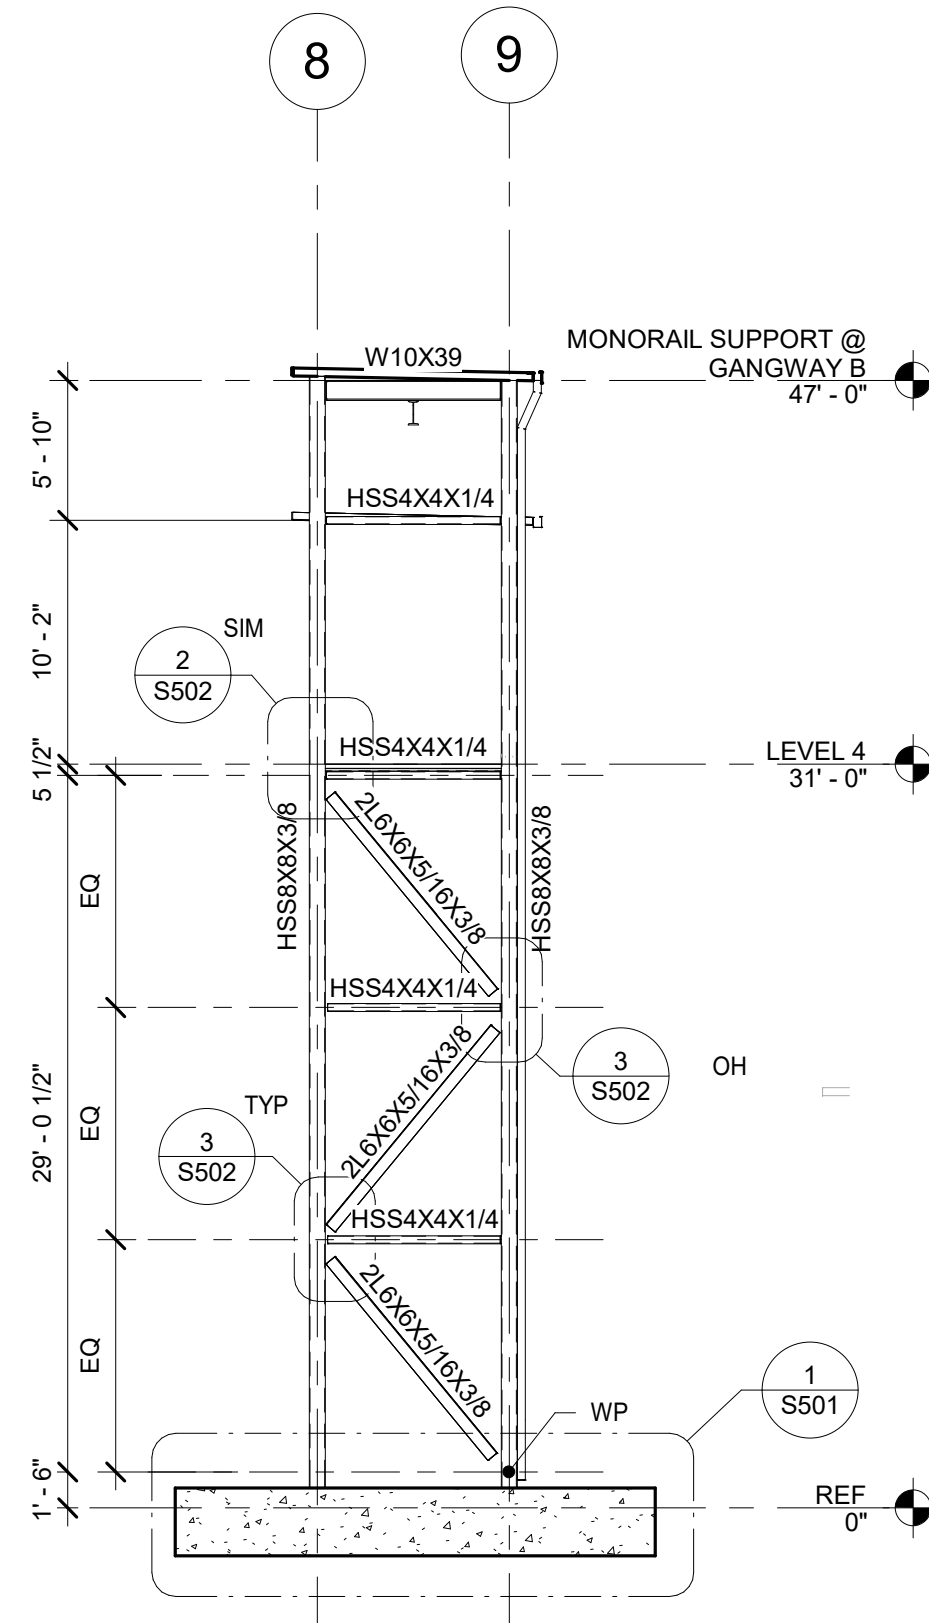

2 GRID A.7 FRAMING ELEVATION
S205 SCALE: 1/8" = 1'-0"

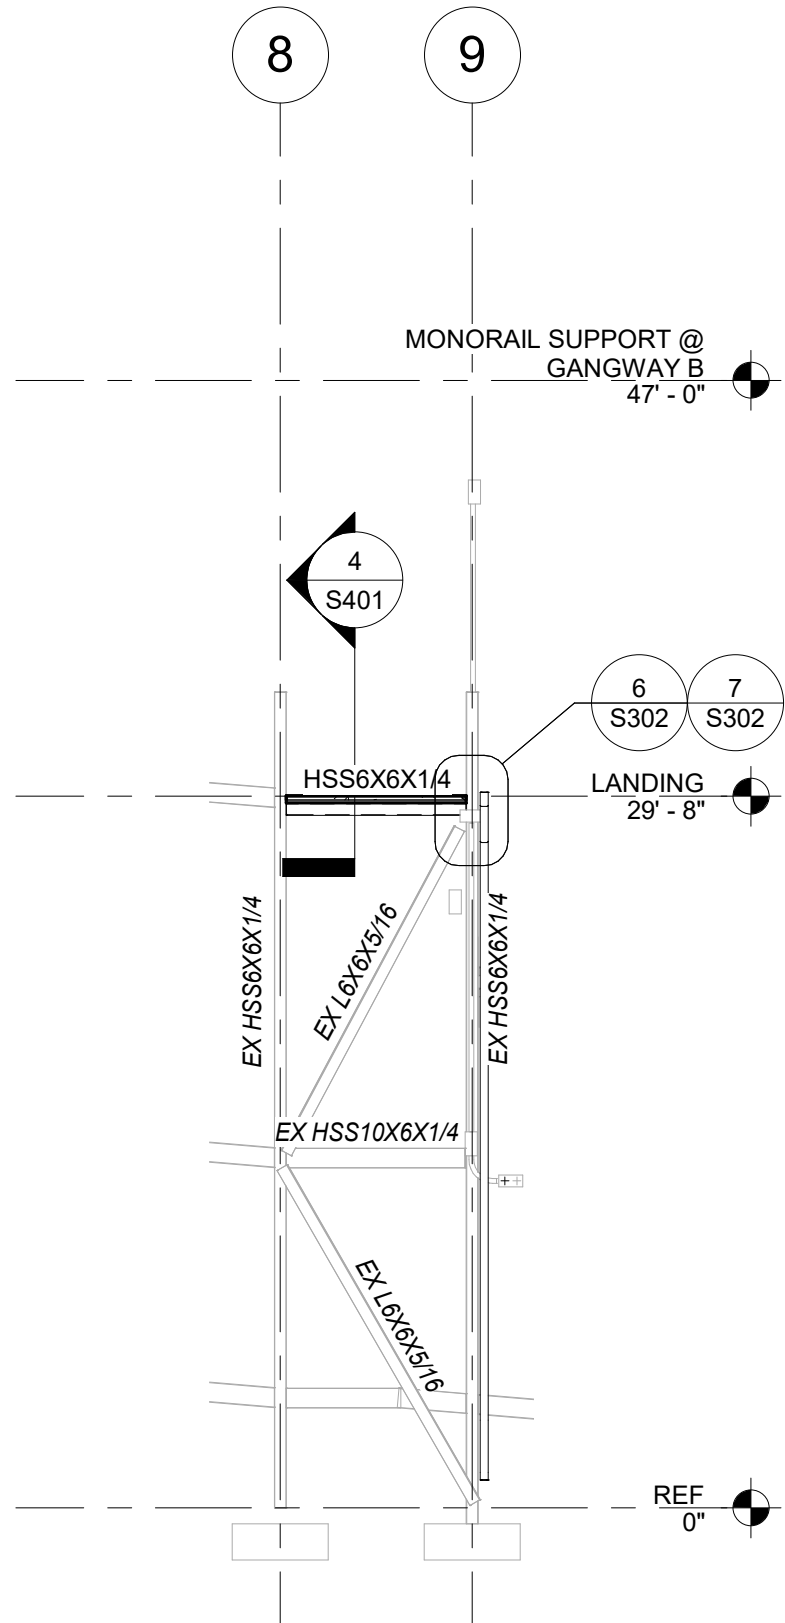





3 GRID D FRAMING ELEVATION
S205 SCALE: 1/8" = 1'-0"

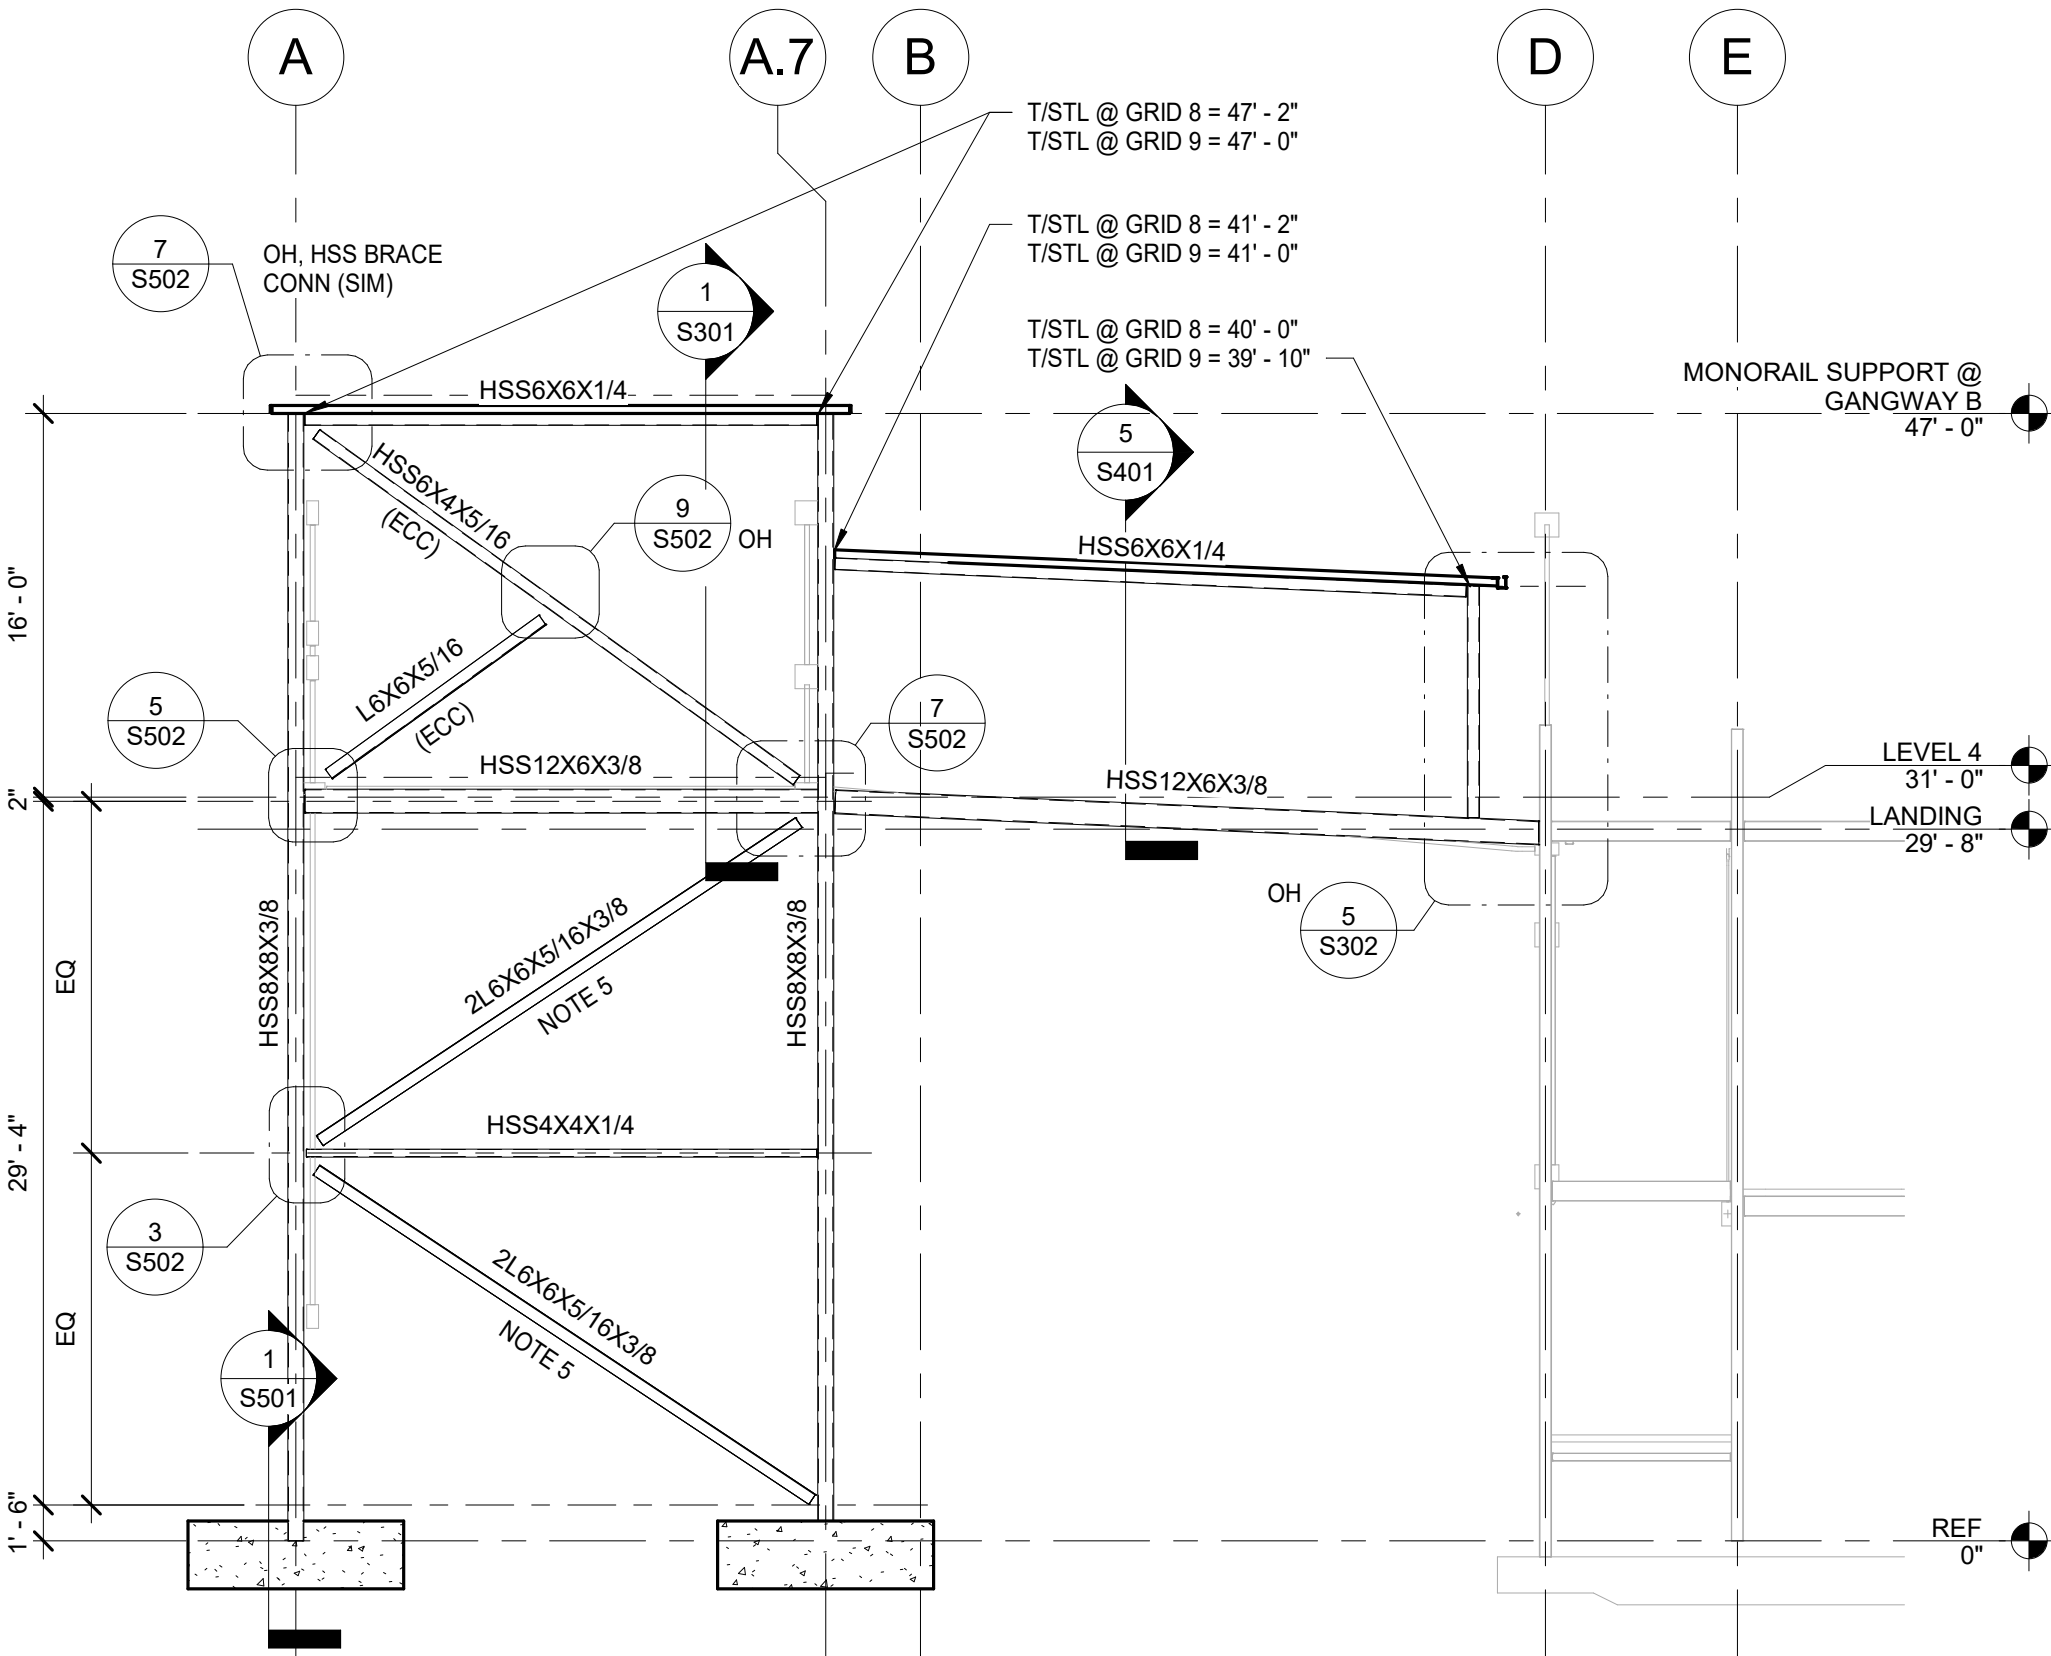

4 GRID 9 FRAMING ELEVATION
S205 SCALE: 1/8" = 1'-0"



SCALE: 1/8" = 1'-0"

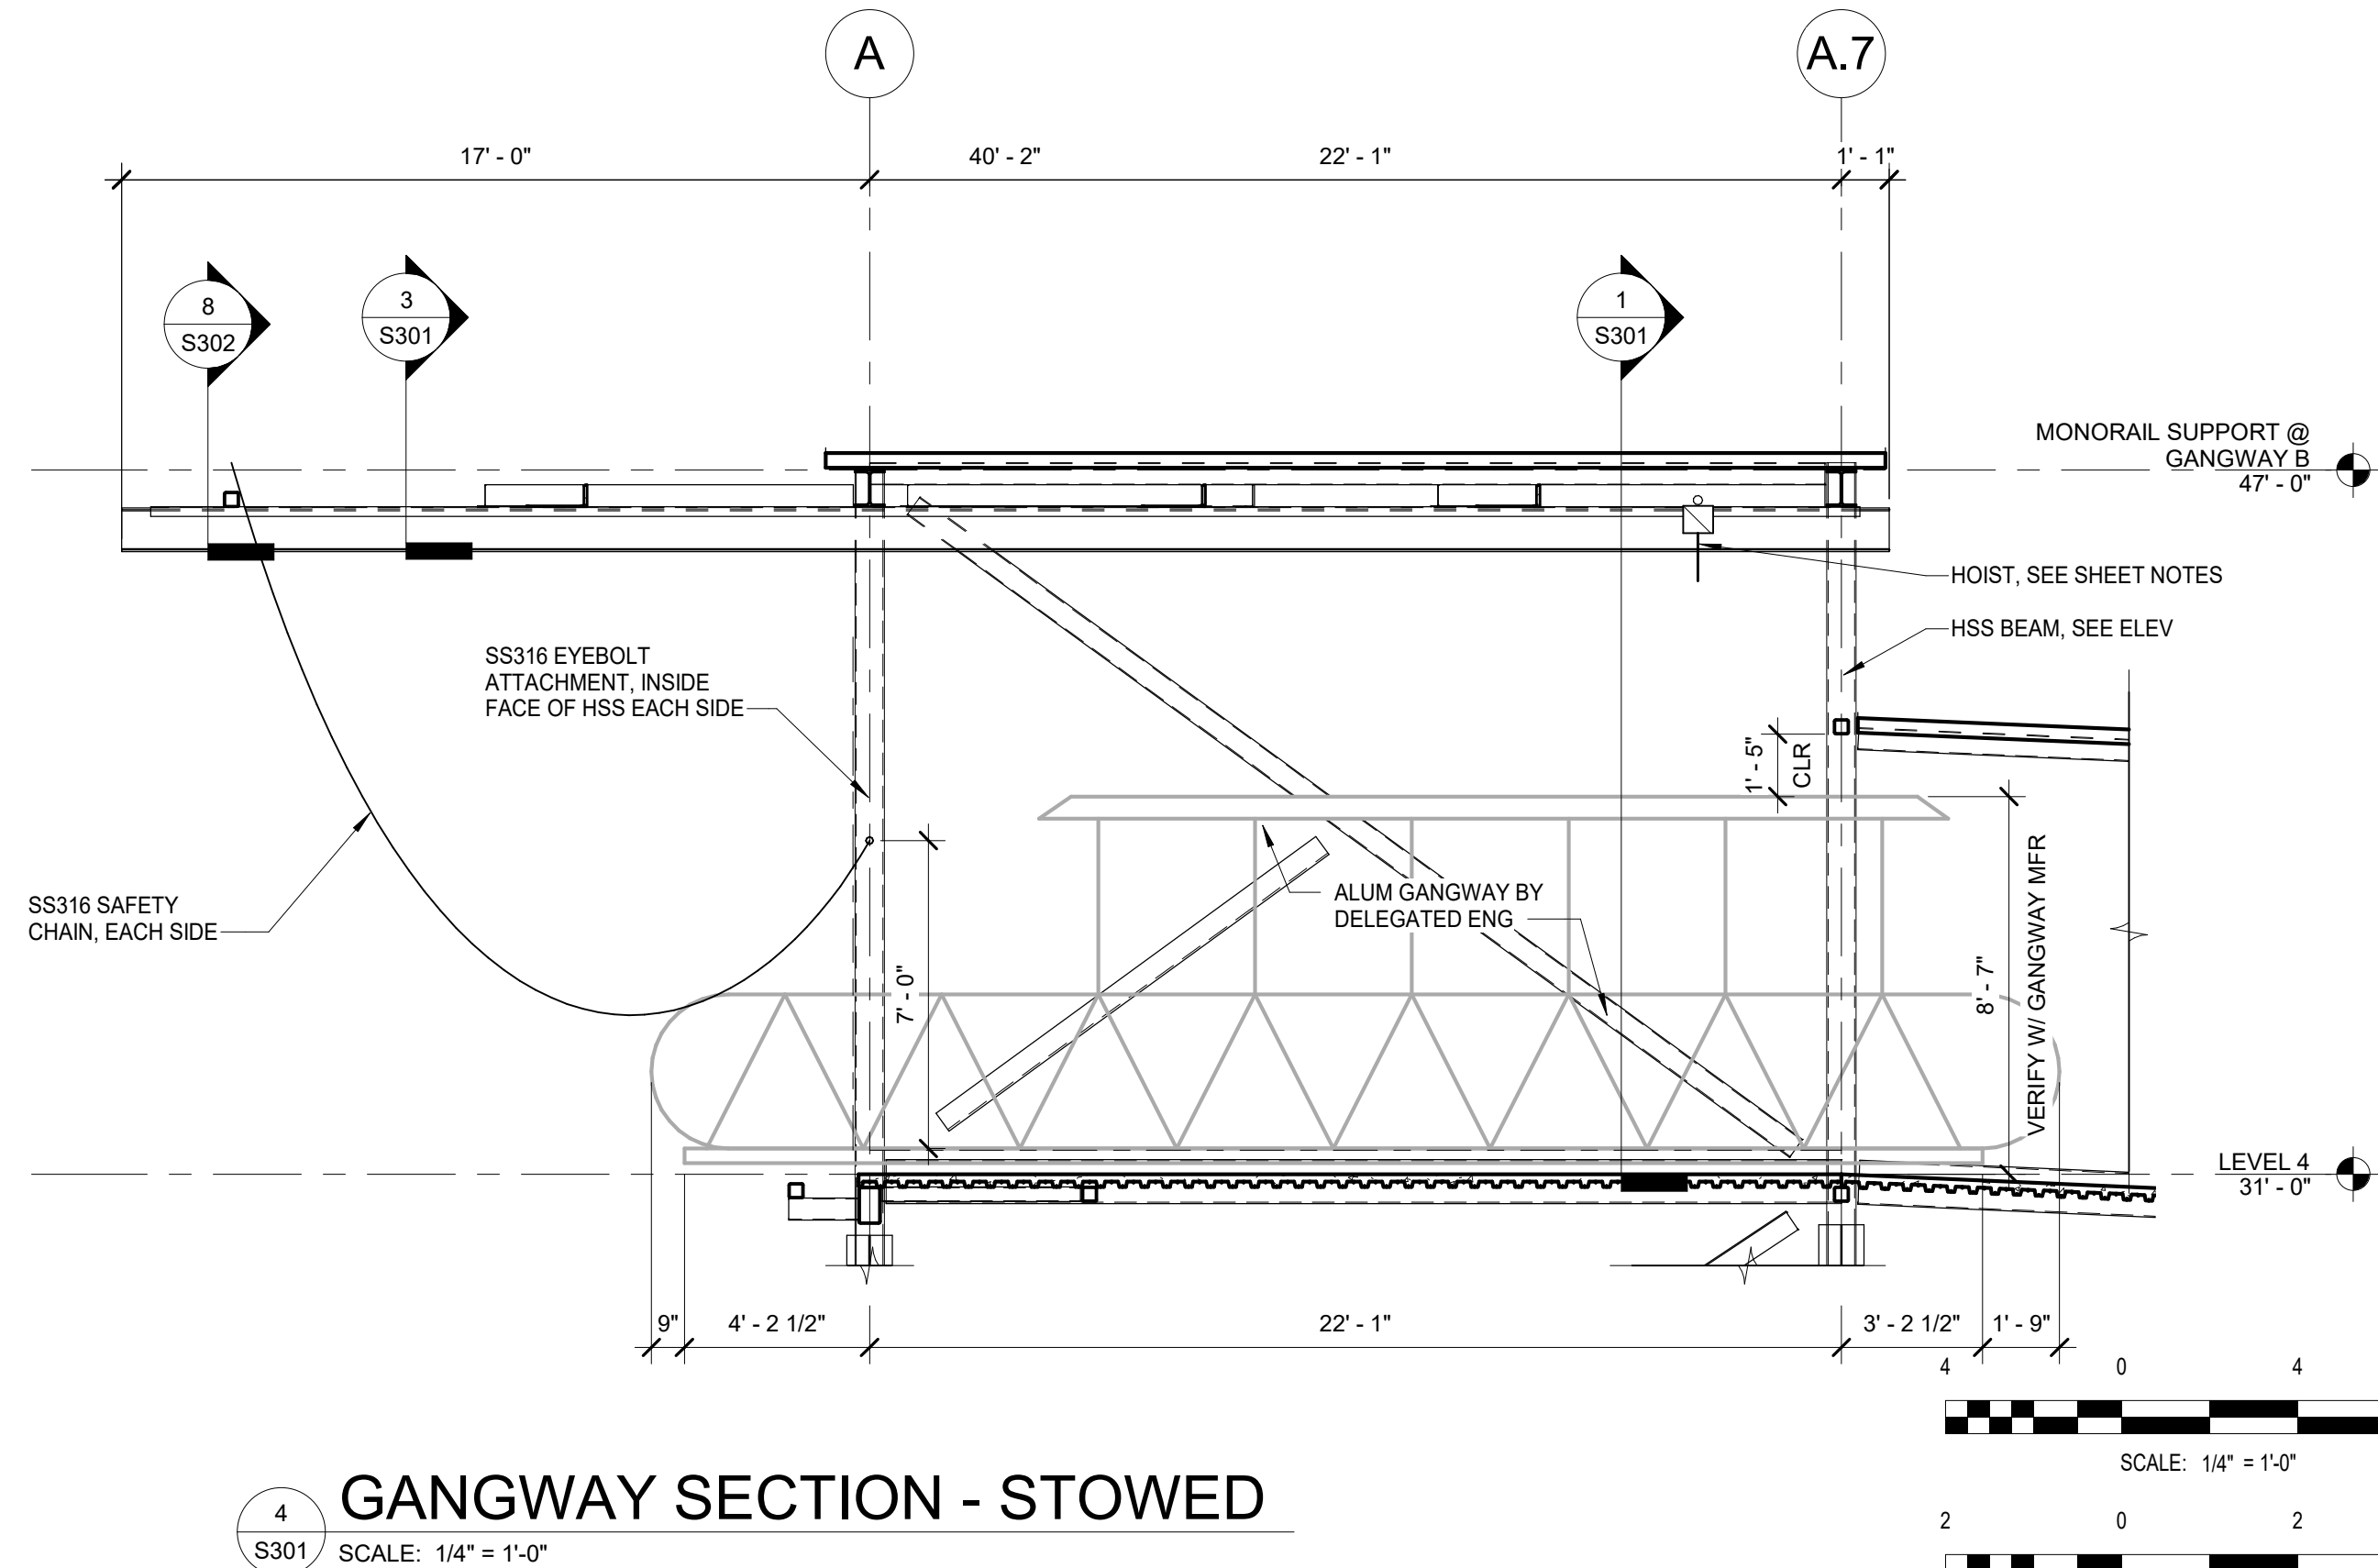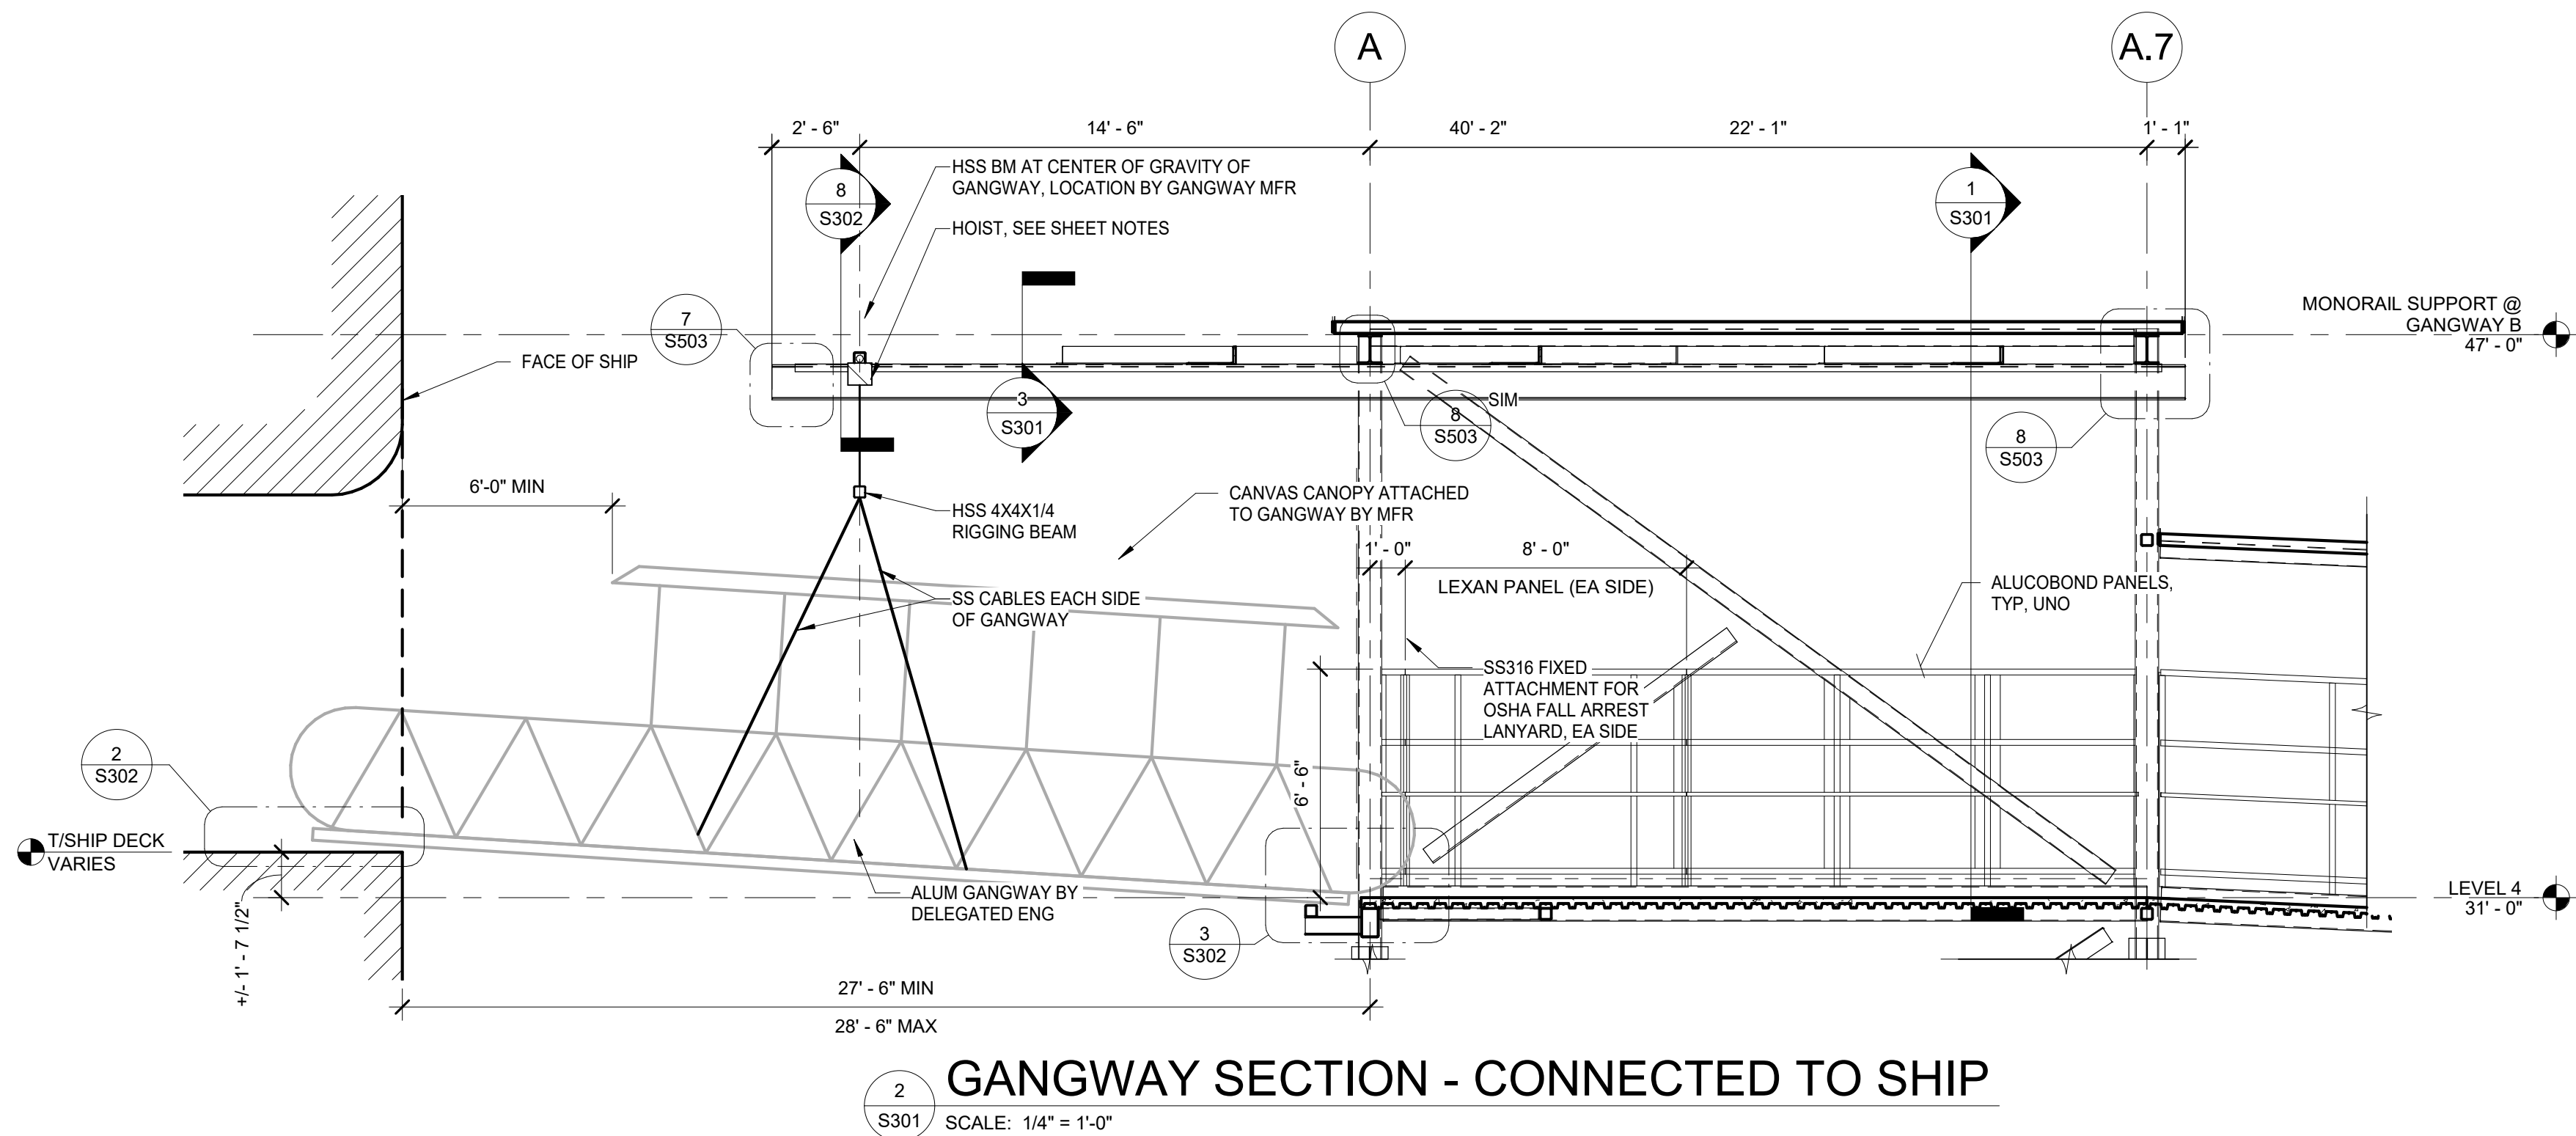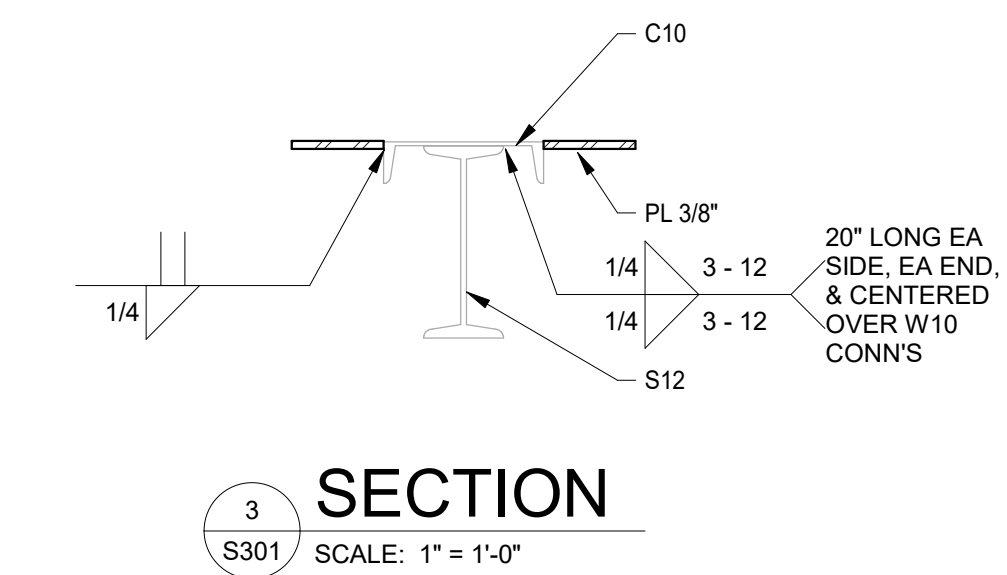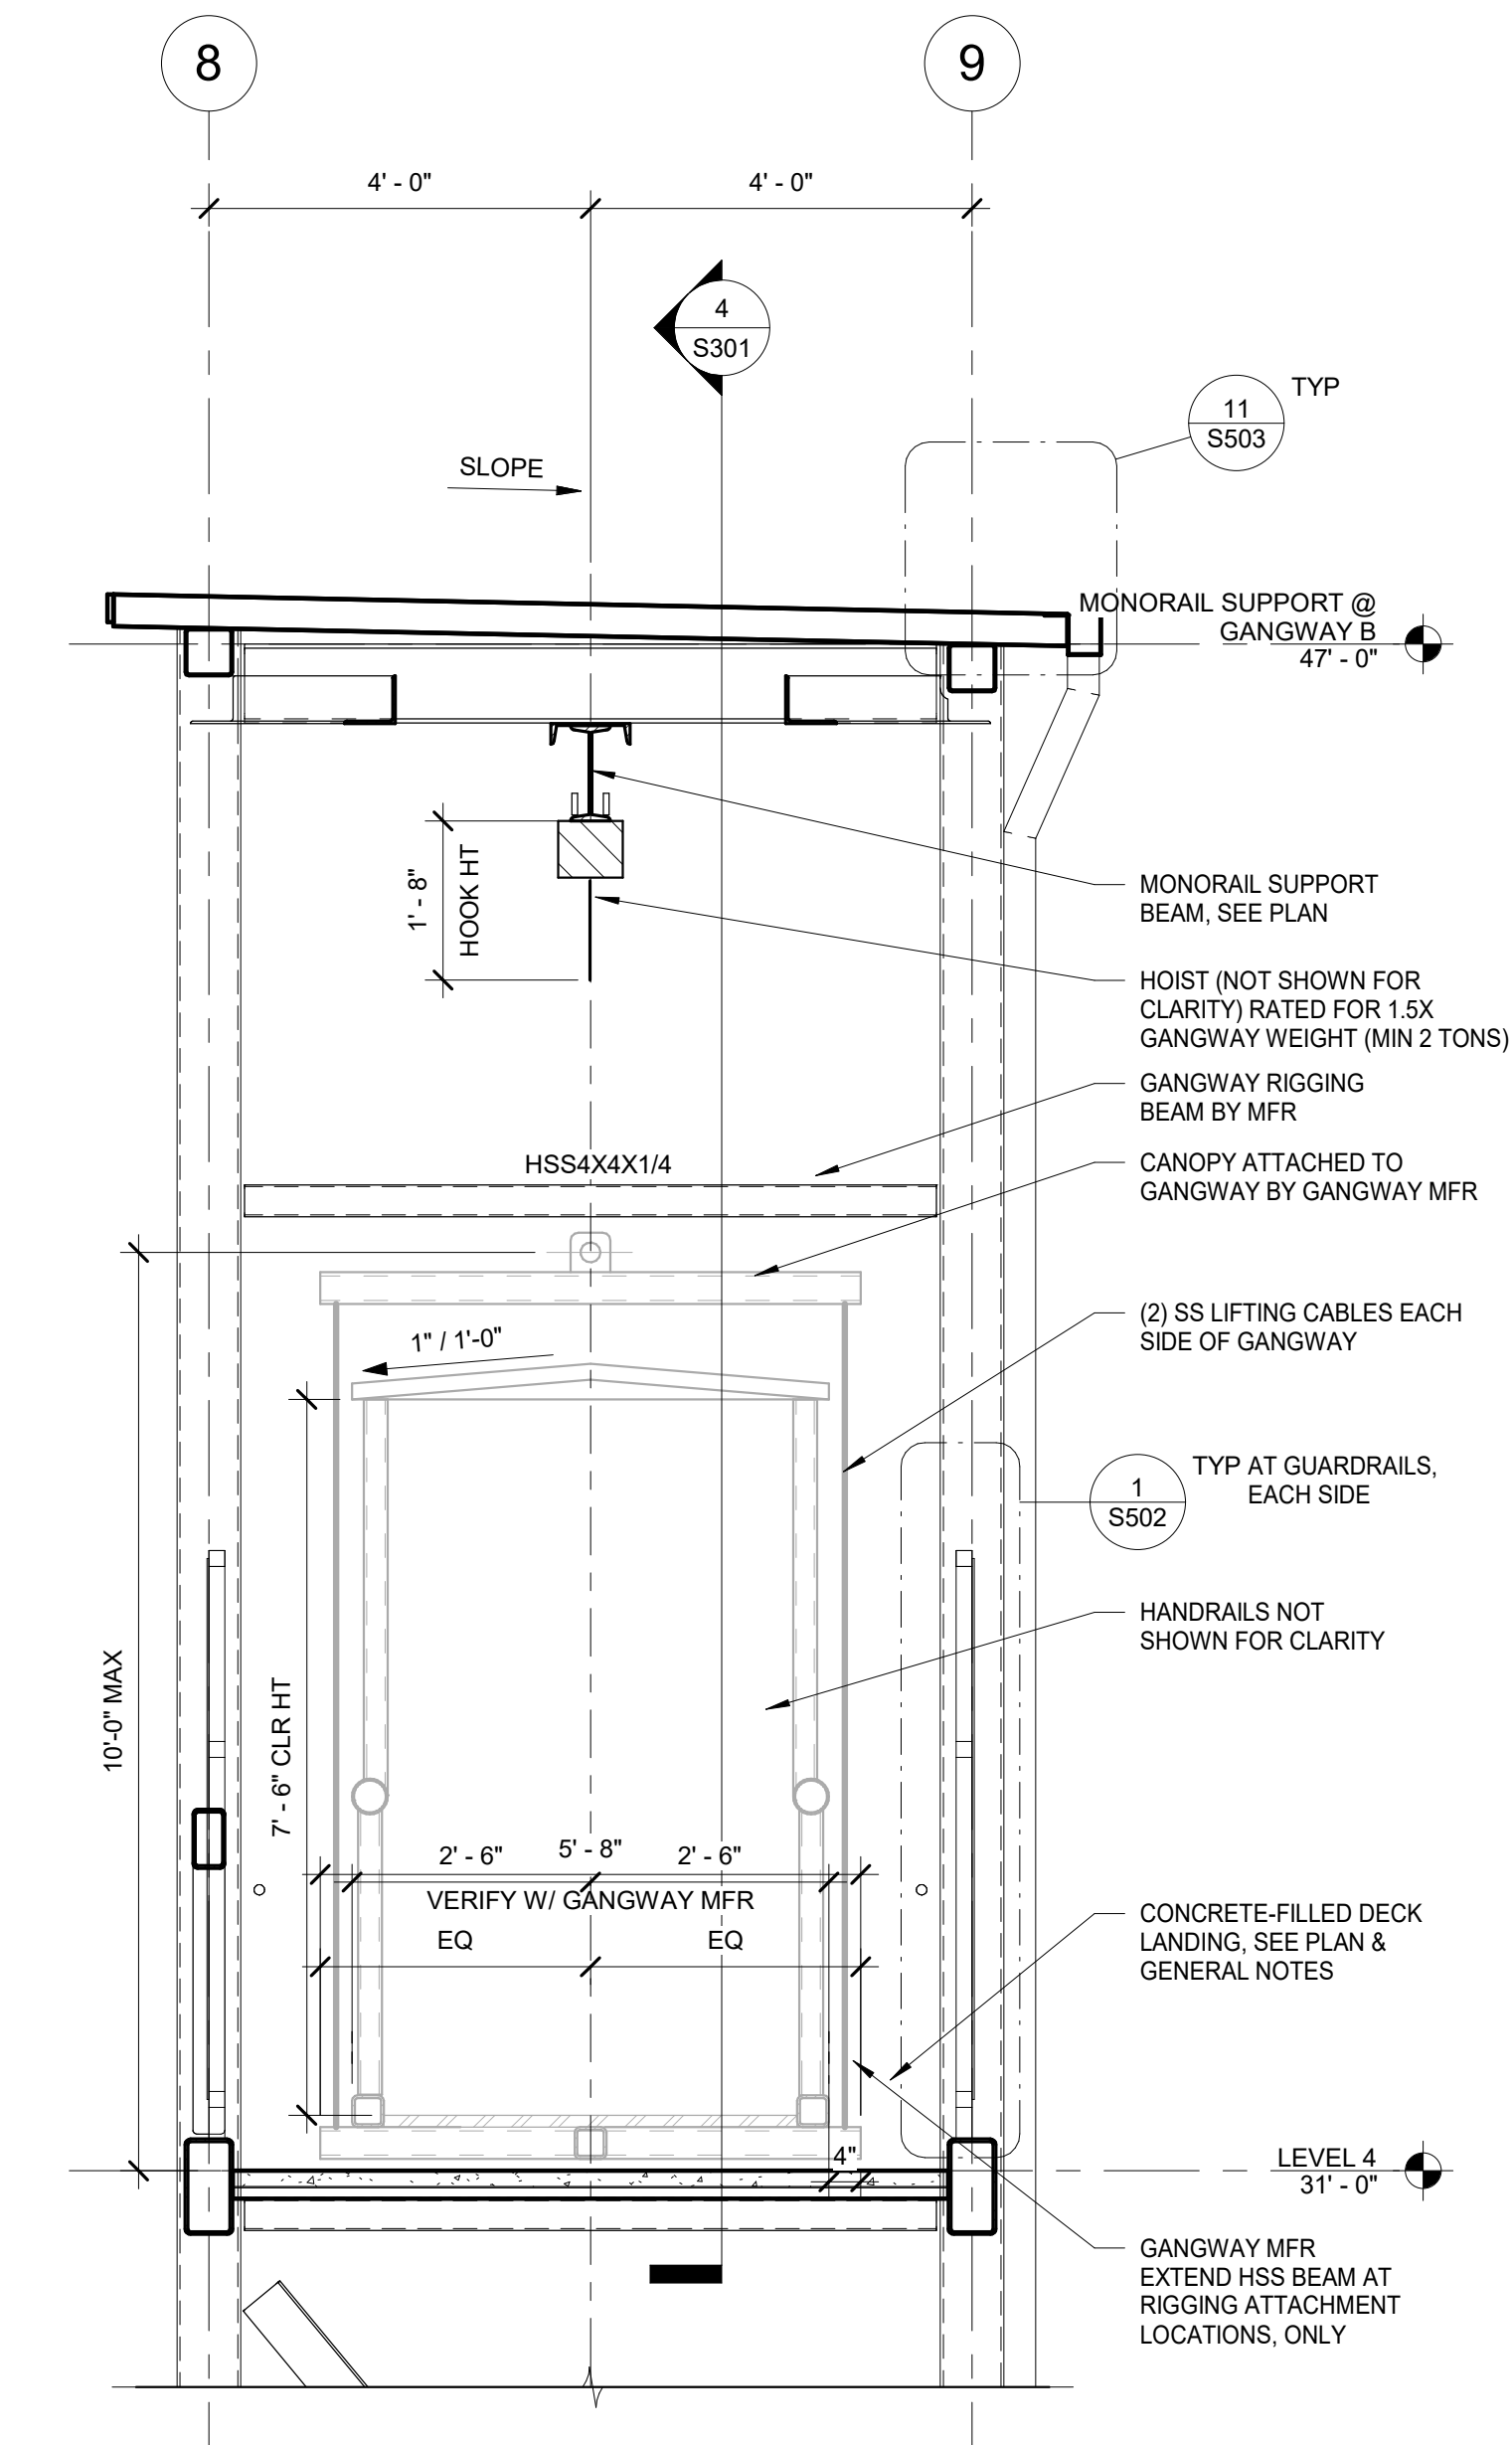

MONORAIL CRANE NOTES:

1. HOIST HOOK HEIGHT 12'-6" ABOVE T/LANDING.
2. CRANE CAPACITY = 2 TONS. VERIFY GANGWAY WEIGHT W/ MFR.
3. AVAILABLE LIFT = 46 FT.



10748 Deerwood Park Blvd. South
Jacksonville, Florida 32256-0597
904-256-2500 Fax 904-256-2503
www.rsandh.com
FL Cert. Nos. AAC001886 * IB26000956 *
5620 * LCC000210 * GB238




PROJECT TITLE:
JAXPORT CRUISE TERMINAL
GANGWAY MODIFICATION

PROJECT ADDRESS:
9810 AUGUST DRIVE
JACKSONVILLE, FL 32226

REVISIONS

NO.	DESCRIPTION	DATE









DATE ISSUED: 01/24/2025
REVIEWED BY: PFM
DRAWN BY: JAM
DESIGNED BY: LAP
PROJECT NUMBER: 10014153000

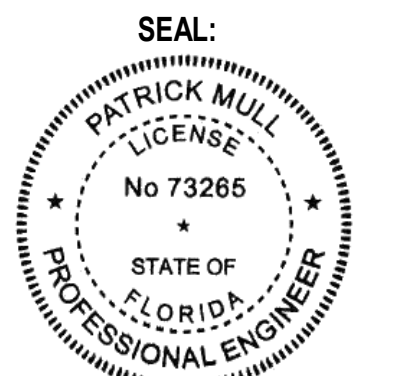

SHEET TITLE:
STRUCTURAL
SECTIONS - I

SHEET ID:
S301

PROJECT STATUS:
100% SUBMITTAL
FOR CONSTRUCTION

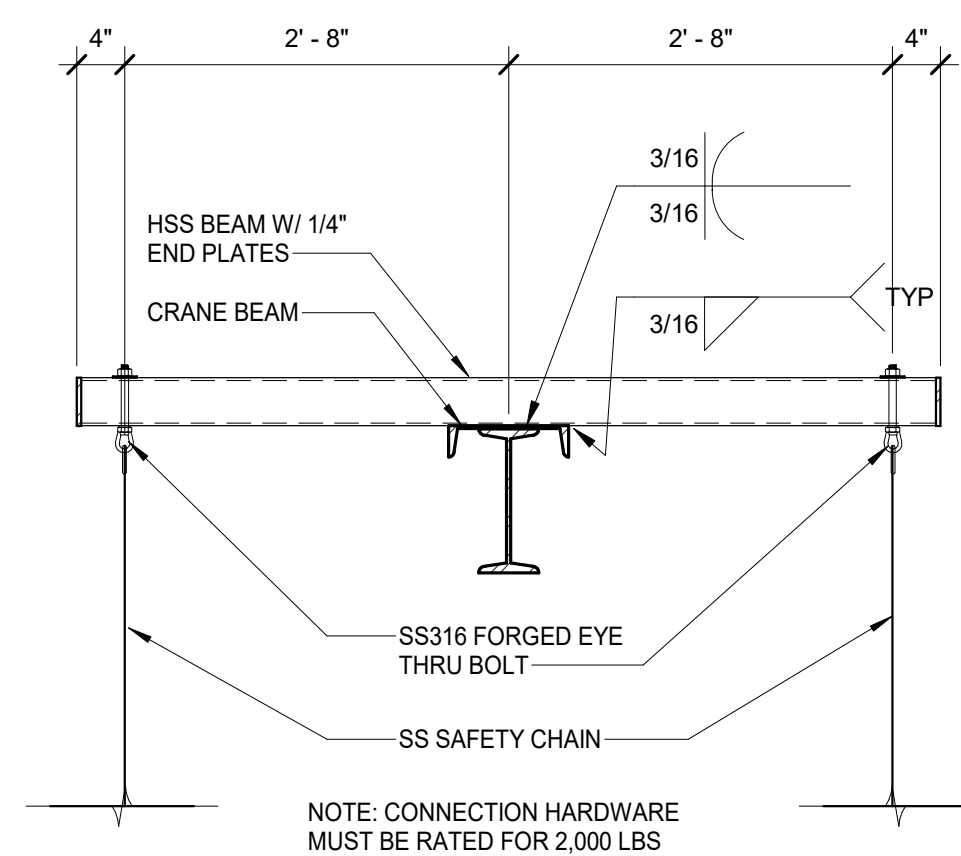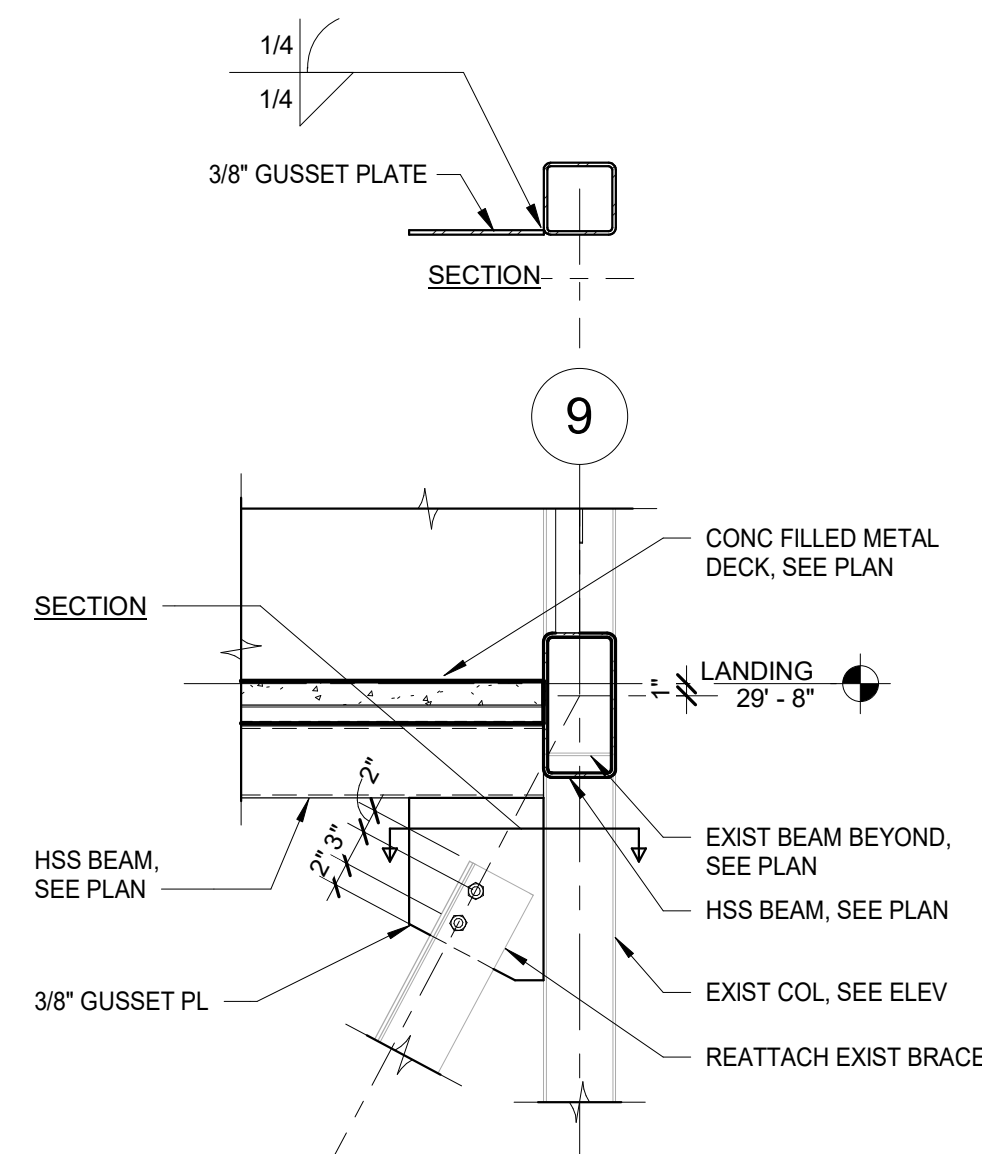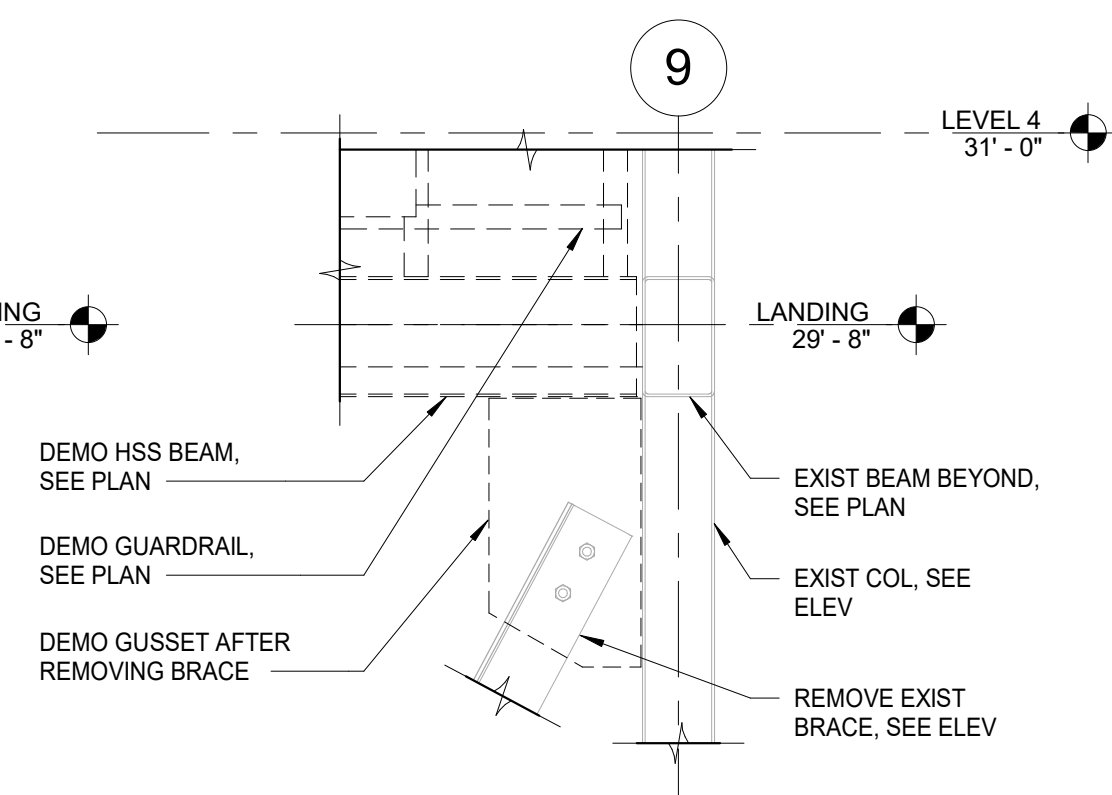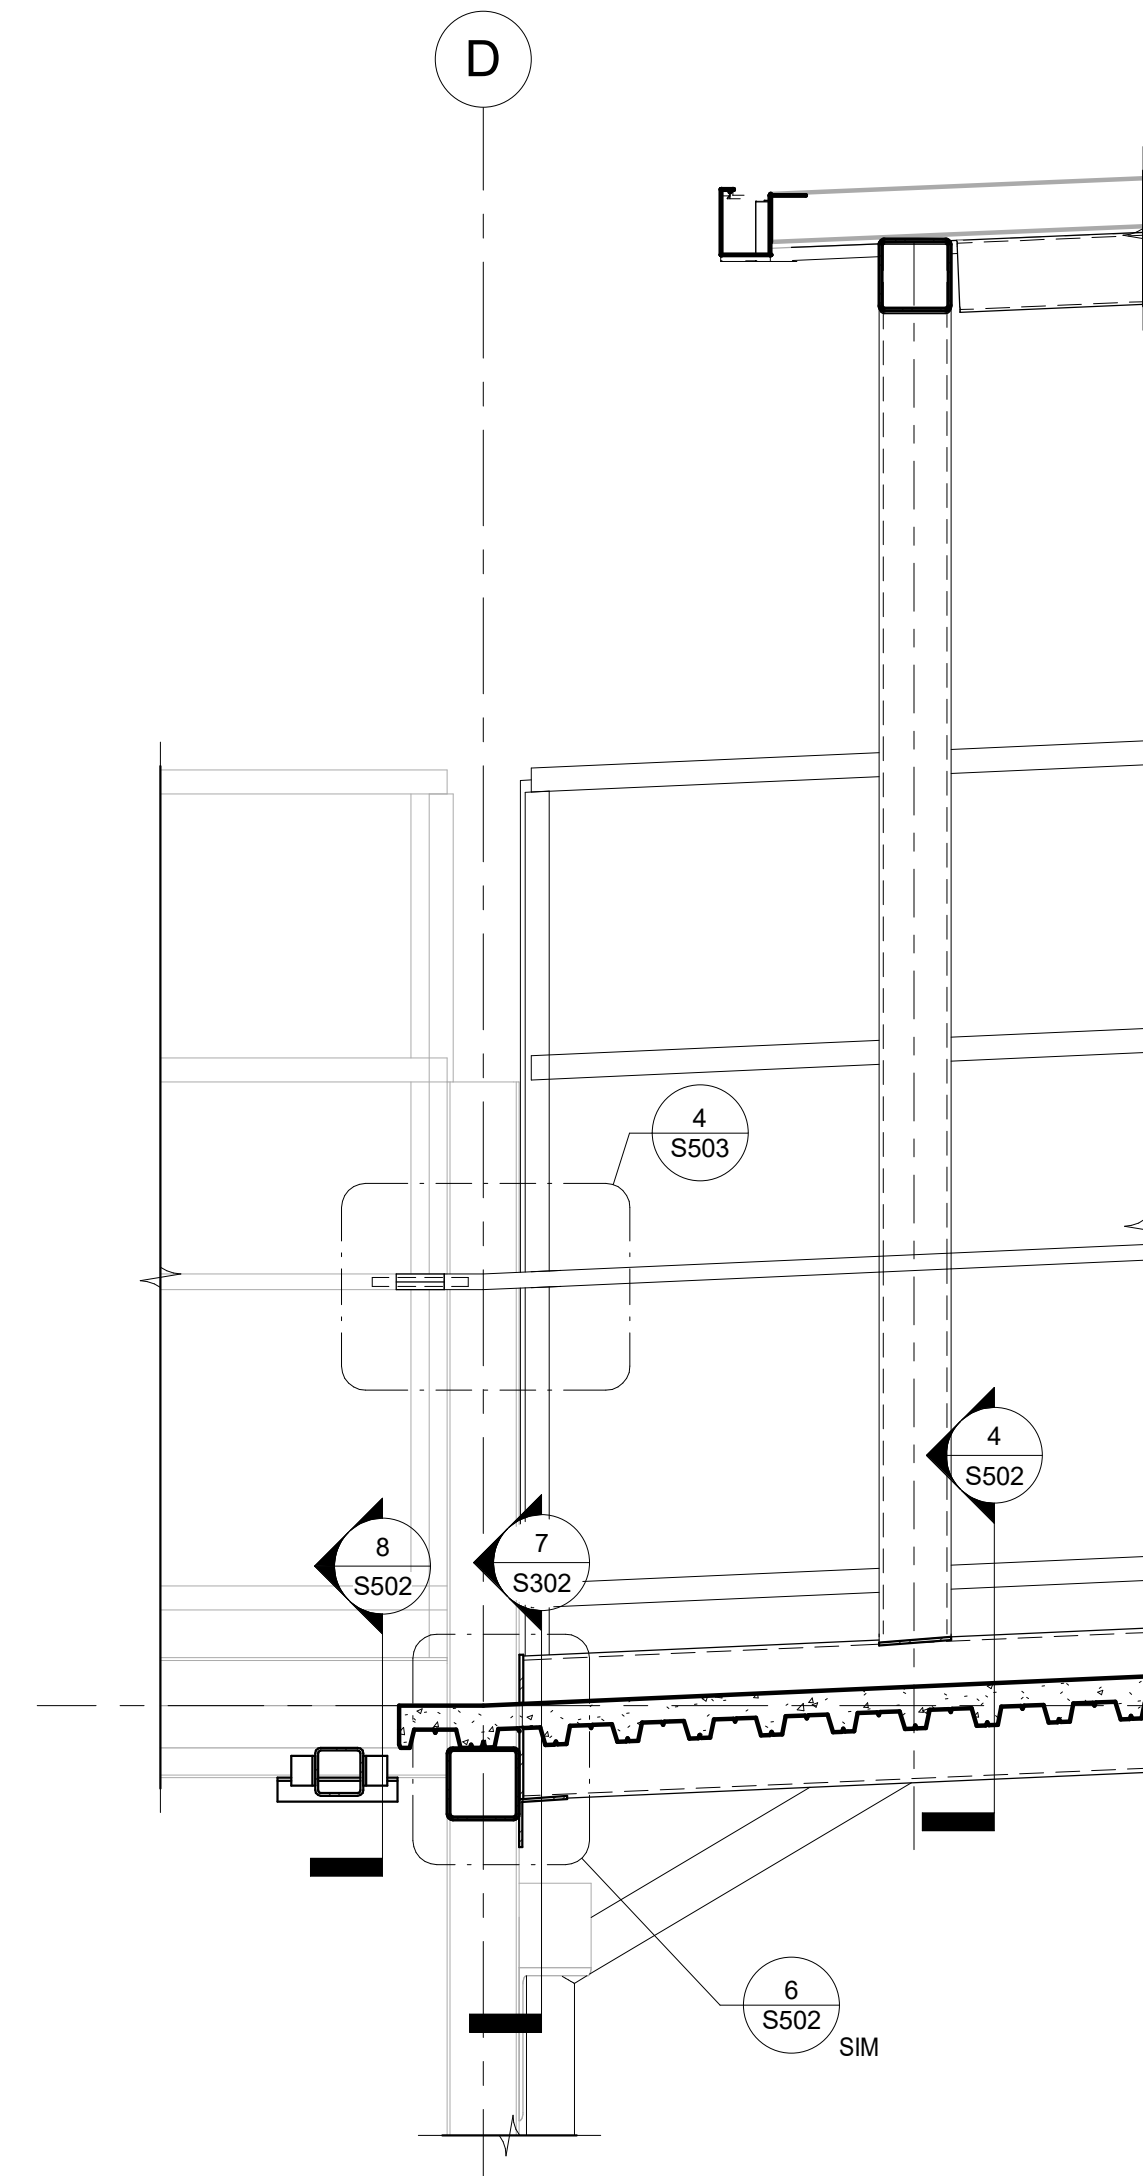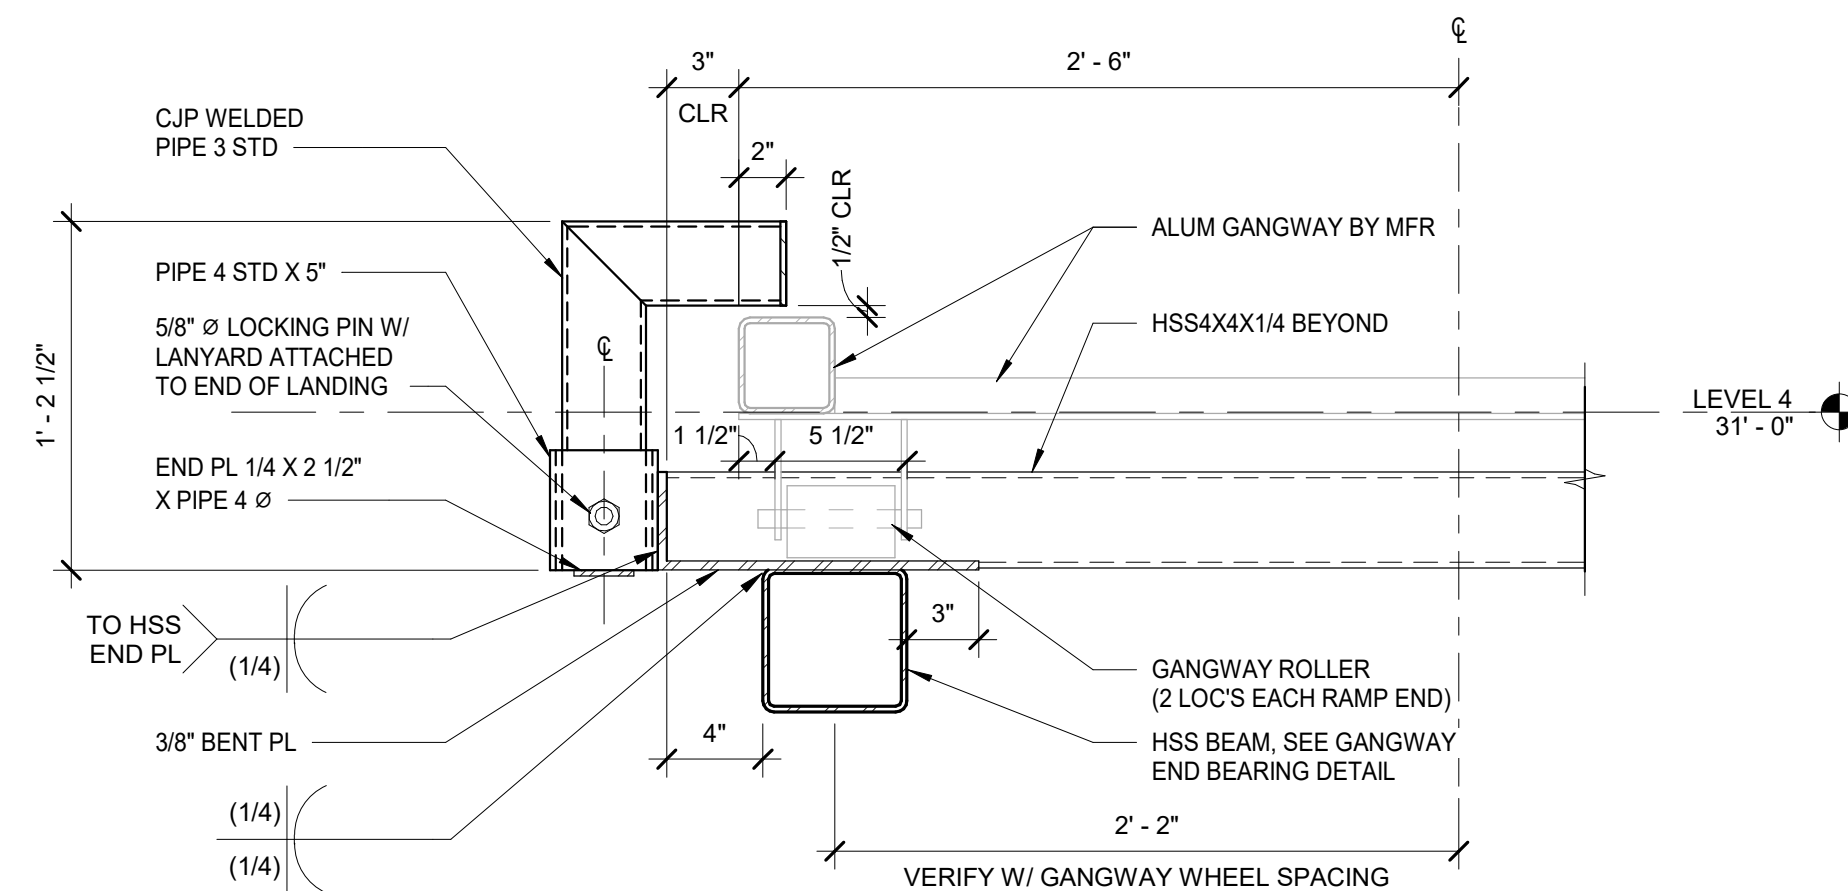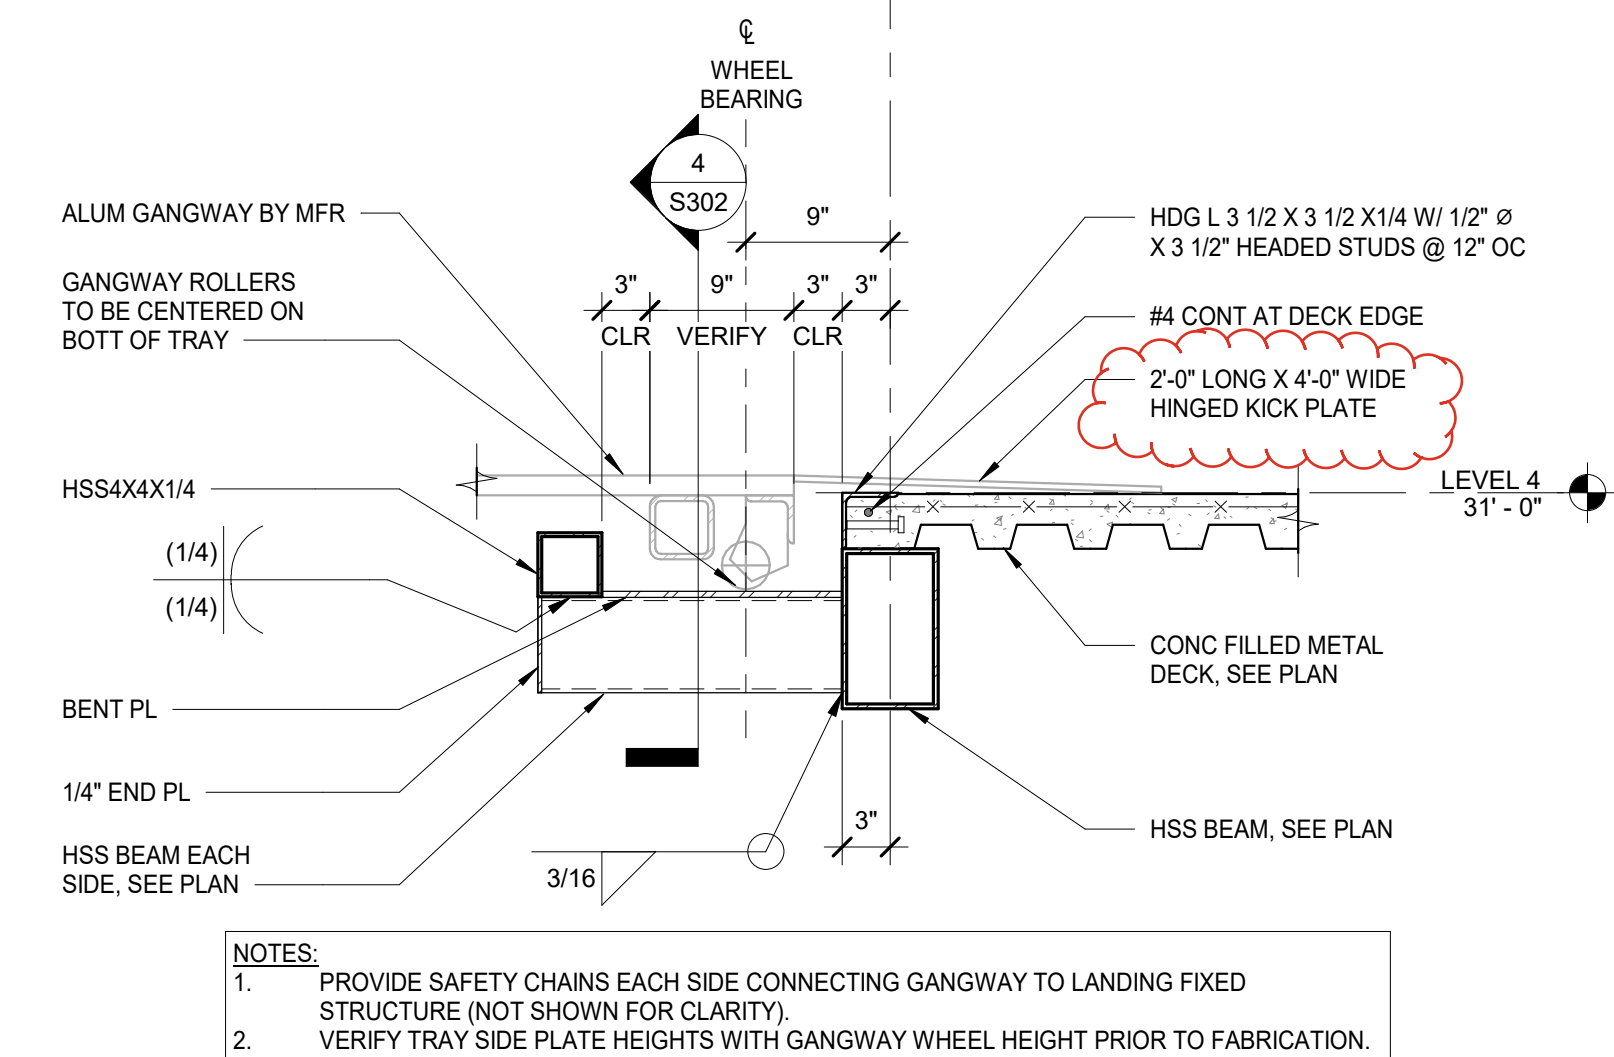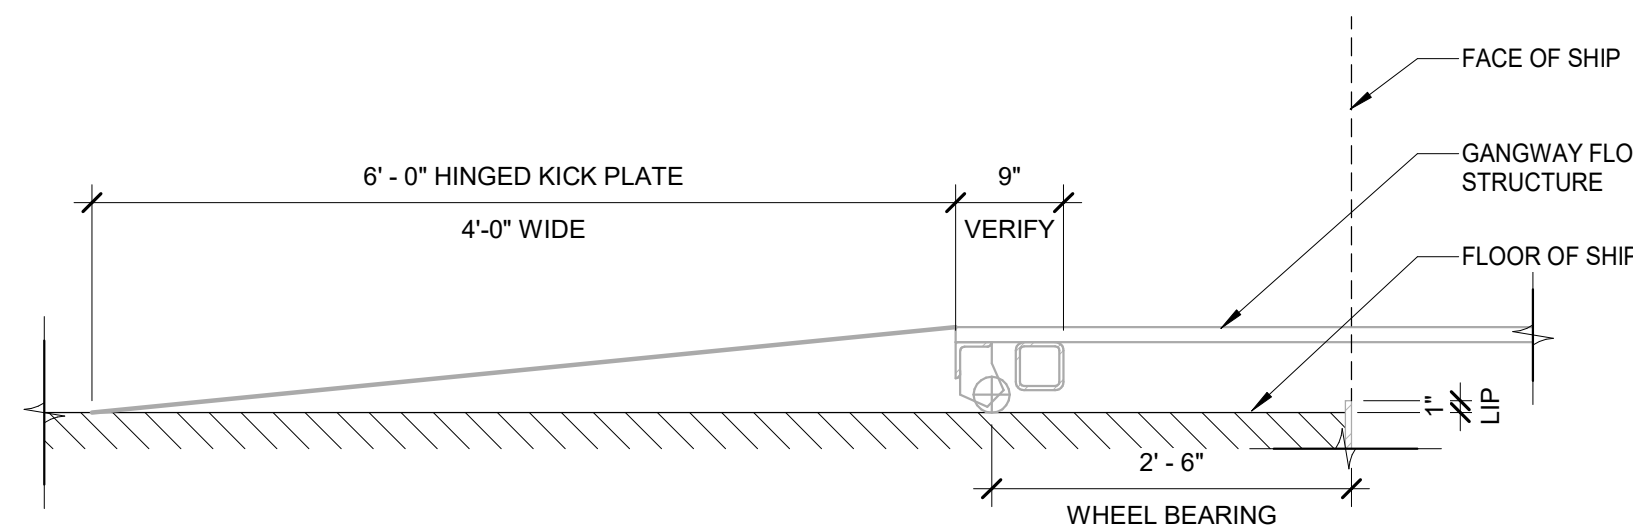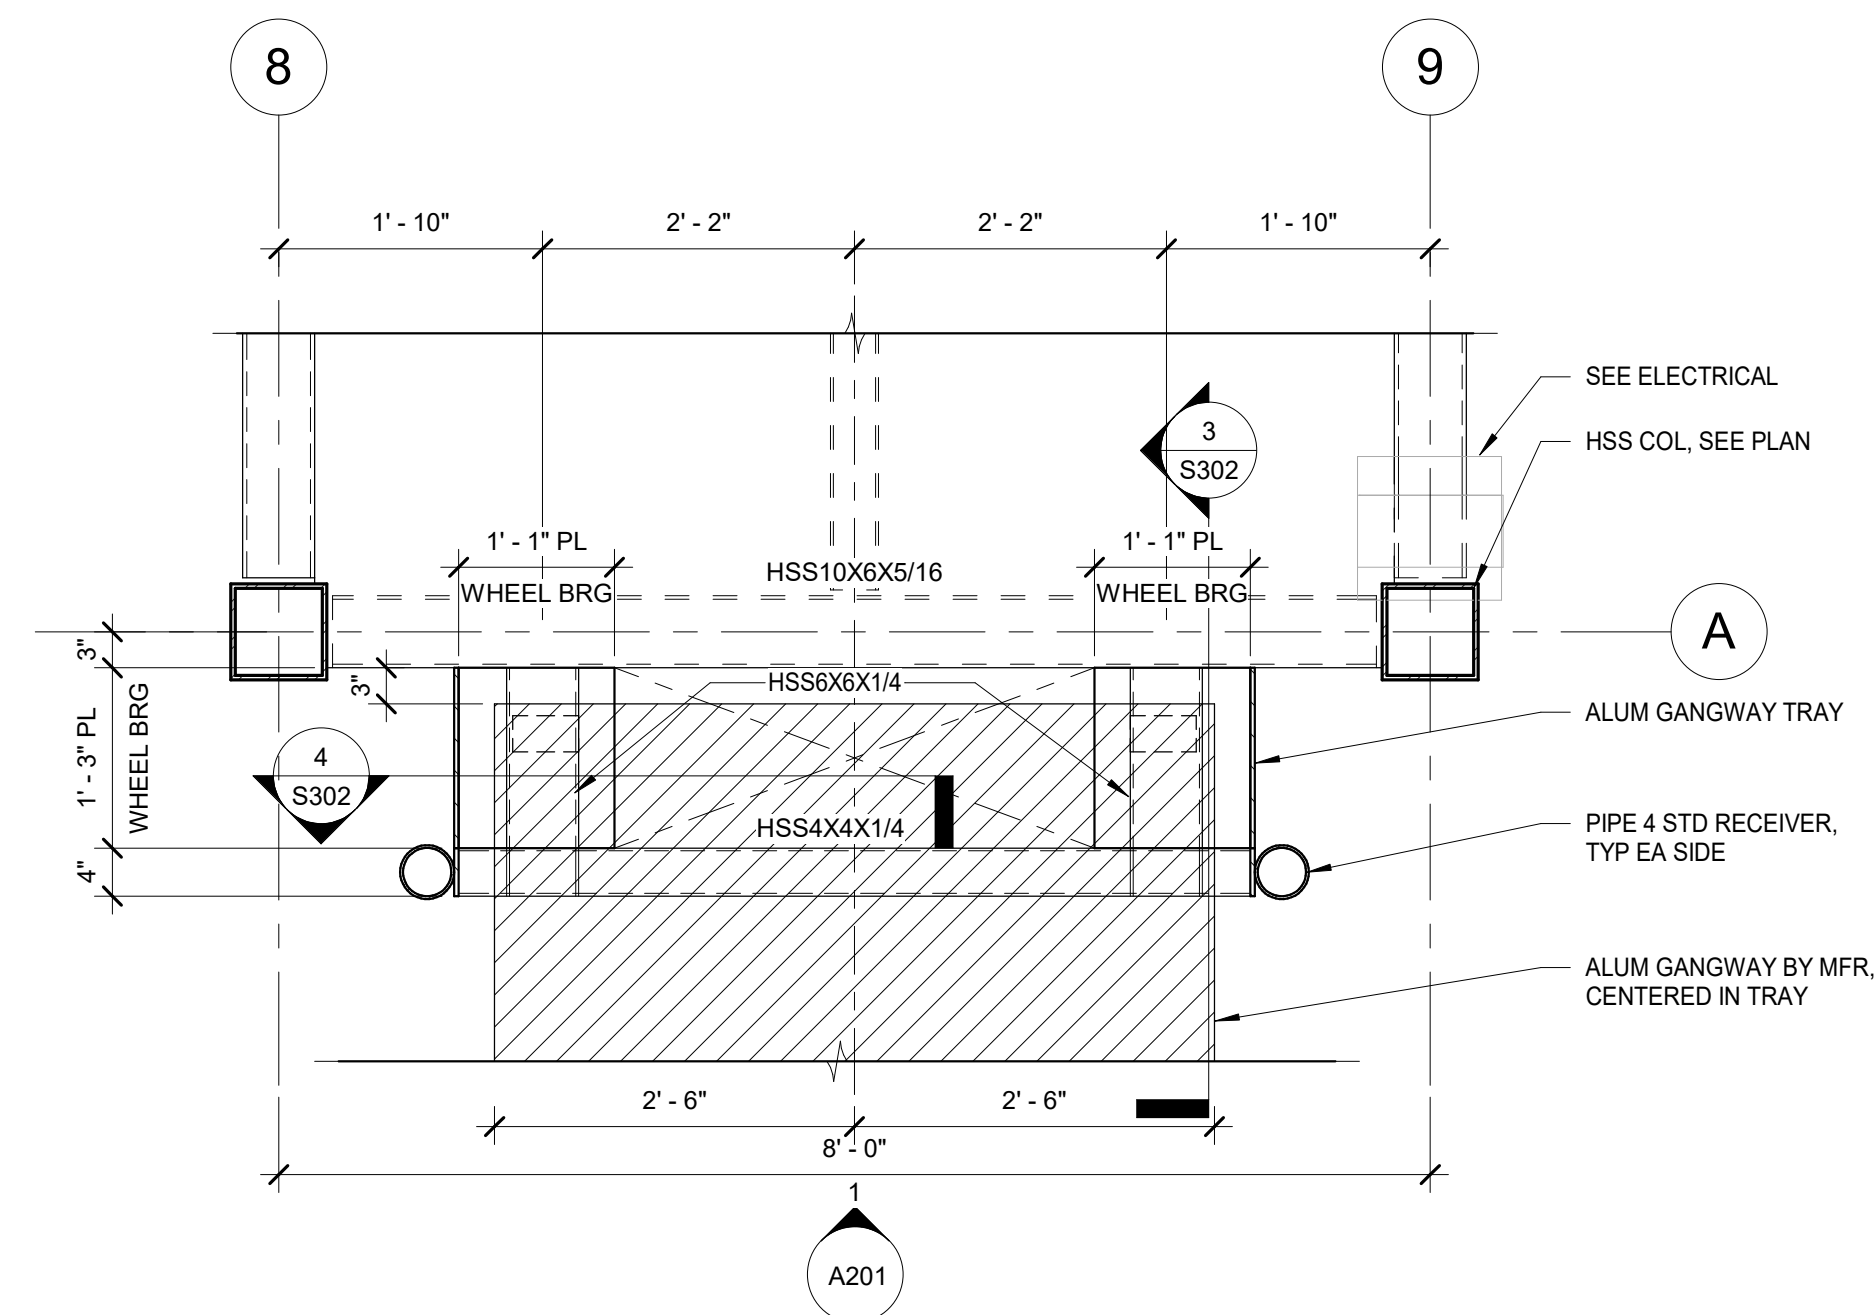

10748 Deerwood Park Blvd. South
Jacksonville, Florida 32256-0597
904-256-2500 Fax 904-256-2503
www.rsandh.com
FL Cert. Nos. AAC001886 * IB26000956 *
5620 * LCC000210 * GB238




PROJECT TITLE:
JAXPORT CRUISE TERMINAL
GANGWAY MODIFICATION

PROJECT ADDRESS:
9810 AUGUST DRIVE
JACKSONVILLE, FL 32226

[illegible]

DATE ISSUED:	01/24/20
REVIEWED BY:	PI
DRAWN BY:	JL
DESIGNED BY:	L
PROJECT NUMBER:	10014153000

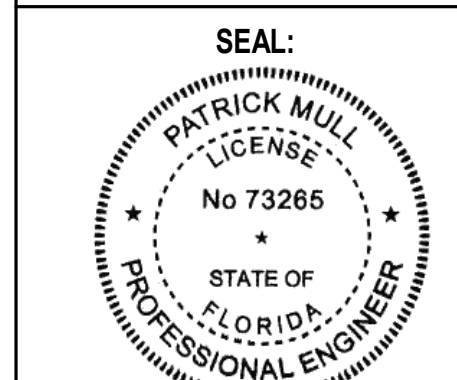


SHEET TITLE:
STRUCTURAL
SECTIONS - II


SHEET ID:

S302

PROJECT STATUS:
100% SUBMITTAL
FOR CONSTRUCTION

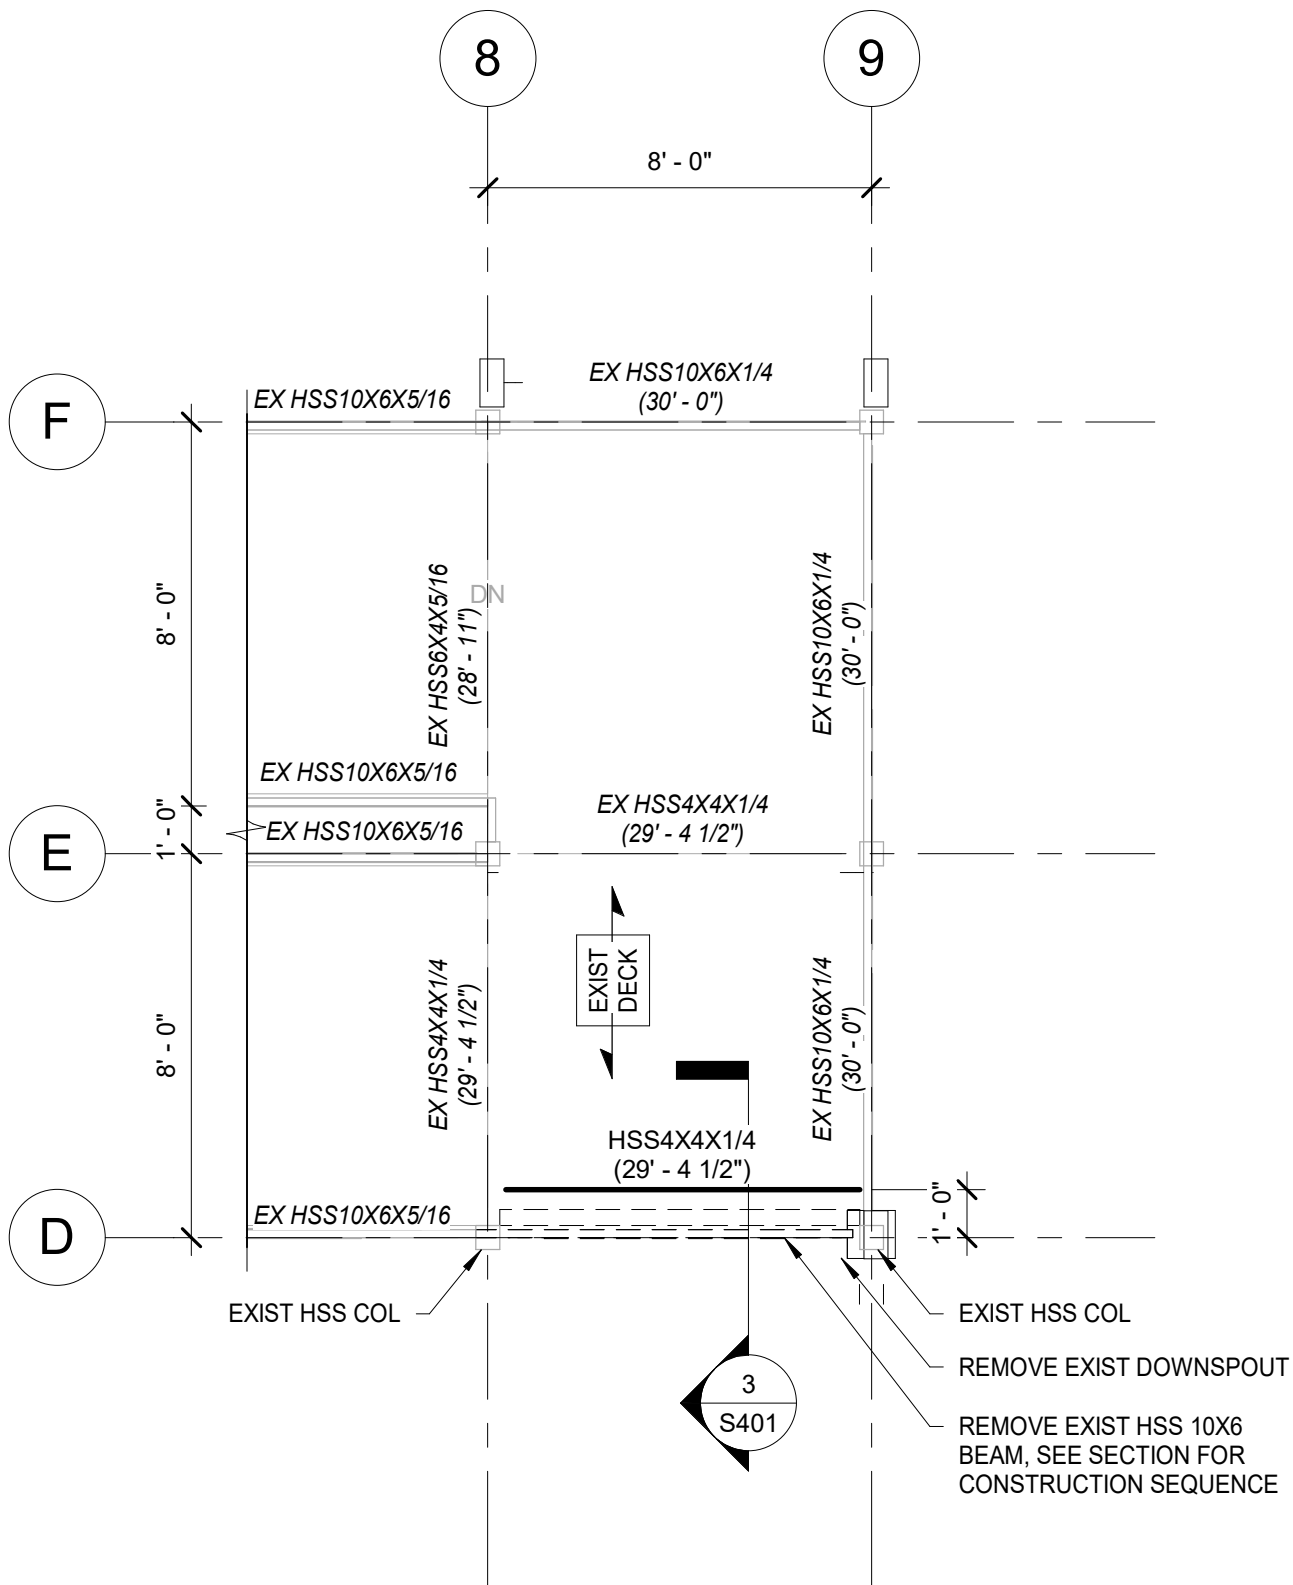


1
S401 ENLARGED LANDING DEMO PLAN - EL. 29'-8"
SCALE: 1/4" = 1'-0"

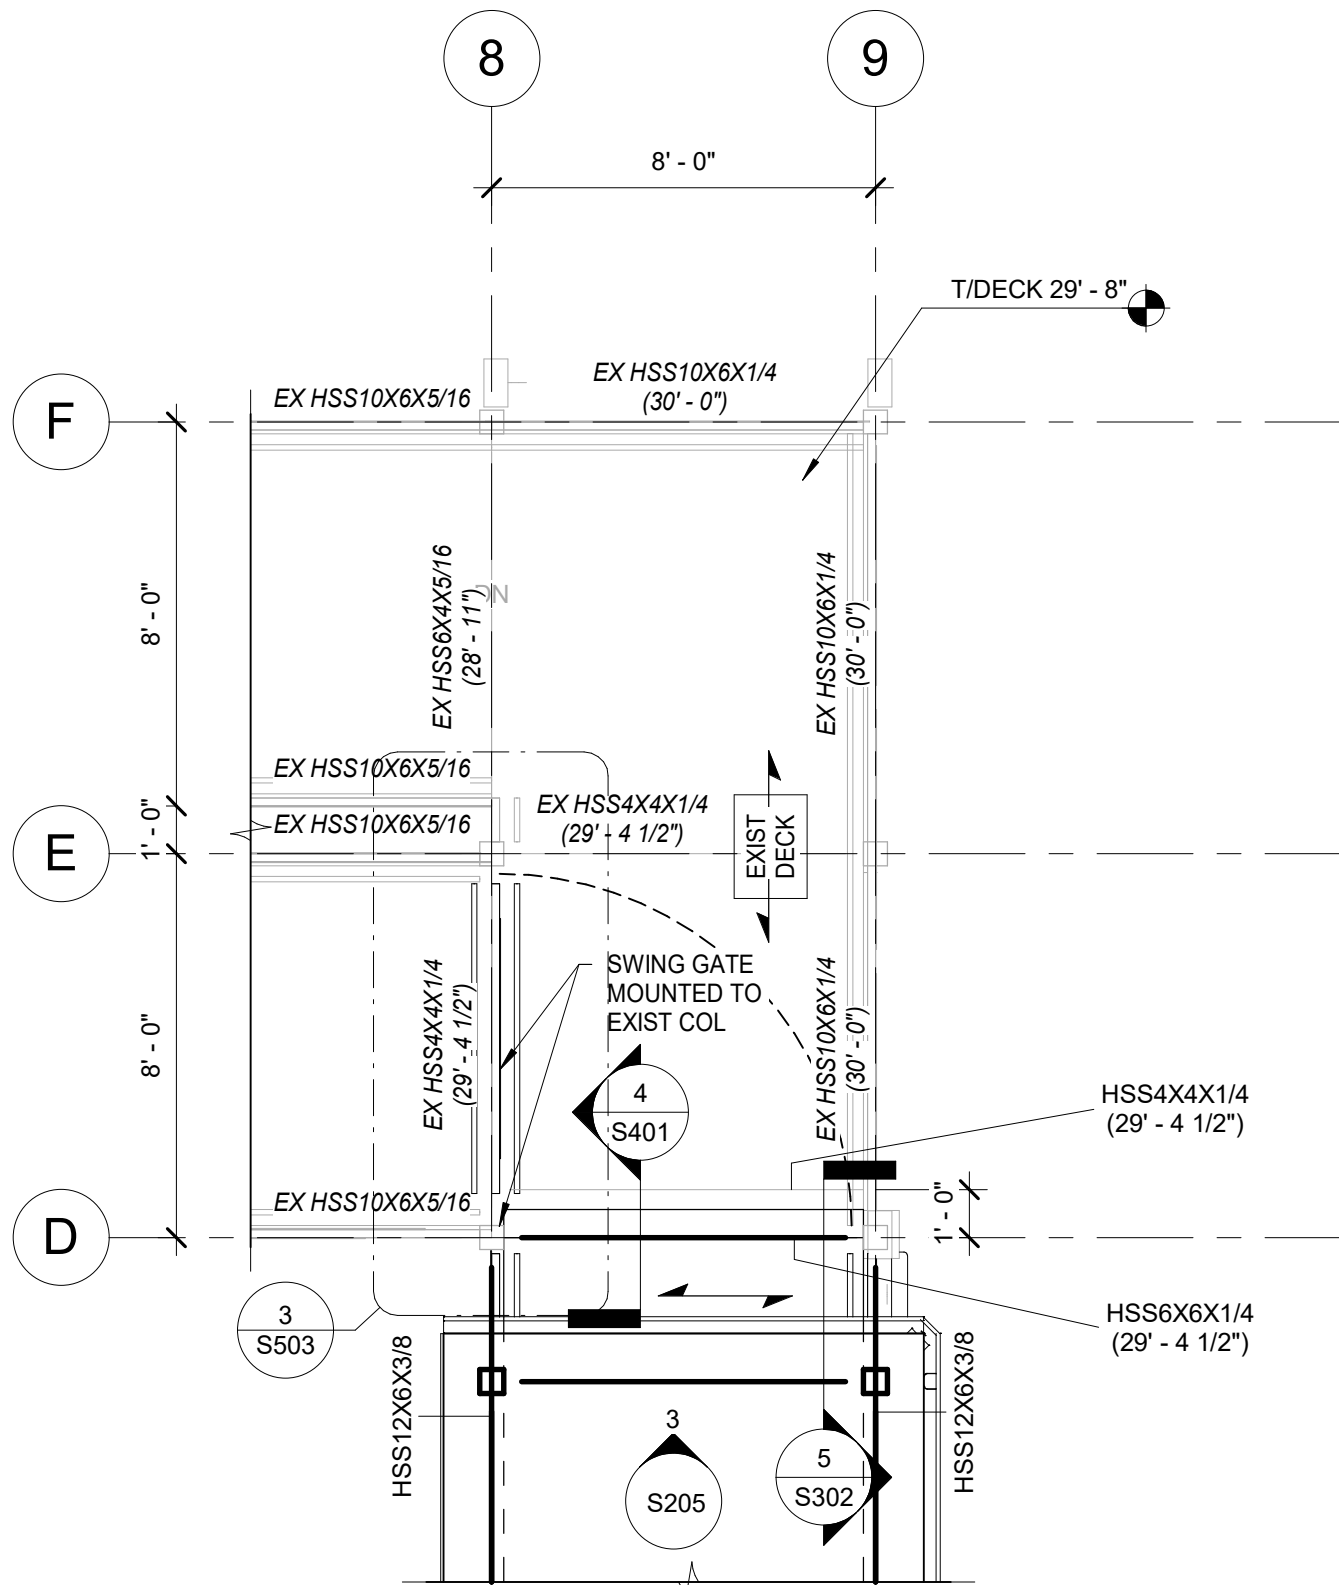


2
S401 ENLARGED LANDING PLAN - EL. 29'-8"
SCALE: 1/4" = 1'-0"

ENLARGED LANDING PLAN NOTES:


- INDICATES FLOOR METAL DECK SPAN DIRECTION. SEE SHEET S012 FOR DECK NOTES.
- (X'-X") INDICATES T/STL BEAM ELEVATION
- T/STL STRINGER IS +4" FROM T/DECK.
 - FOR LANDING DIMENSIONS AND ELEVATIONS, SEE FRAMING PLANS.
 - FOR TYPICAL CONNECTIONS, SEE SHEET S502 & S503.

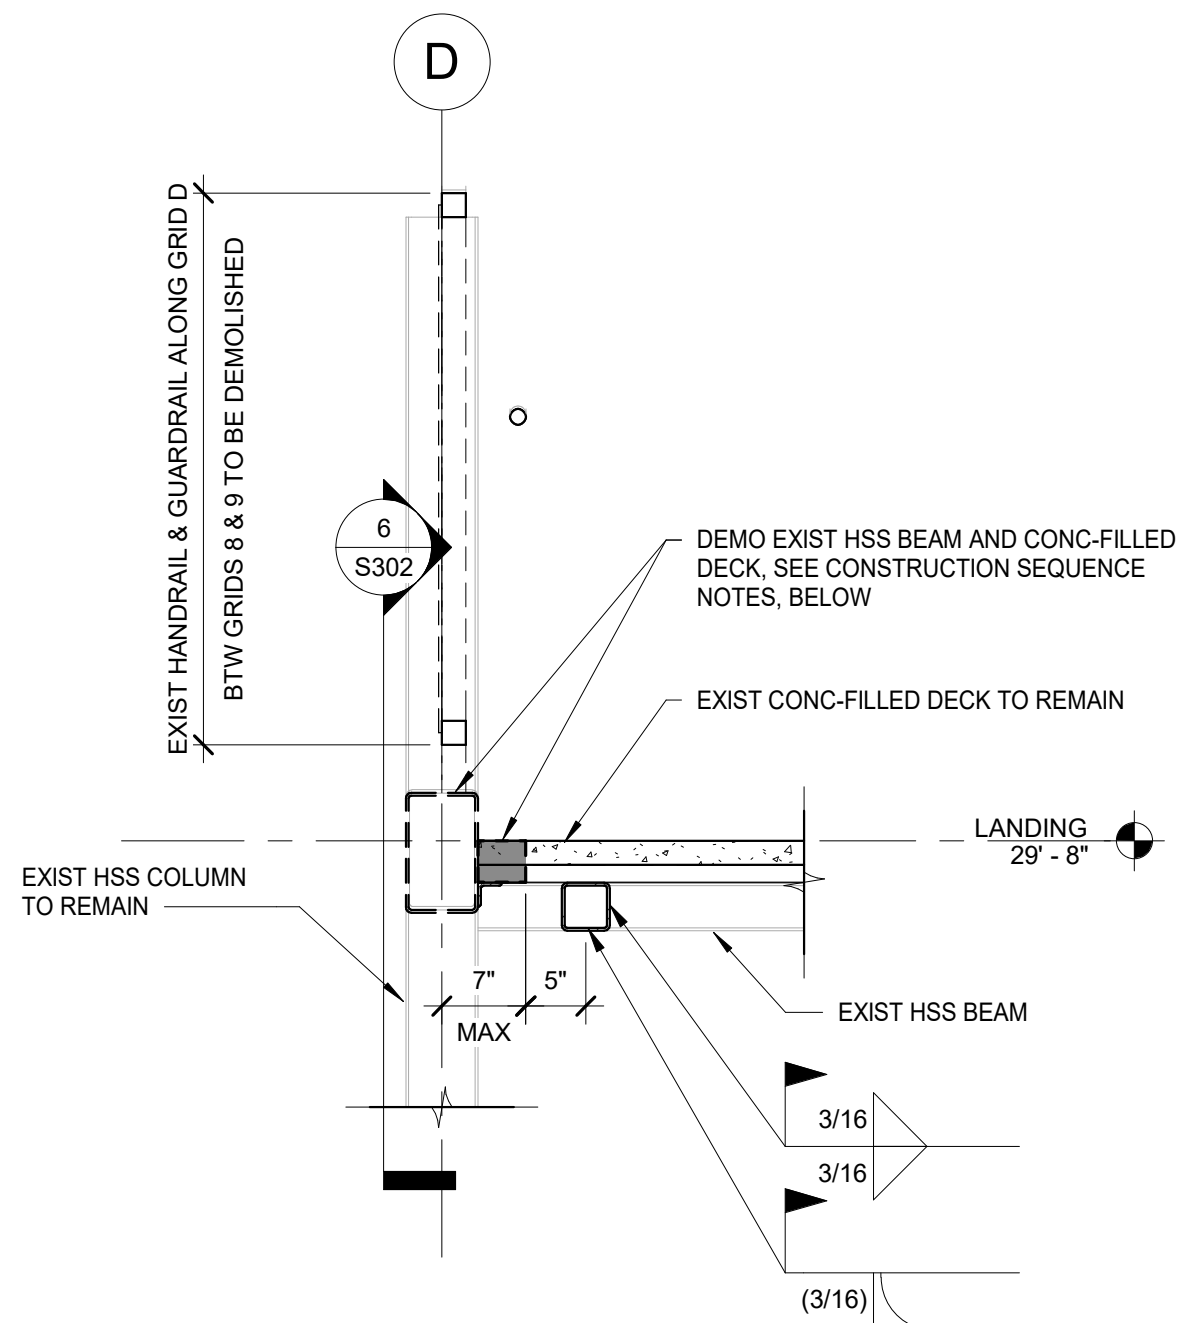


3
S401 LANDING DEMO SECTION
SCALE: 3/4" = 1'-0"

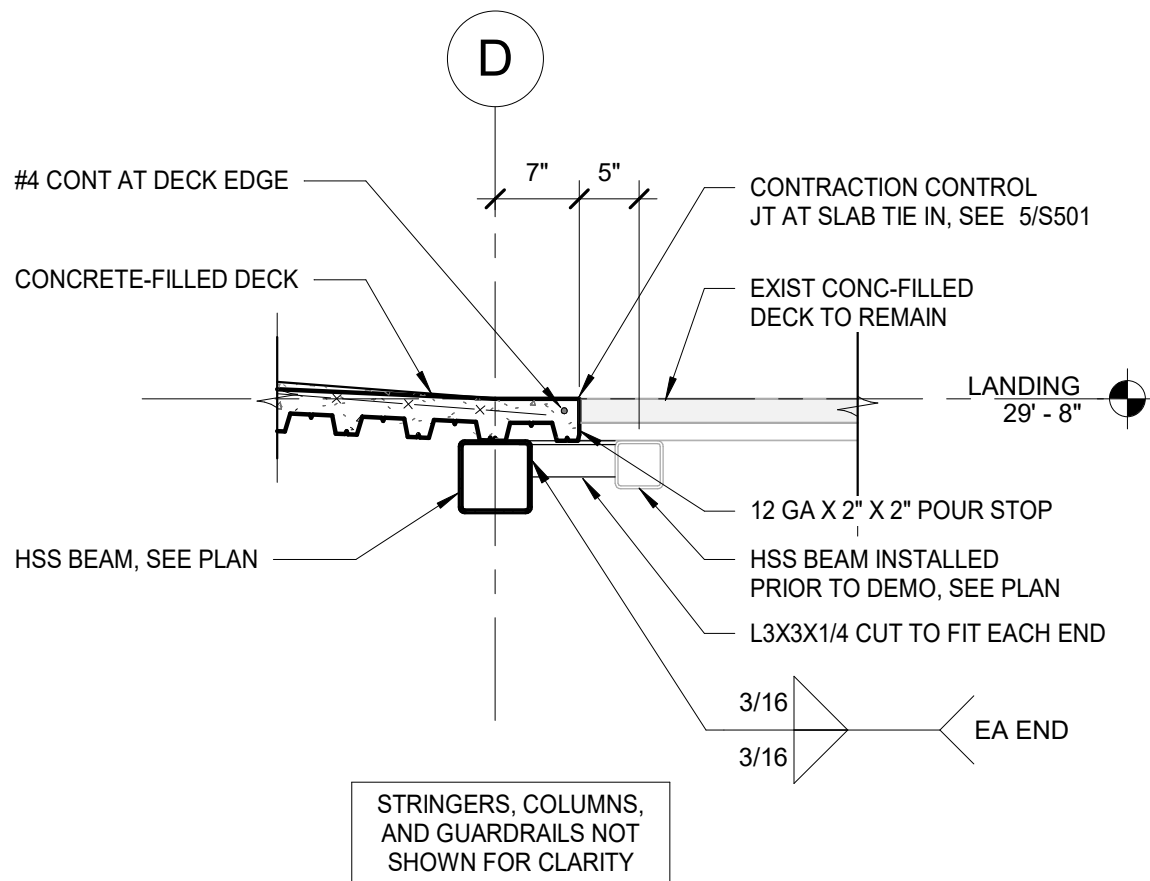

4
S401 LANDING SECTION
SCALE: 3/4" = 1'-0"

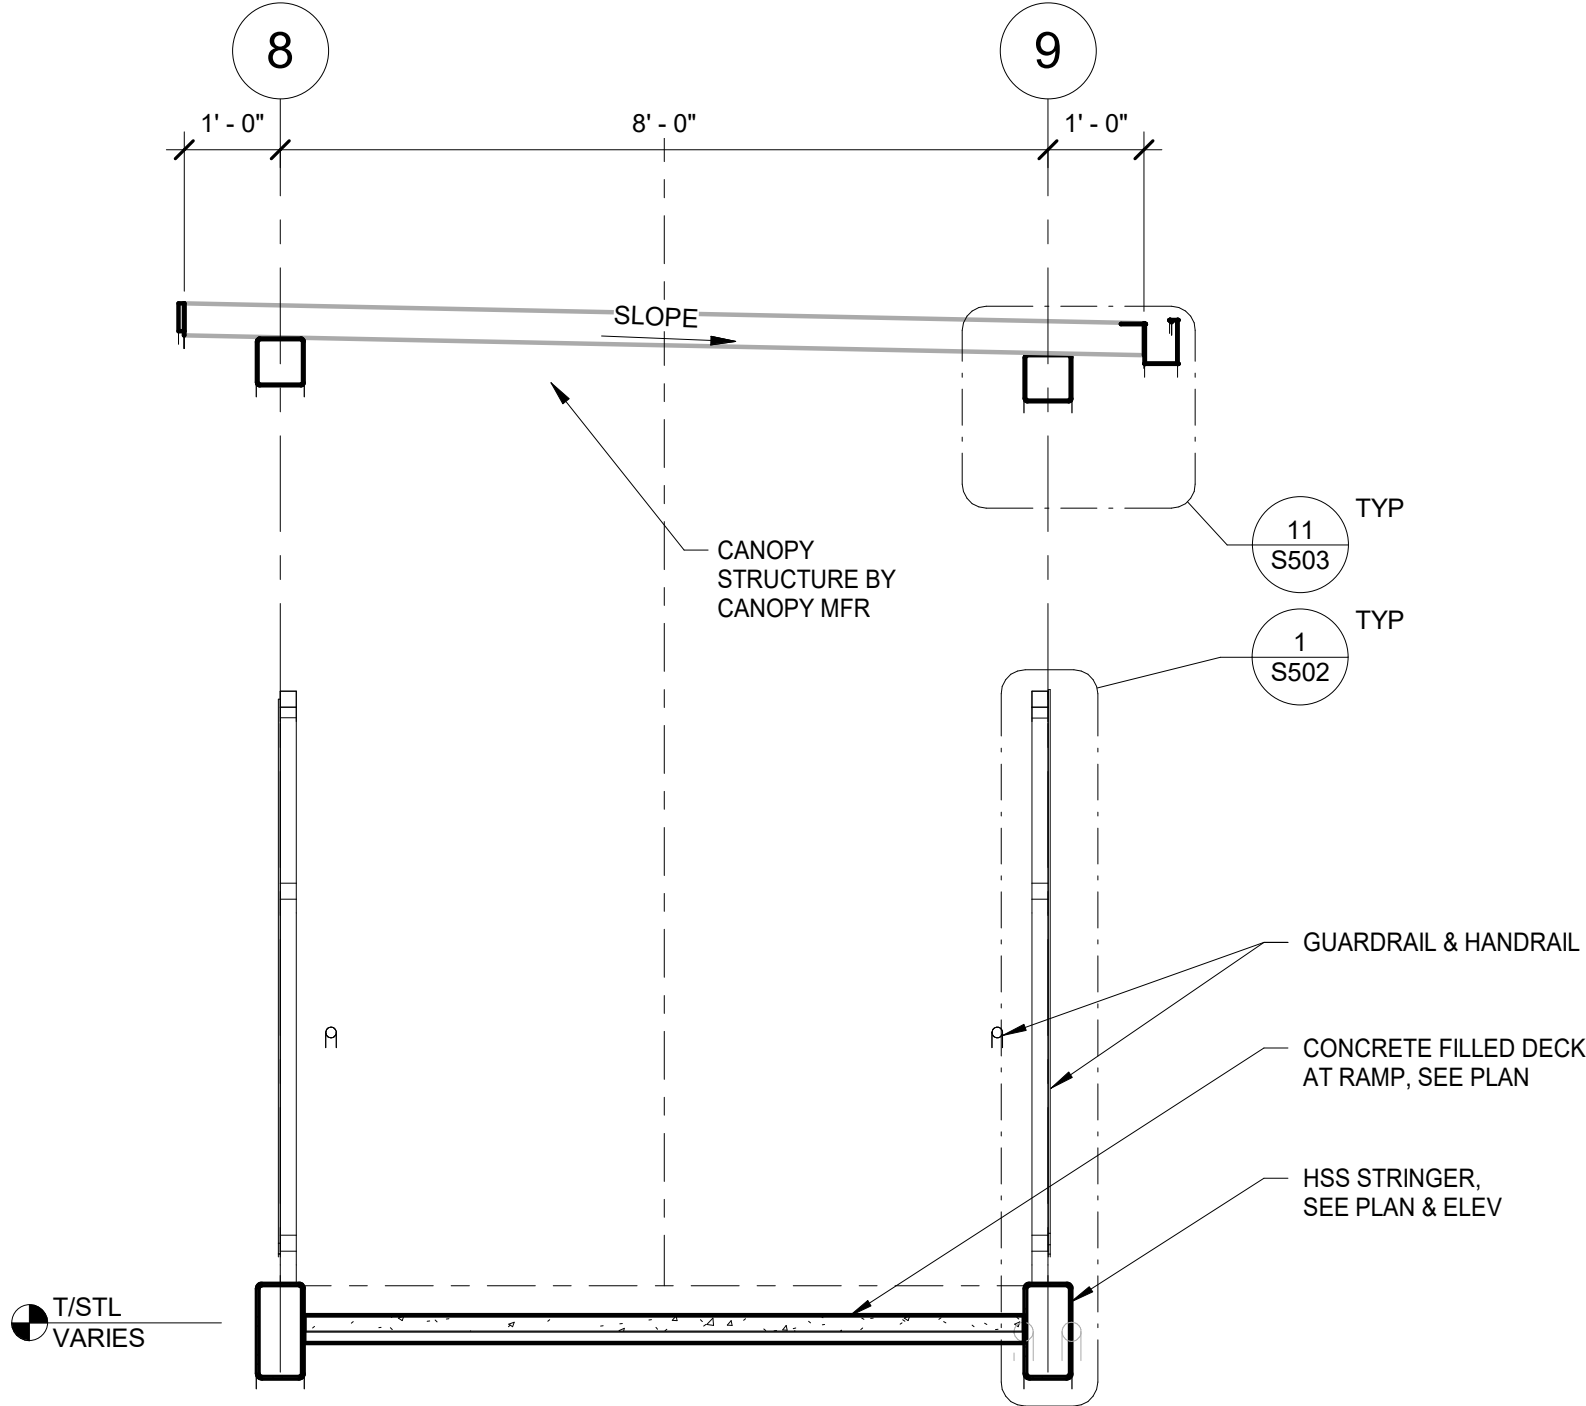

5
S401 TYPICAL RAMP SECTION
SCALE: 1/2" = 1'-0"

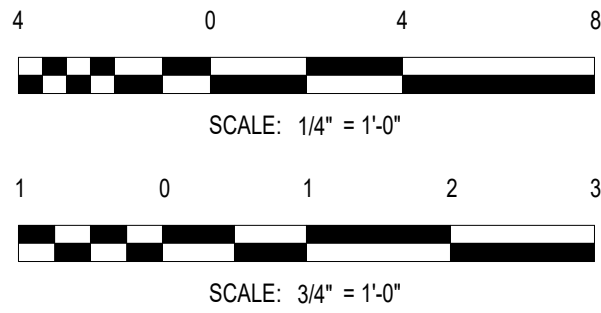

10748 Deerwood Park Blvd. South
Jacksonville, Florida 32256-0597
904-256-2500 Fax 904-256-2503
www.rsandh.com
FL Cert. Nos. AAC001886 * IB26000956 *
5620 * LCC000210 * GB238

JACKSONVILLE PORT AUTHORITY

PROJECT TITLE:
JAXPORT CRUISE TERMINAL
GANGWAY MODIFICATION

PROJECT ADDRESS:
9810 AUGUST DRIVE
JACKSONVILLE, FL 32226

REVISIONS		
NO.	DESCRIPTION	DATE

DATE ISSUED: 01/24/2025
REVIEWED BY: PFM
DRAWN BY: JAM
DESIGNED BY: LAP
PROJECT NUMBER: 10014153000

SEAL:


PATRICK MULL
LICENSE
No 73265
STATE OF FLORIDA
PROFESSIONAL ENGINEER

SHEET TITLE:
ENLARGED LANDING
PLANS


SHEET ID:

S401


PROJECT STATUS:
100% SUBMITTAL
FOR CONSTRUCTION

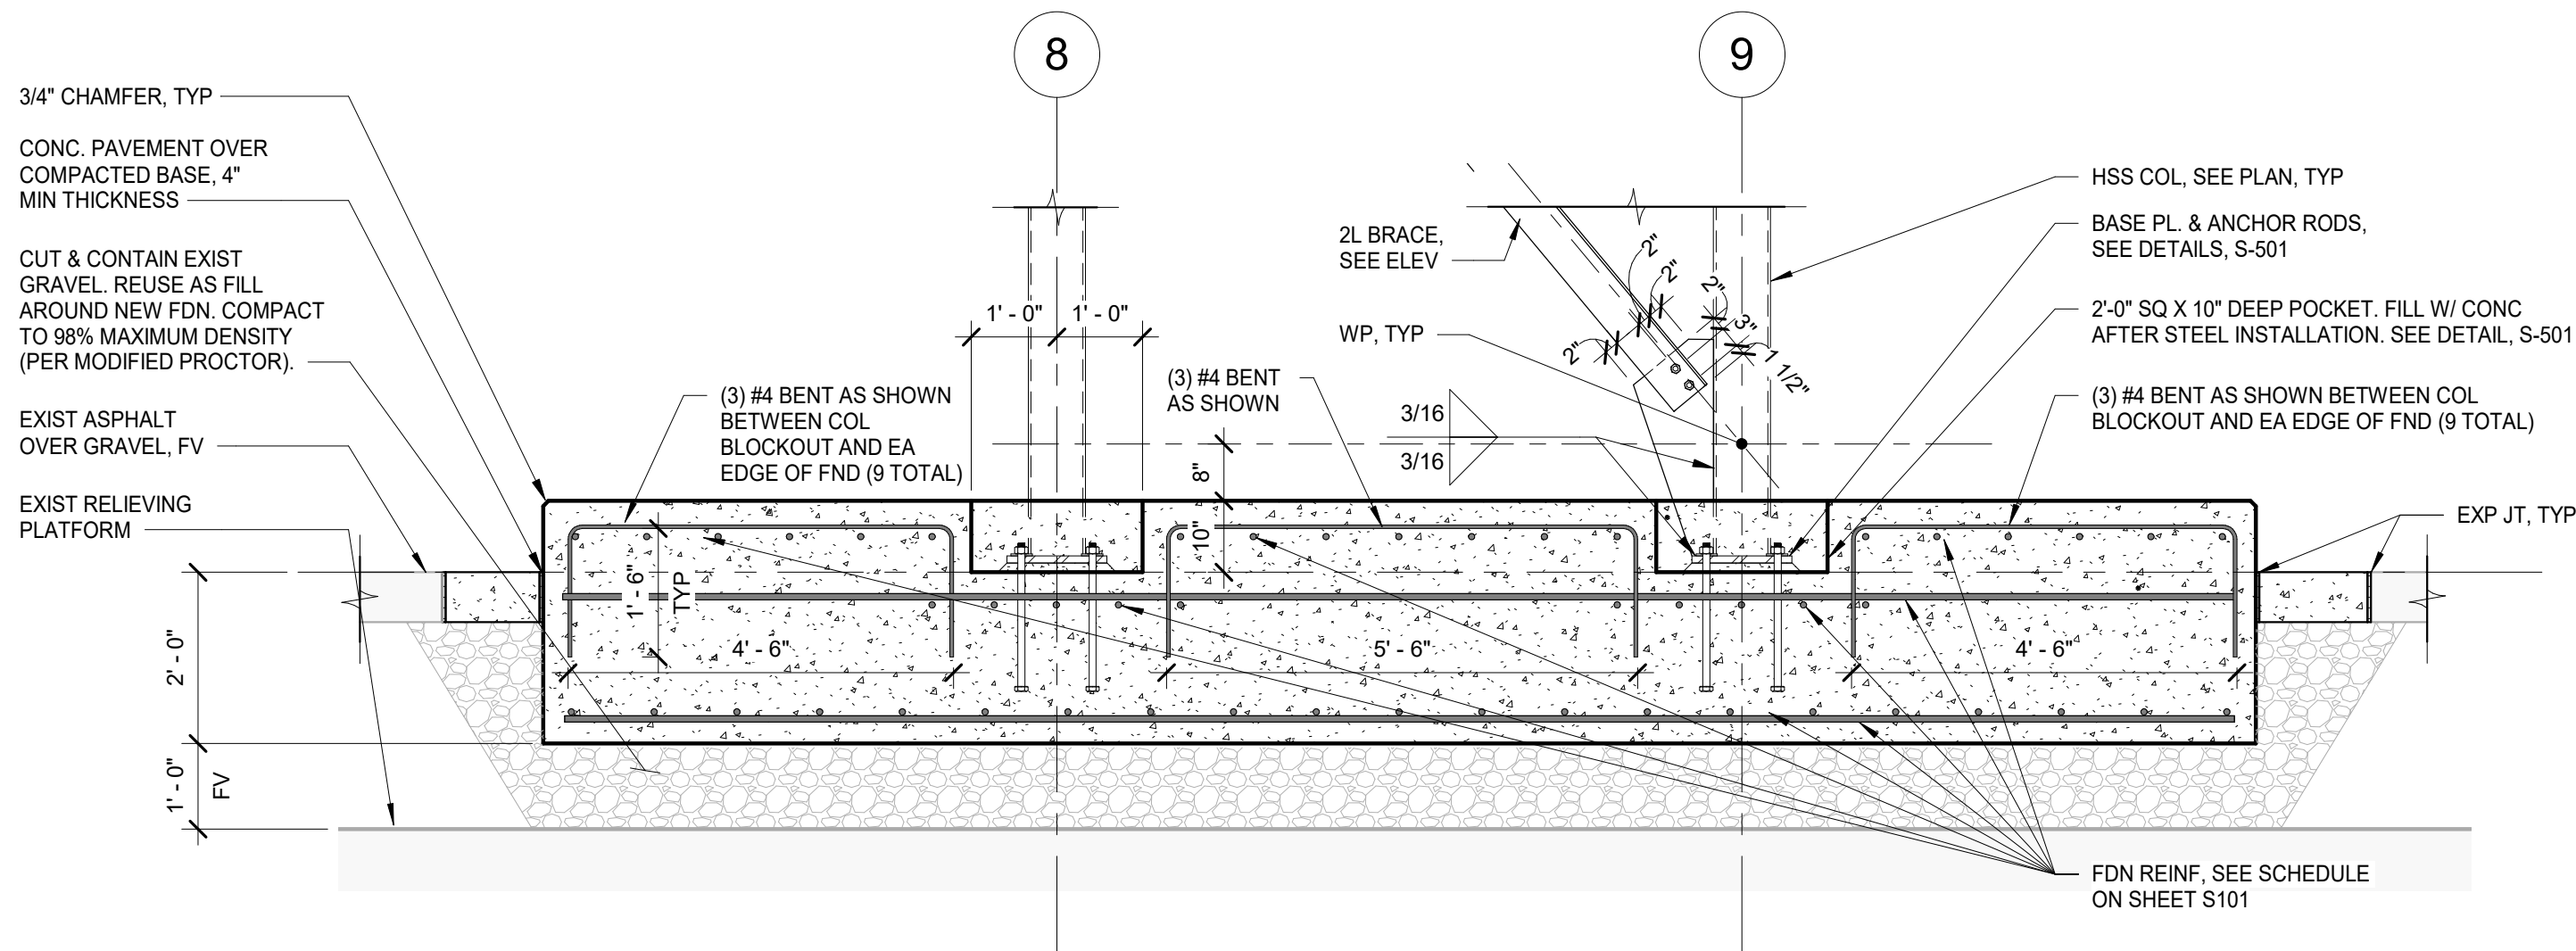


1
S501
RAMP FOUNDATION SECTION
SCALE: 1/2" = 1'-0"

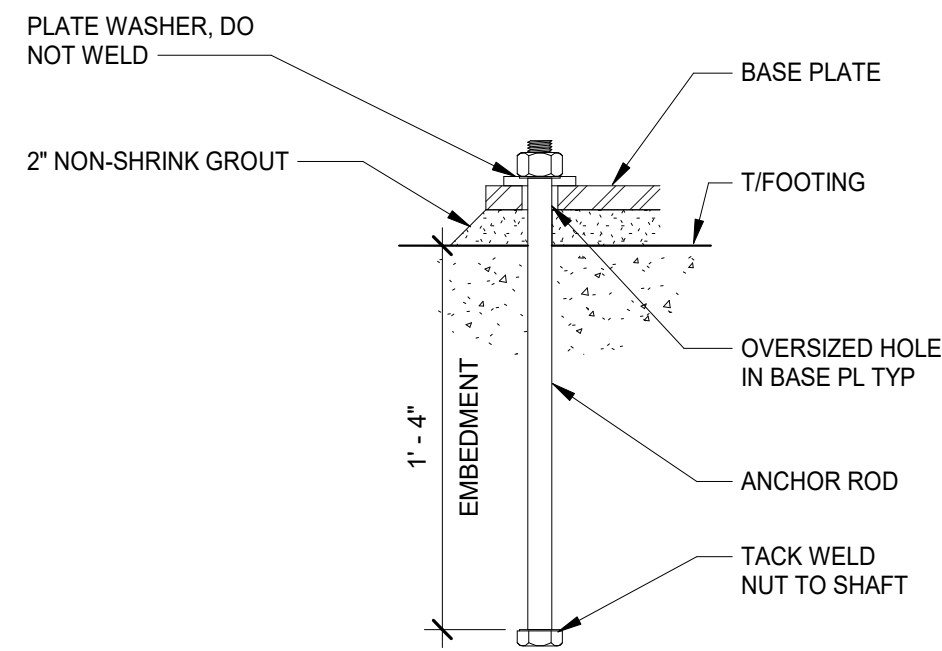


3
TYPICAL ANCHOR ROD DETAIL
SCALE: 1 1/2" = 1'-0"

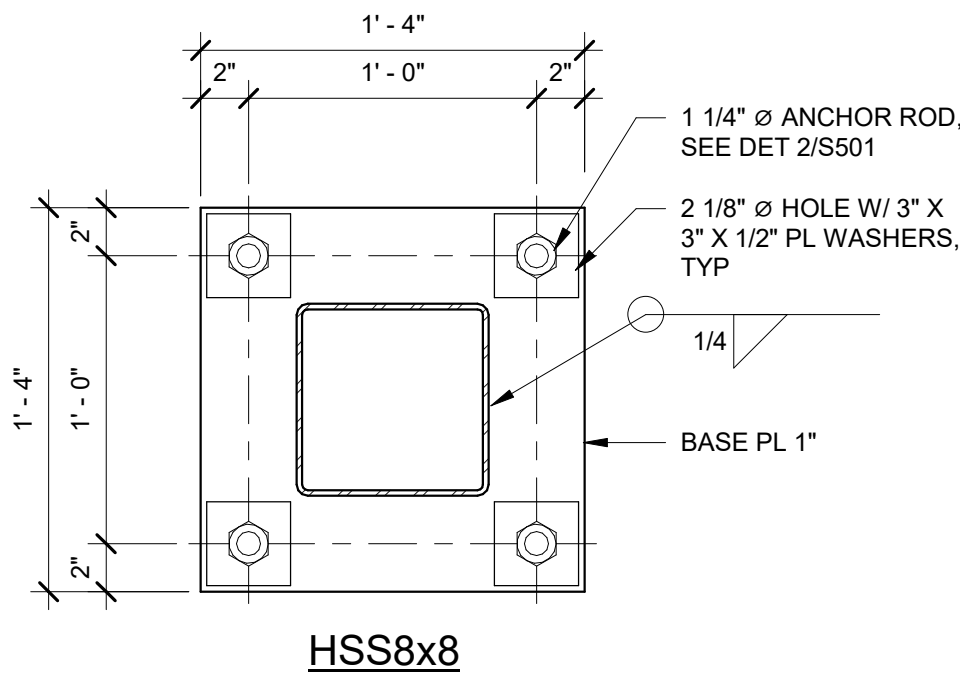

4
TYPICAL BASE PLATE DETAIL
SCALE: 1 1/2" = 1'-0"

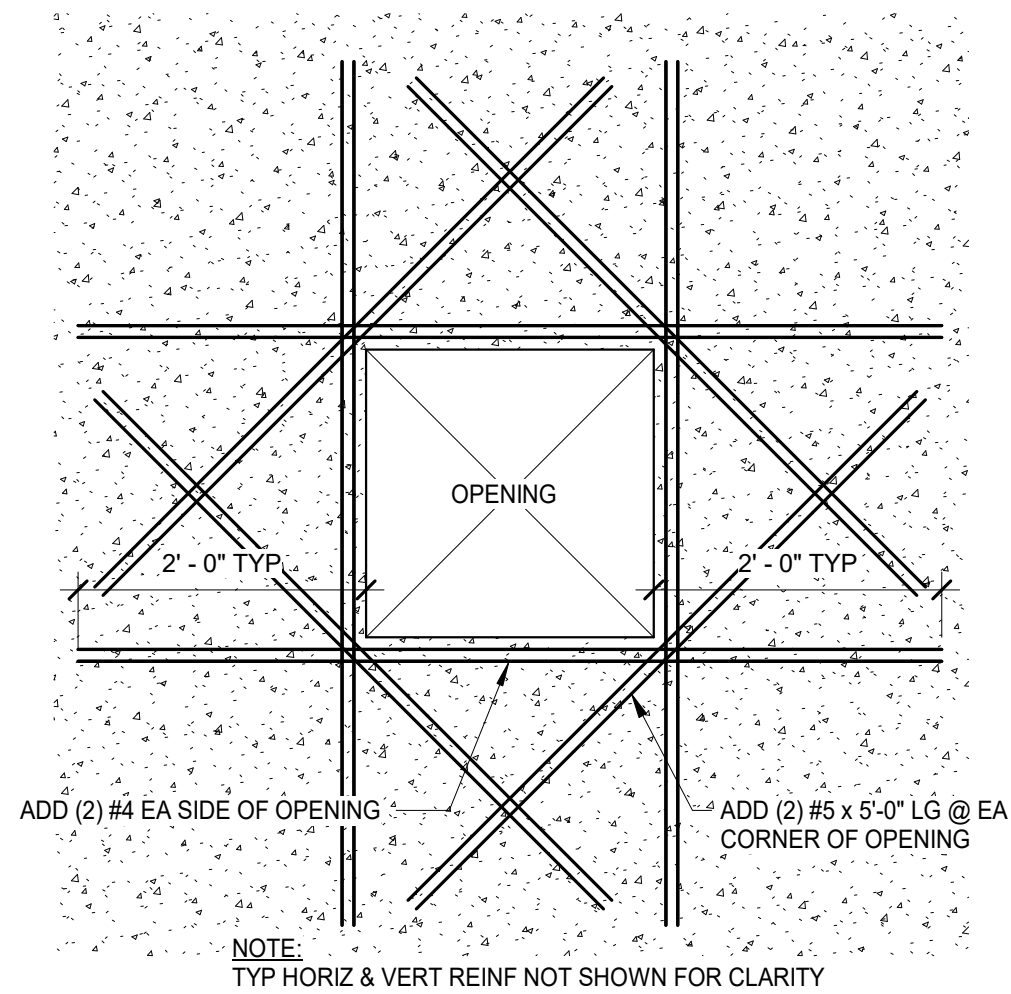


2
S501
TYP RECTANGULAR OPENING IN FOUNDATION
SCALE: 3/4" = 1'-0"

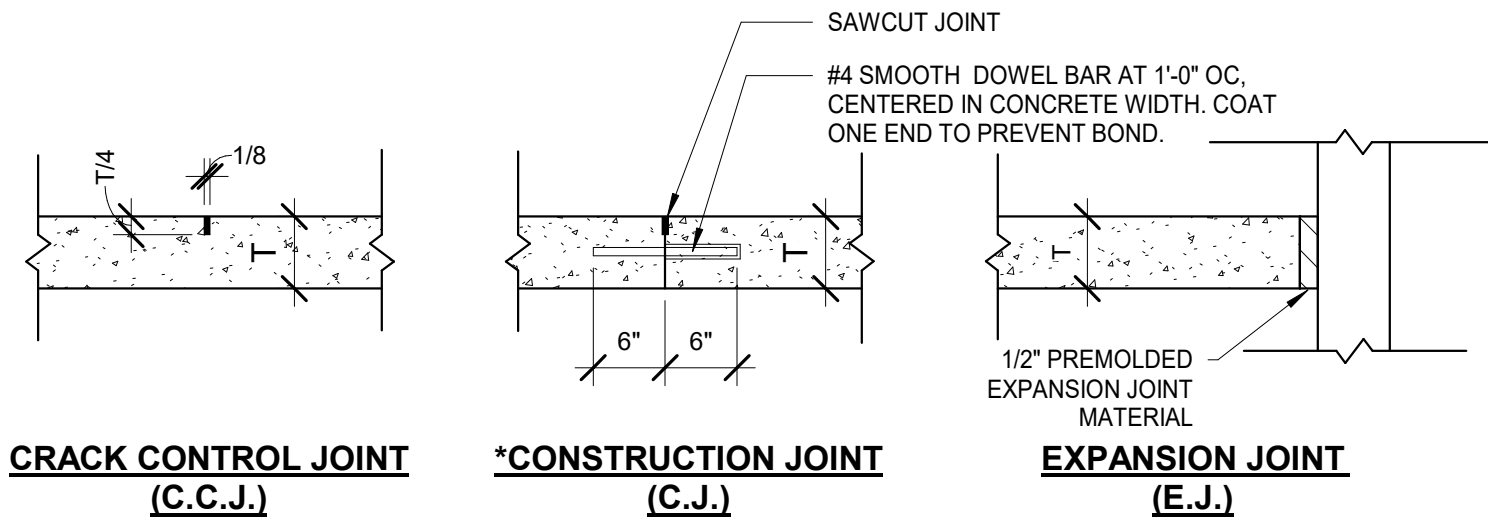

- NOTES:
1. CCJ MUST BE PREFORMED OR SAWED. IF SAWED, SAWING MUST TAKE PLACE WITHIN 12 HRS. OF SLAB PLACEMENT. MATCH LOCATIONS OF EXISTING CCJ'S.
 2. * USE INSTEAD OF CRACK CONTROL JOINT WHEREVER CONSTRUCTION IS STOPPED OR WHERE CALLED FOR ON PLAN.


5
SLAB JOINT DETAILS
SCALE: 3/4" = 1'-0"

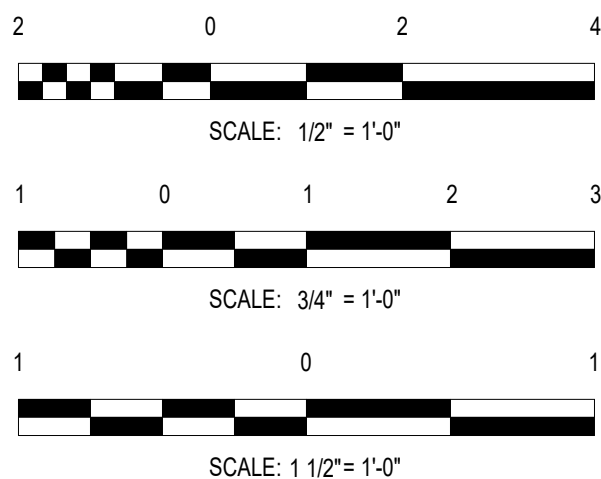

REVISIONS

NO.	DESCRIPTION	DATE

DATE ISSUED: 01/24/2025
REVIEWED BY: PFM
DRAWN BY: JAM
DESIGNED BY: LAP
PROJECT NUMBER:
10014153000










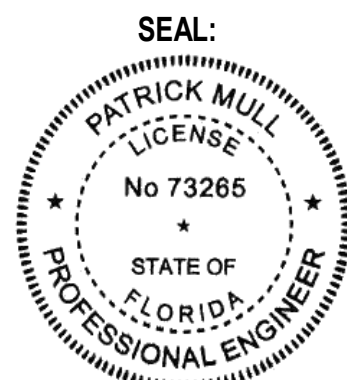


SHEET TITLE:
FOUNDATION
SECTIONS & DETAILS

SHEET ID:


S501

PROJECT STATUS:
100% SUBMITTAL
FOR CONSTRUCTION

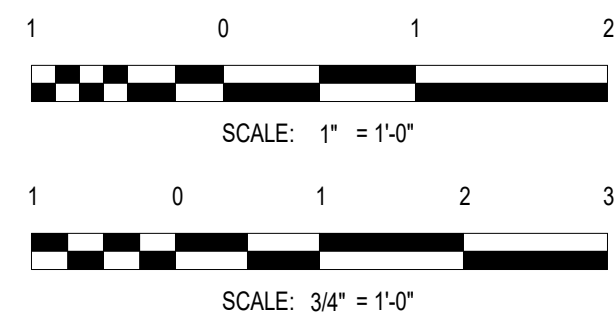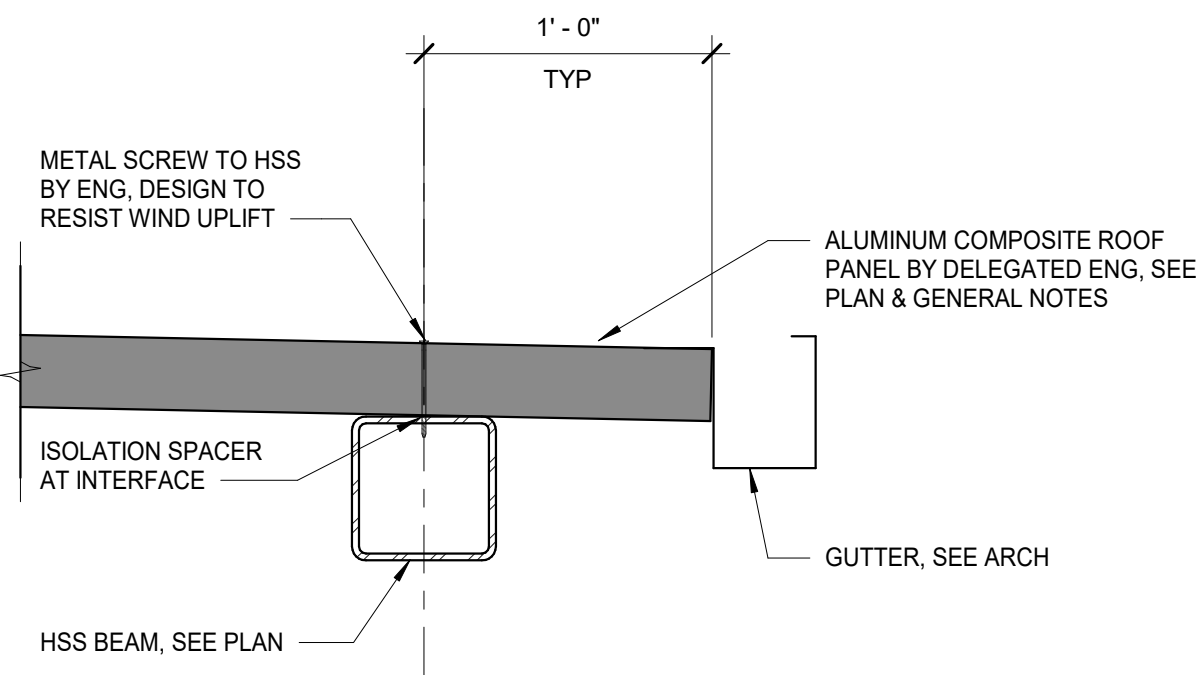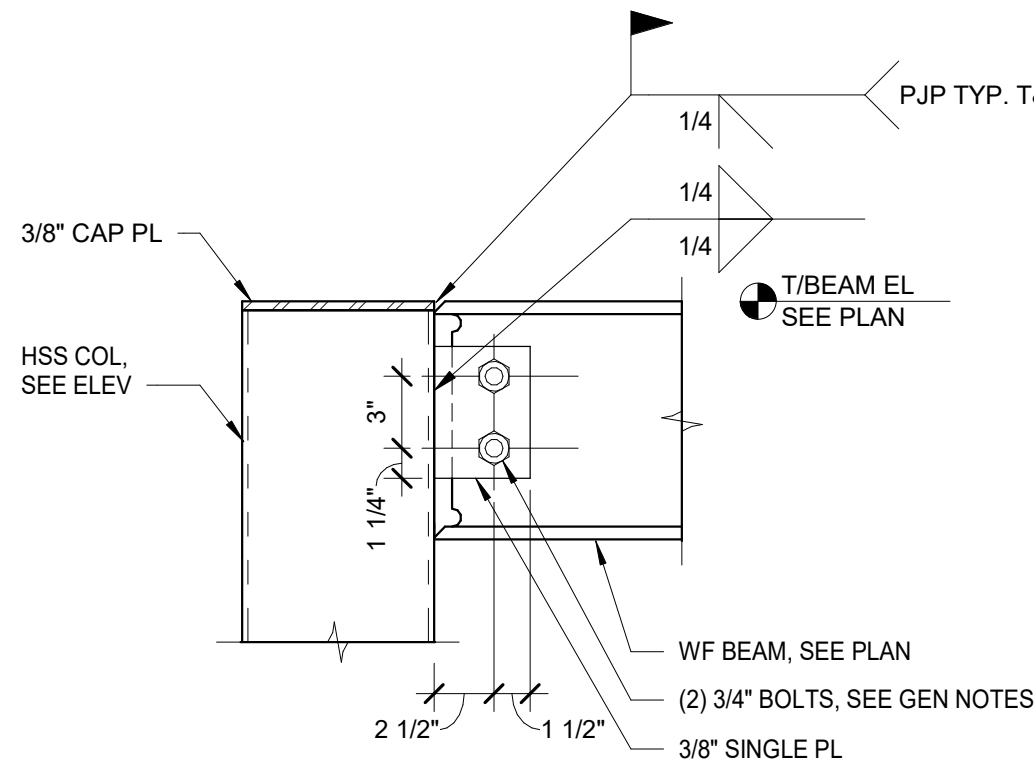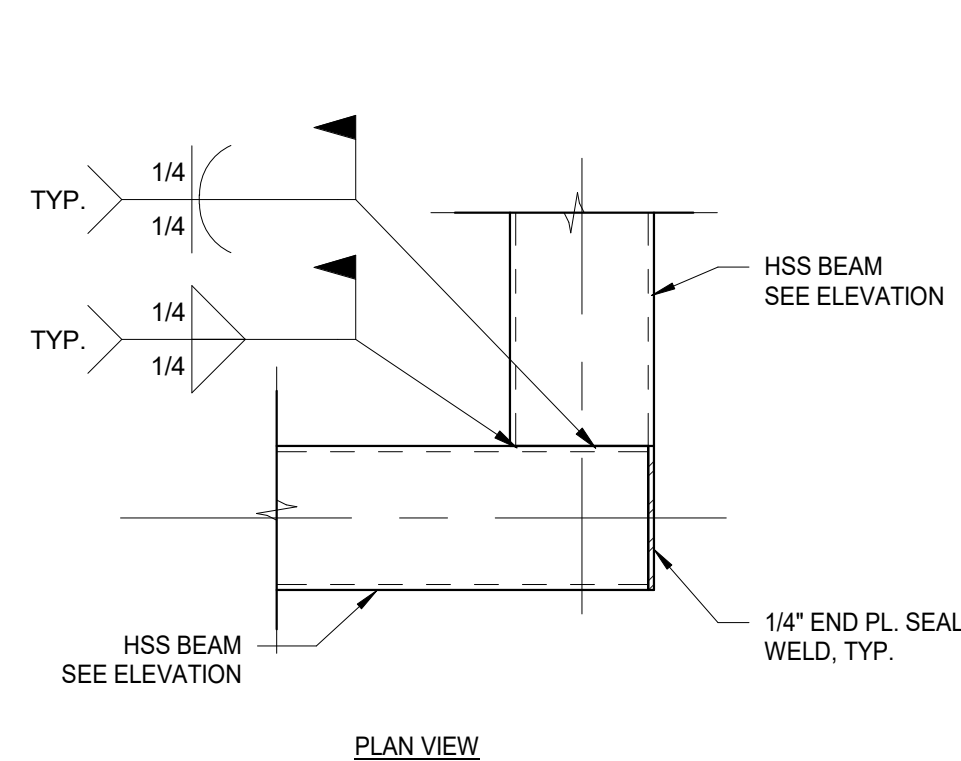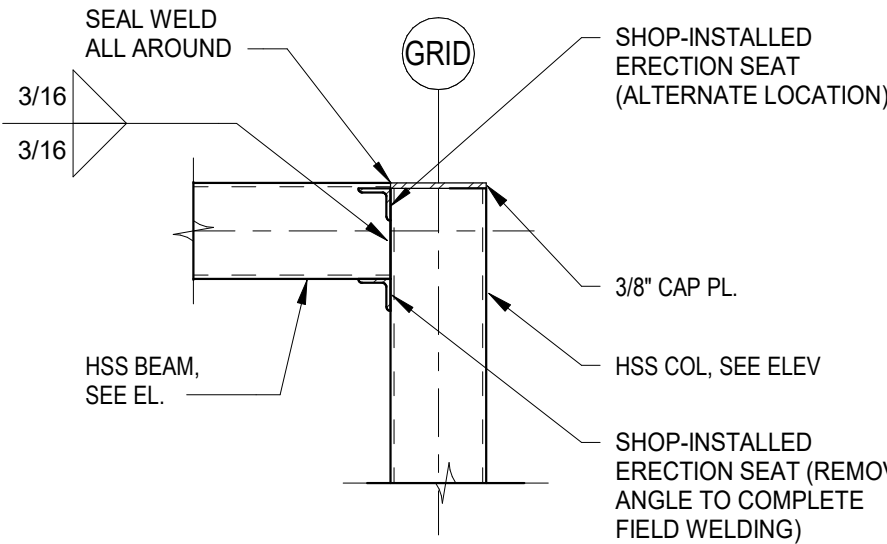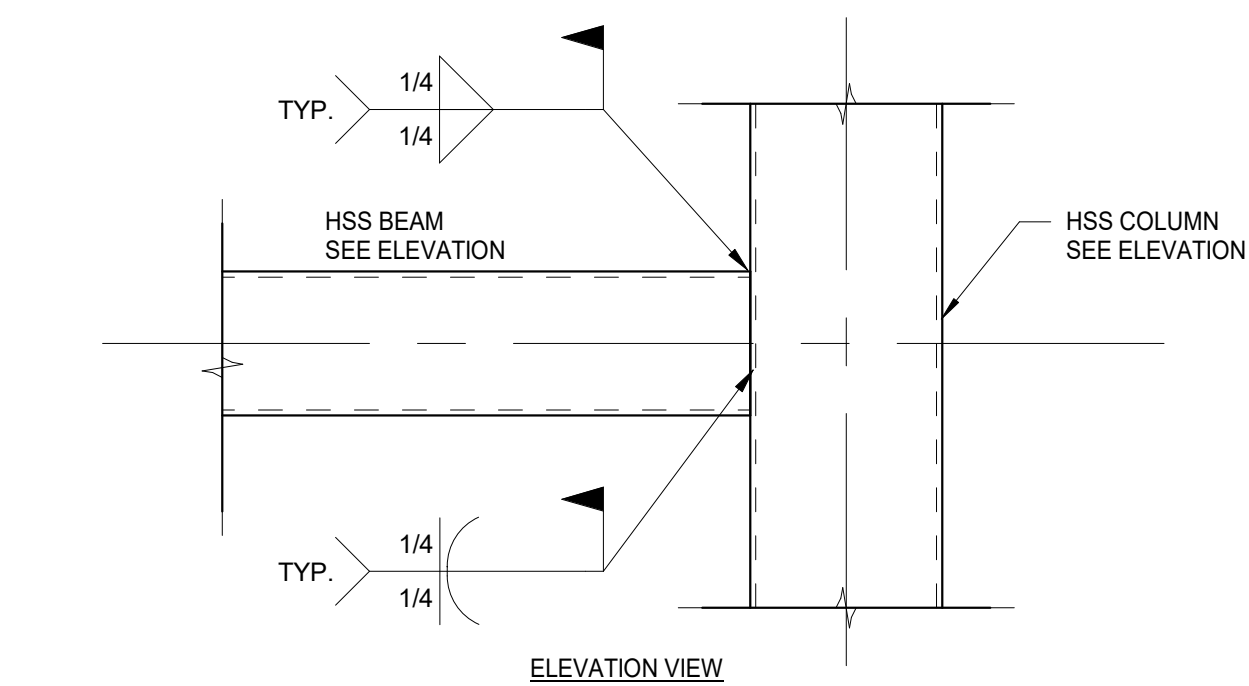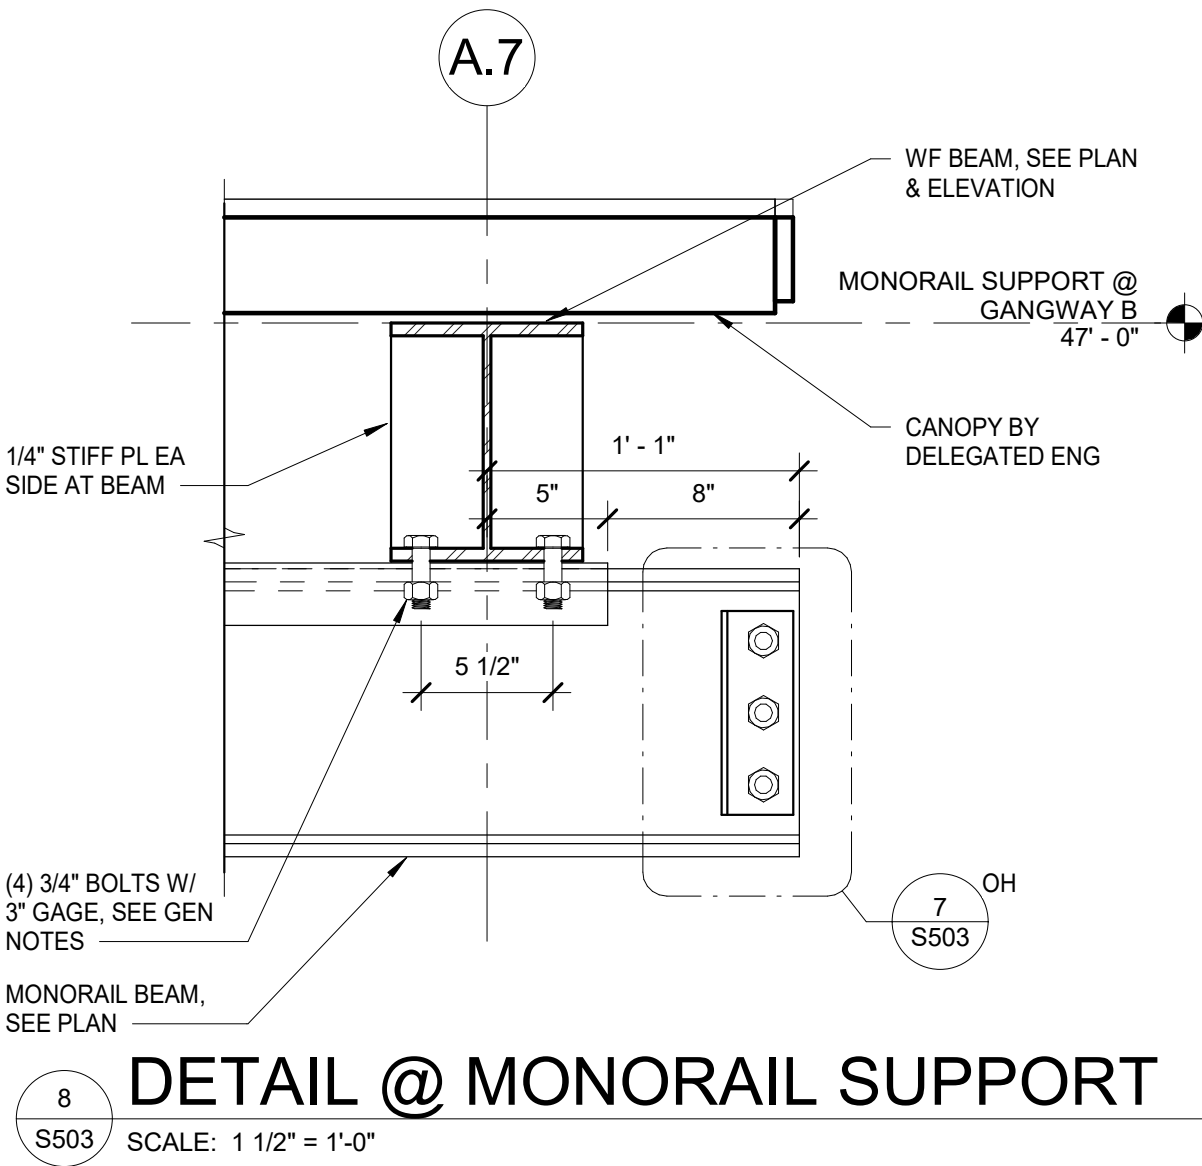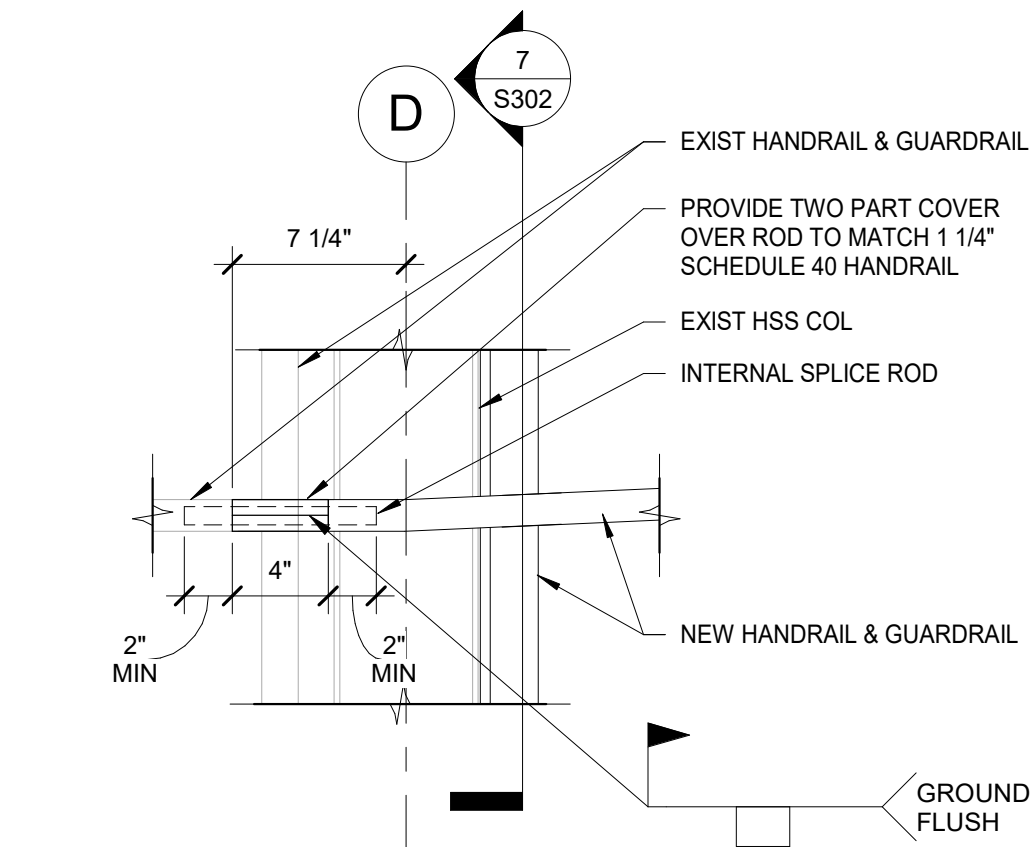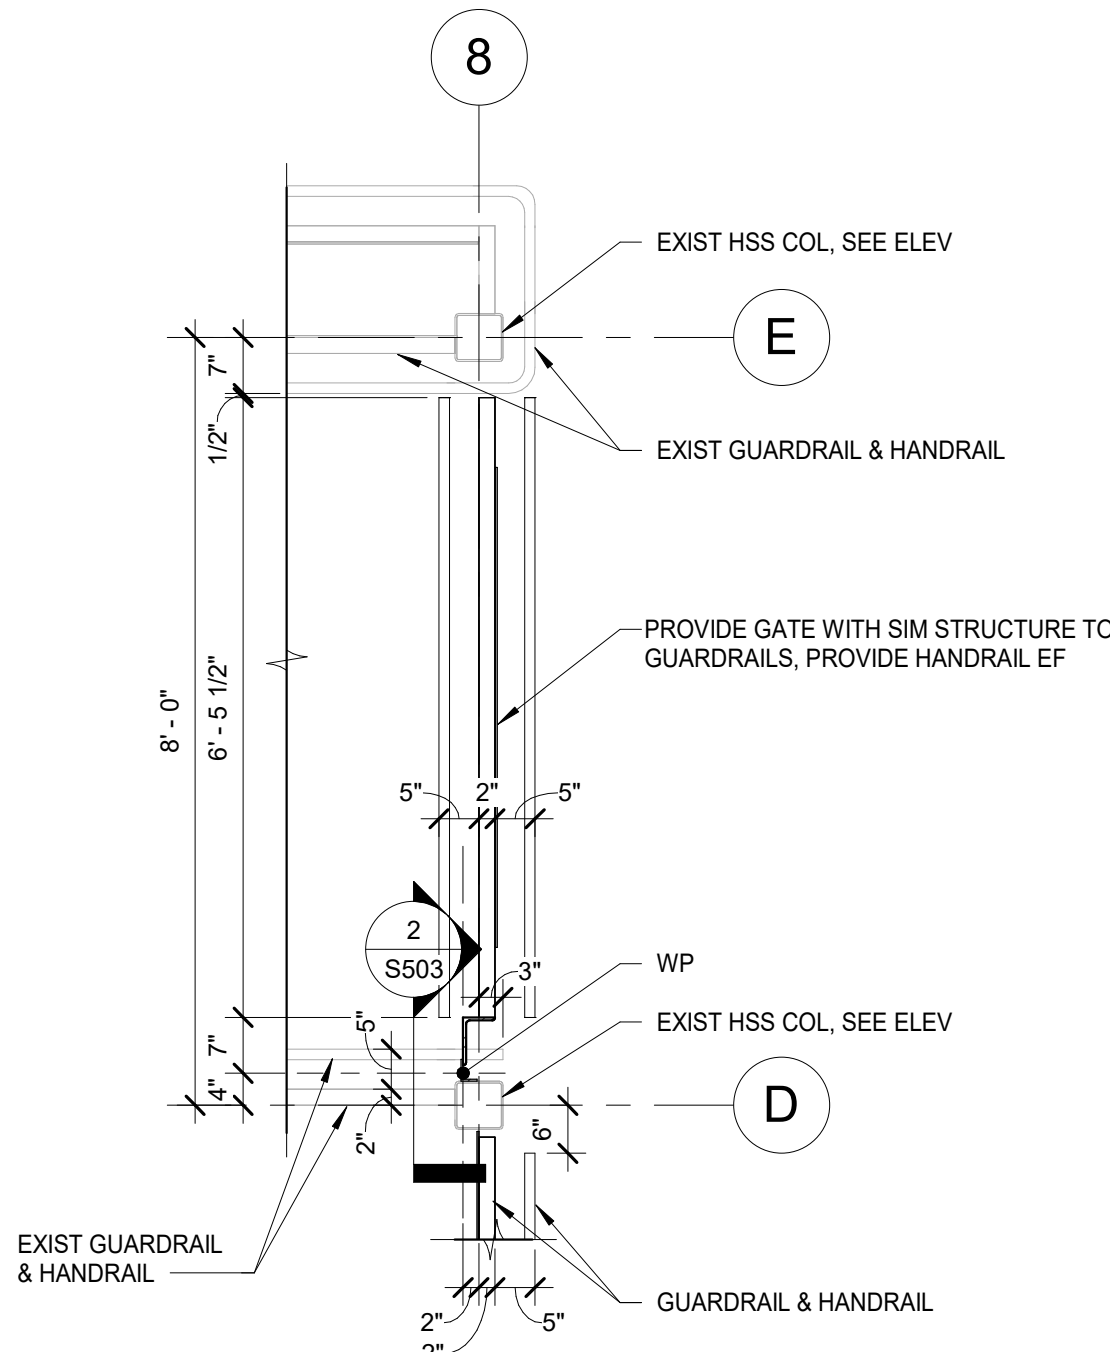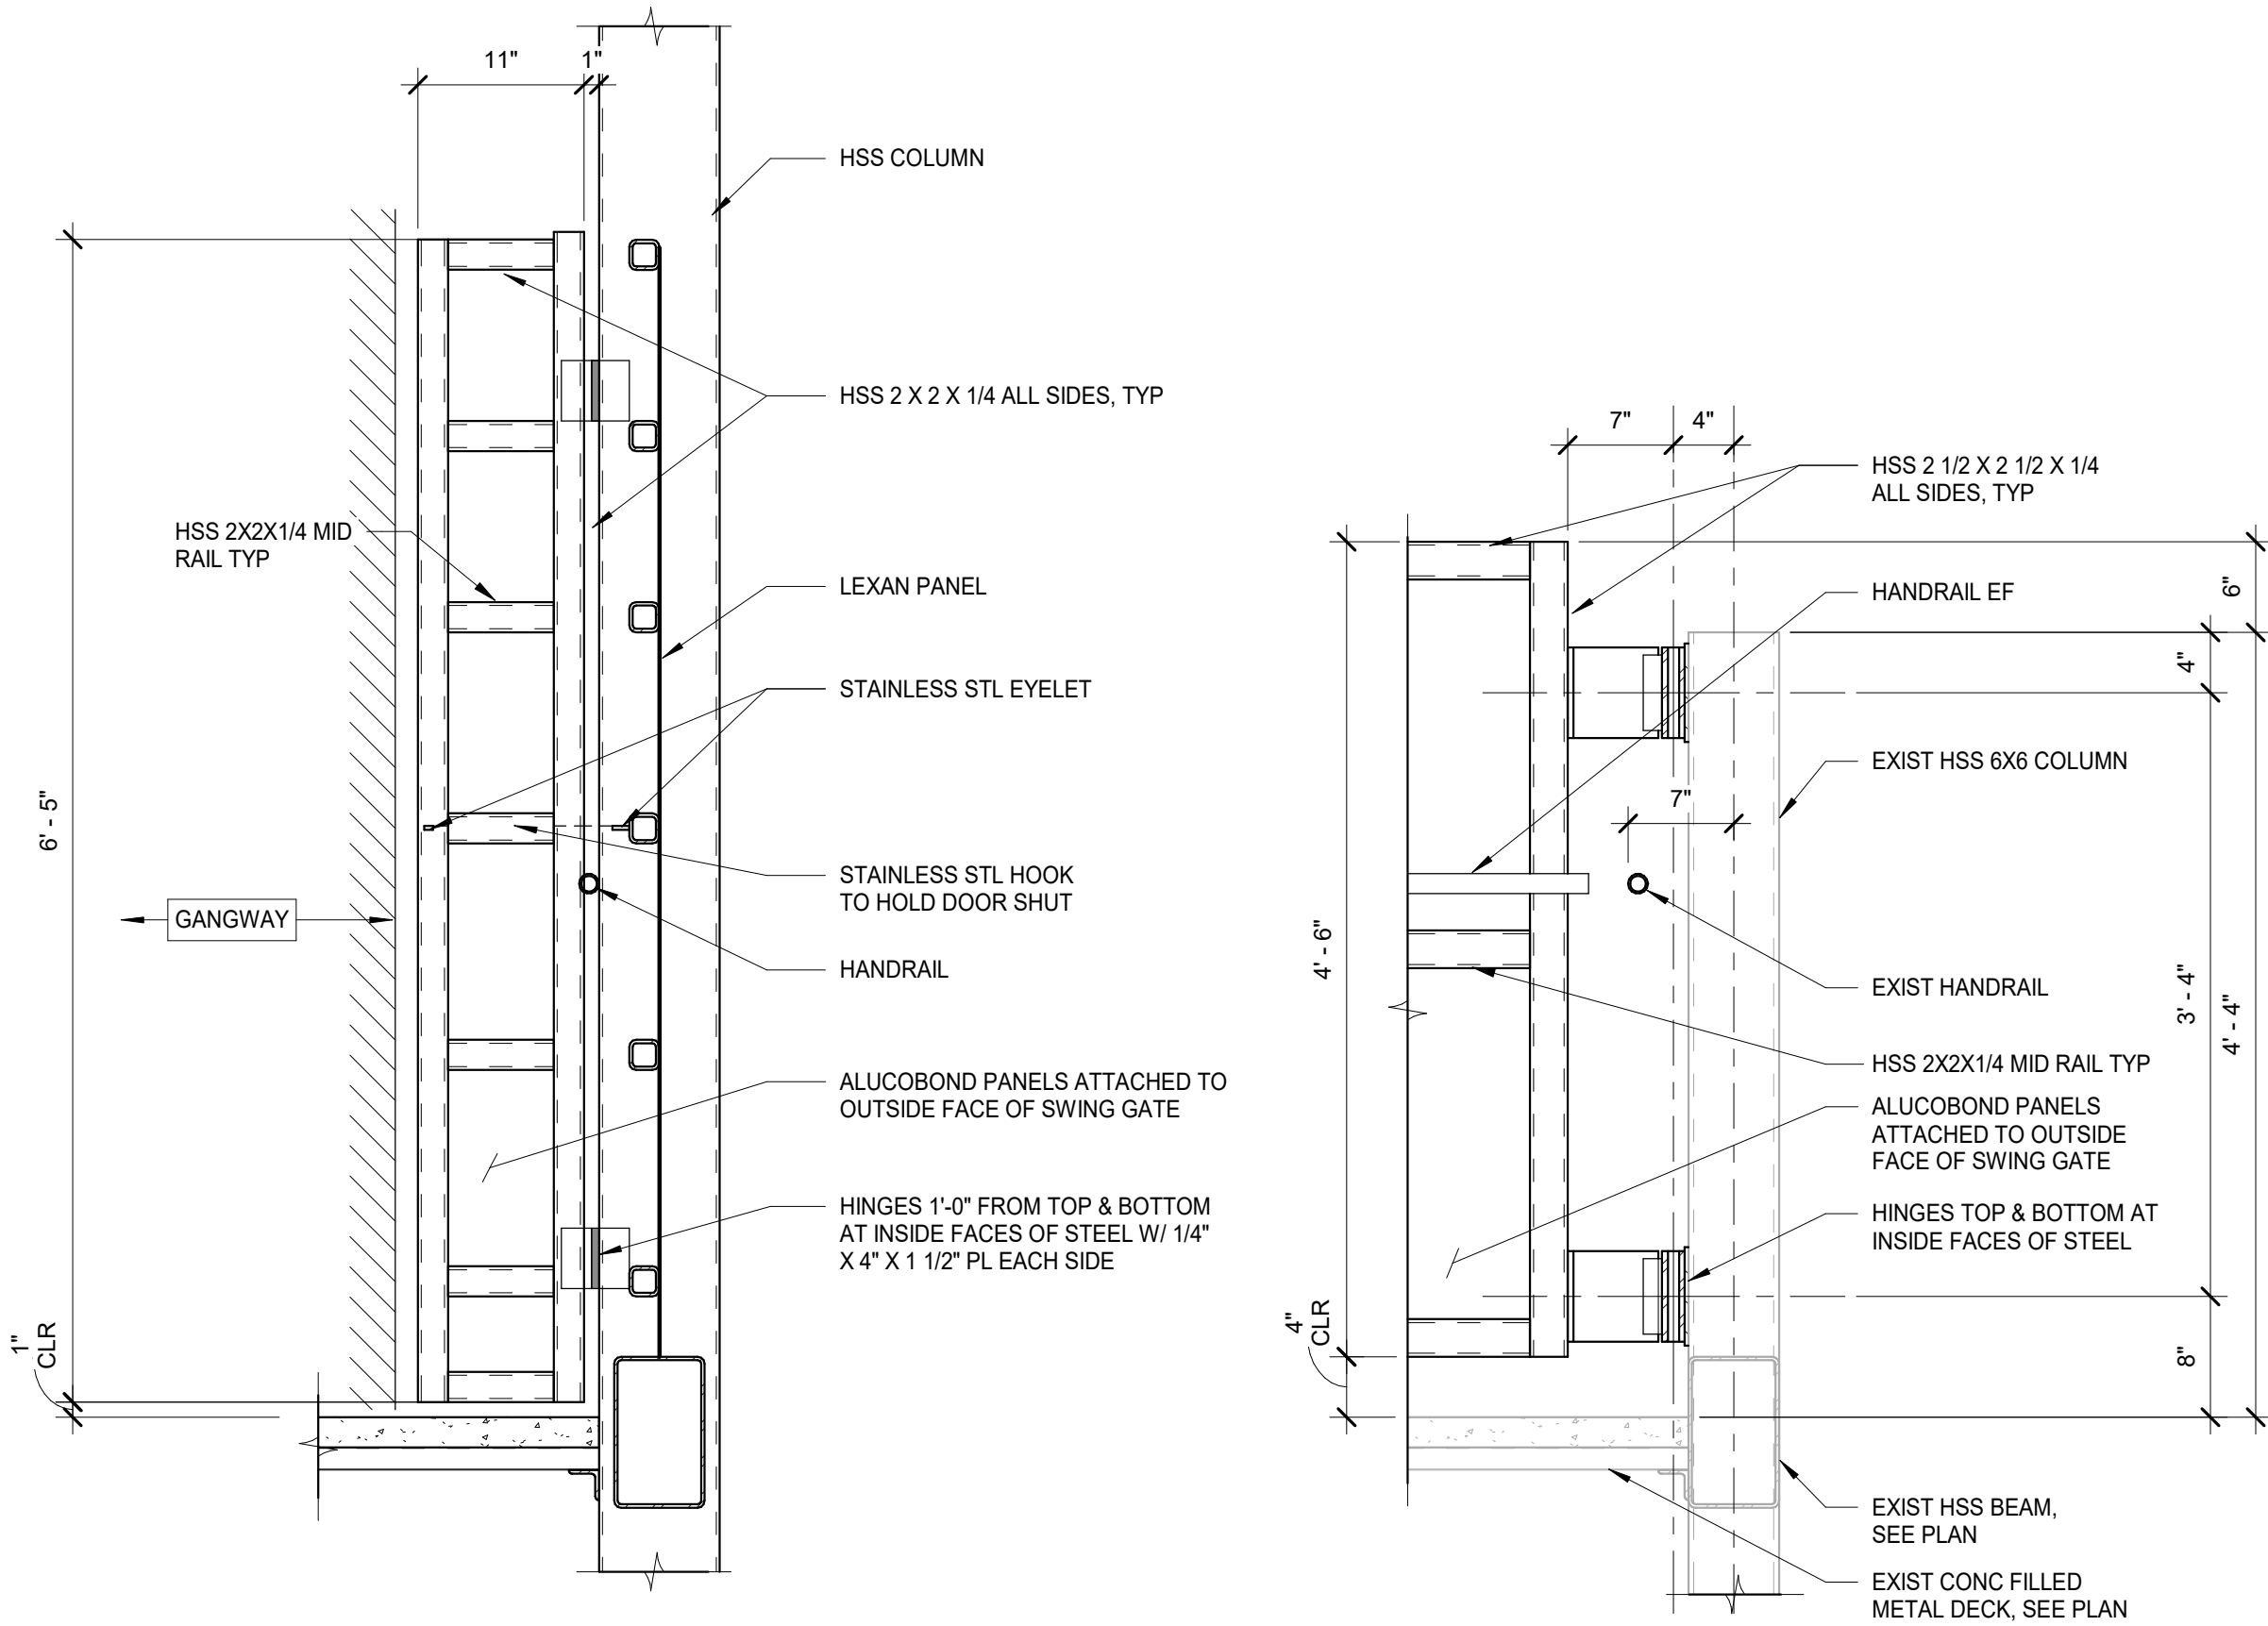

REVISIONS		
NO.	DESCRIPTION	DATE



DATE ISSUED: 01/24/2025
REVIEWED BY: PFM
DRAWN BY: JAM
DESIGNED BY: LAP
PROJECT NUMBER: 10014153000

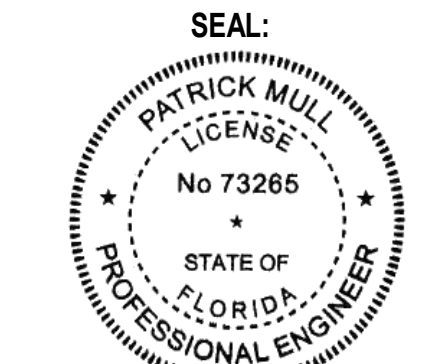

SHEET TITLE:
FRAMING SECTIONS &
DETAILS - II

SHEET ID:
S503

PROJECT STATUS:
100% SUBMITTAL
FOR CONSTRUCTION

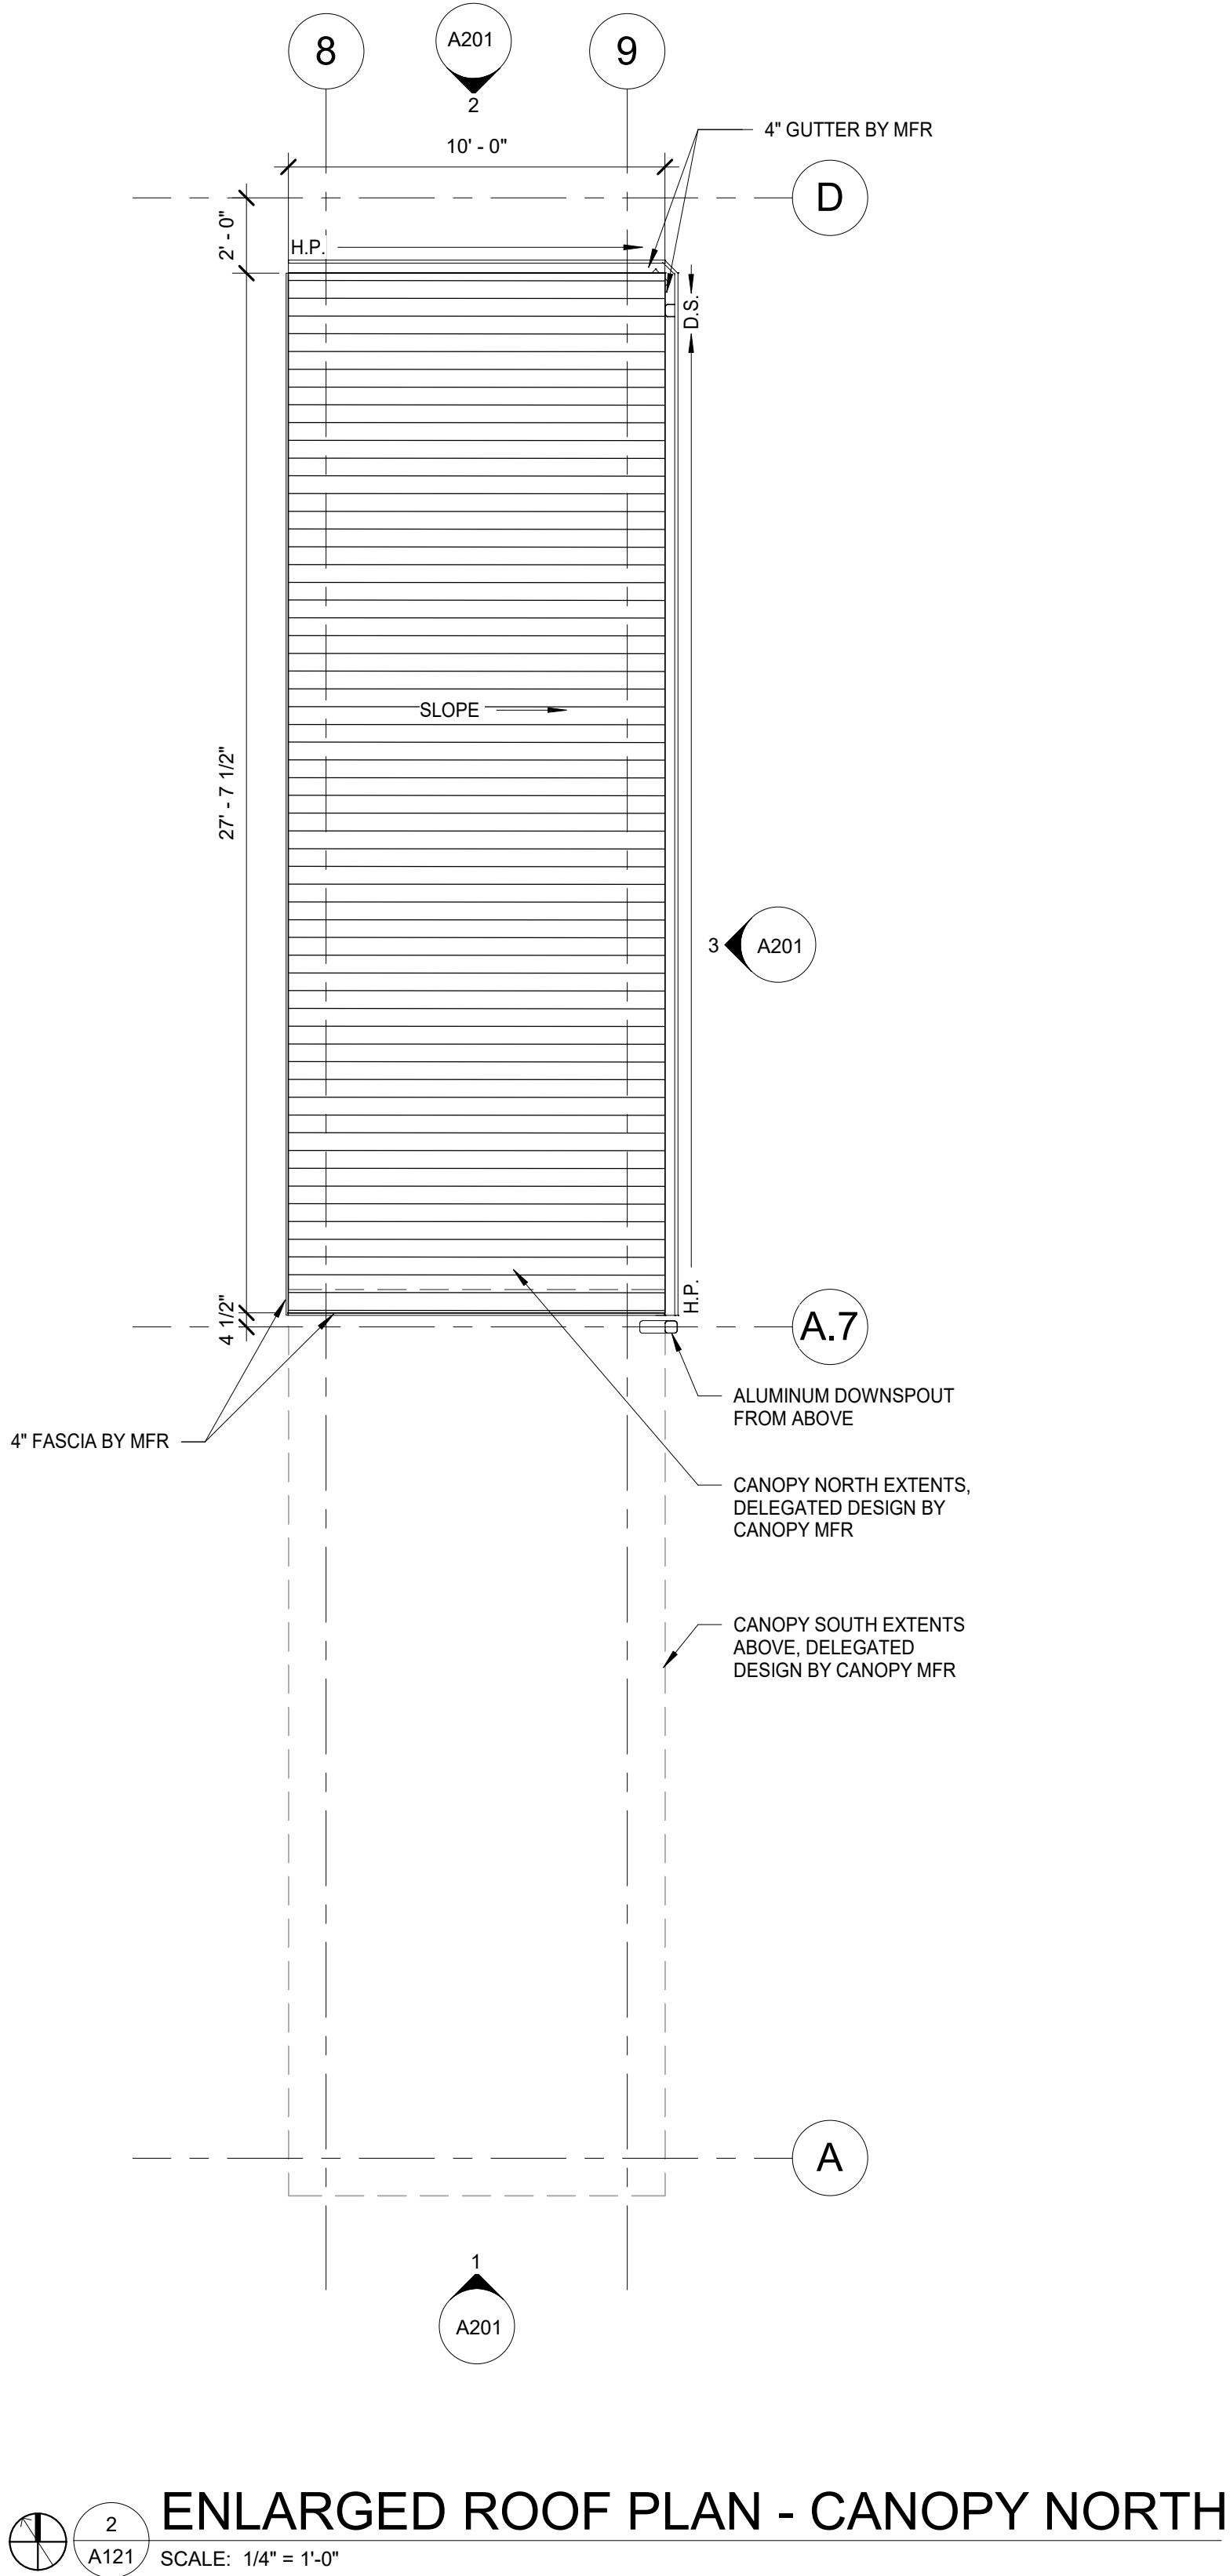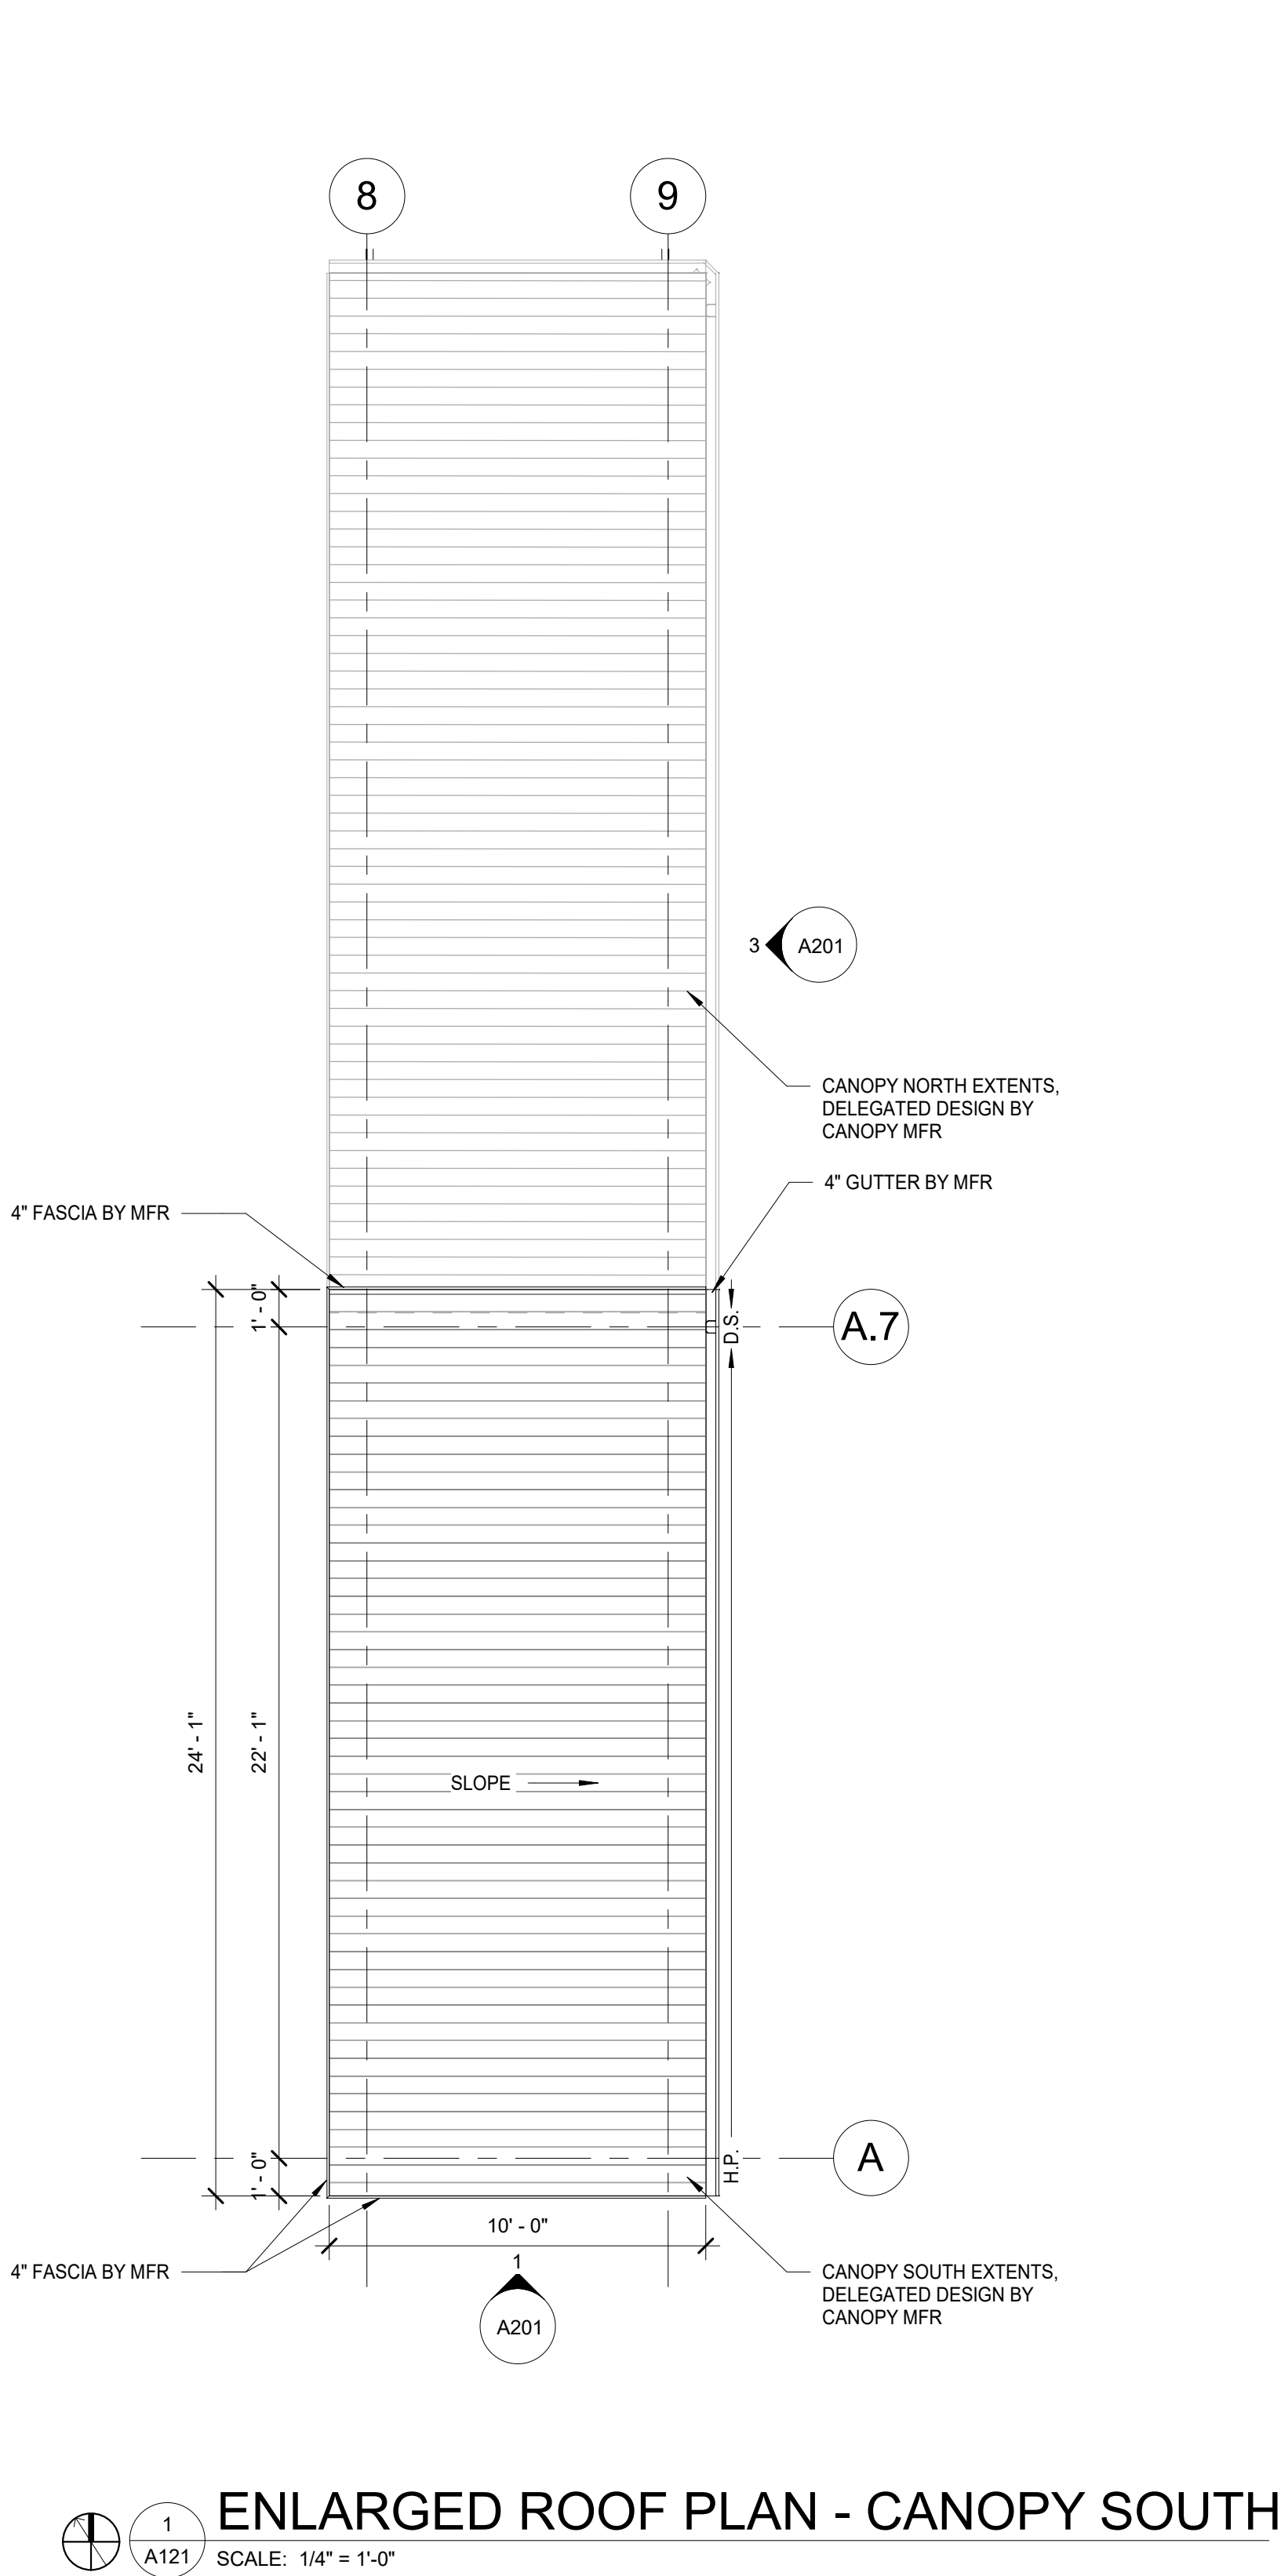

GENERAL NOTES

1. ALL WORK MUST COMPLY WITH THE REQUIREMENTS OF THE BUILDING CODE OF THE STATE OF FLORIDA.
2. THE DIMENSIONS MUST BE USED IN CONJUNCTION WITH THE SPECIFICATIONS.
3. THE CONTRACTOR WILL FIELD VERIFY DIMENSIONS AND REPORT IN WRITING ANY CONFLICTS PRIOR TO FABRICATION.
4. SEE ELECTRICAL PLANS FOR OPERATIONAL LAYOUT. CONTRACTOR MUST VERIFY AND COORDINATE WITH OWNER'S VENDOR FOR CORRECT PLACEMENT OF HARDWARE PRIOR TO CONSTRUCTION.
5. EXISTING AND FUTURE UNDERLAY LINework FOR REFERENCE PURPOSES ONLY. ANY CIVIL RELATED WORK, SEE CIVIL PACKAGE FOR DETAILS.
6. THESE DRAWINGS ARE PROVIDED FOR A SPECIFIC DESIGN INTENT ONLY.

BASIS OF DESIGN

1. ELITE ALUMINUM CORPORATION, CANOPY PANEL.
2. ELITE ALUMINUM CORPORATION, ELITE 'E' GUTTER AND ELITE 'E' FASCIA.



10748 Deerwood Park Blvd. South
Jacksonville, Florida 32256-0597
904-256-2500 Fax 904-256-2503
www.rsandh.com
FL Cert. Nos. AAC001886 * IB26000956 *
5620 * LCC000210 * GB238



PROJECT TITLE:
JAXPORT CRUISE TERMINAL
GANGWAY MODIFICATION

PROJECT ADDRESS:
9810 AUGUST DRIVE
JACKSONVILLE, FL 32226

REVISIONS

NO.	DESCRIPTION	DATE

DATE ISSUED: 01/24/2025
REVIEWED BY: SDP
DRAWN BY: ALH
DESIGNED BY: CMV
PROJECT NUMBER: 10014153000




SHEET TITLE:
ROOF PLAN


SHEET ID:

A121


PROJECT STATUS:
100% SUBMITTAL
FOR CONSTRUCTION

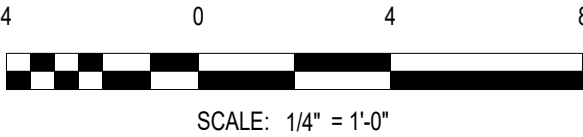


SCALE: 1/4" = 1'-0"

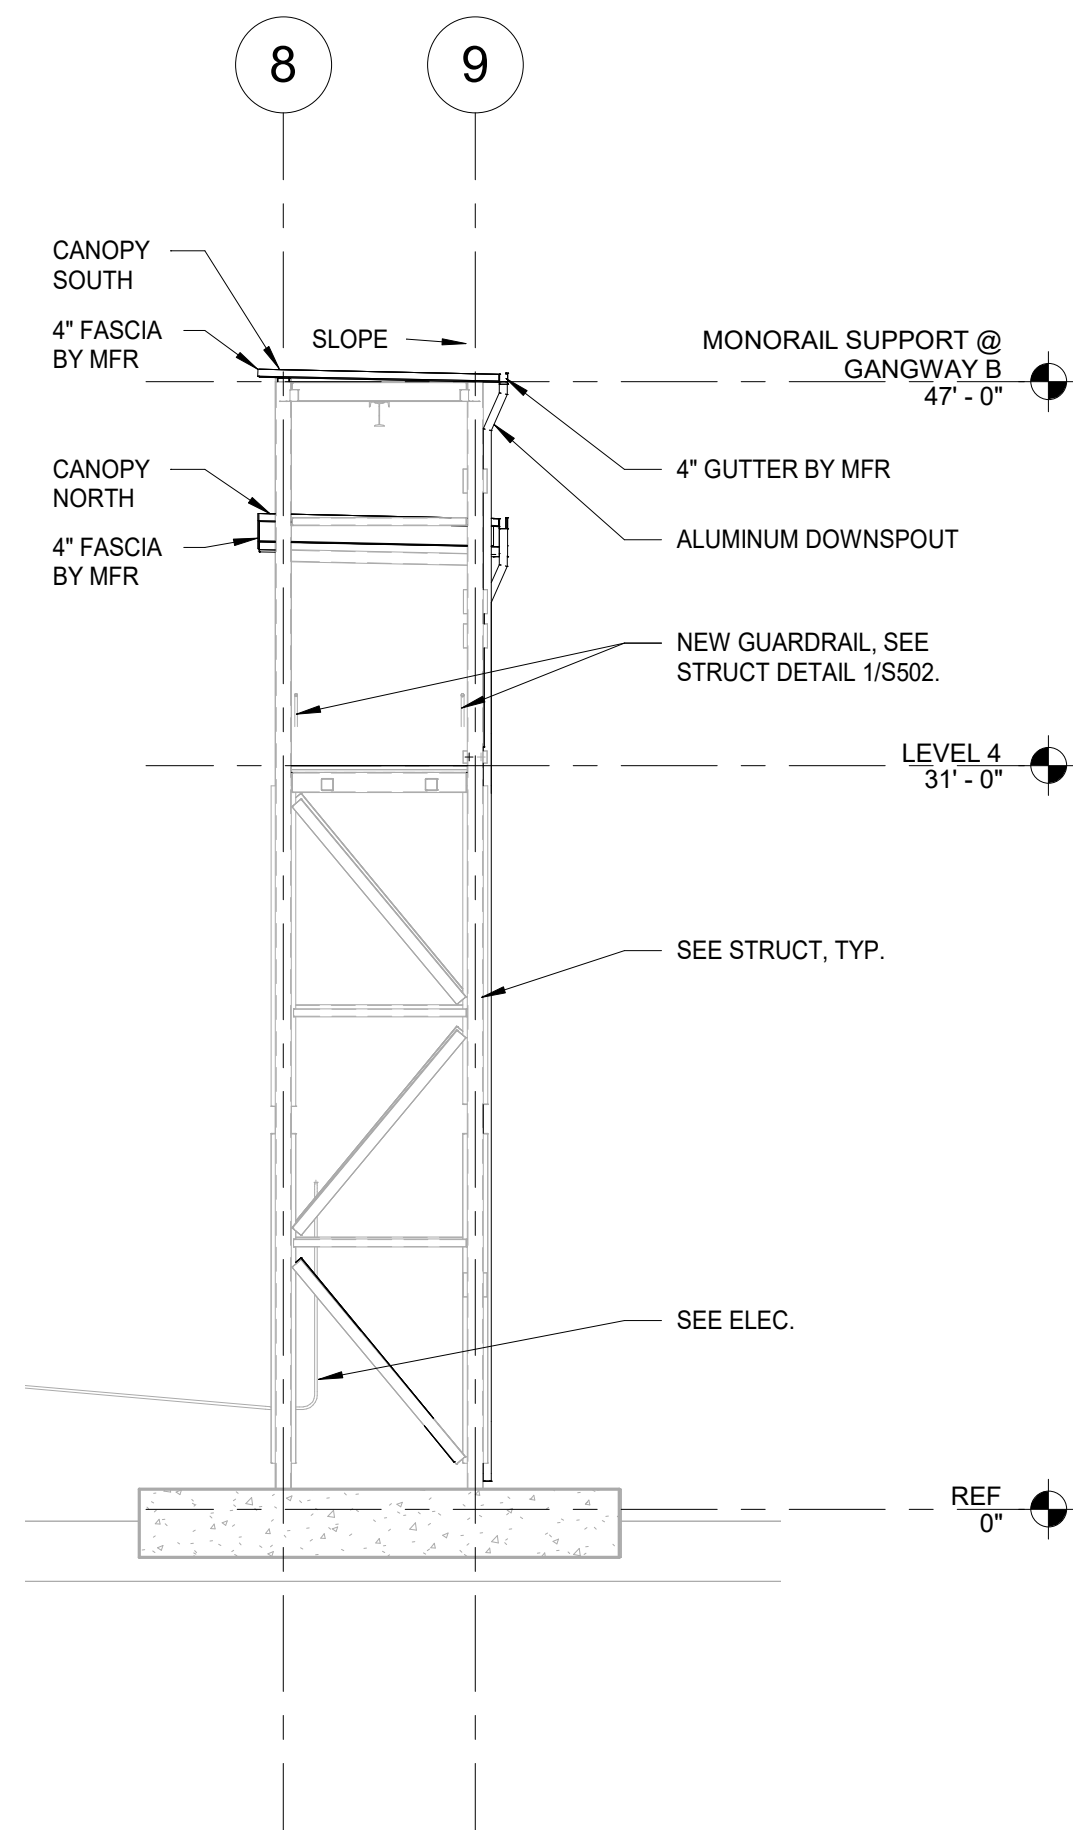


1 SOUTHERN ELEVATION
A201 SCALE: 1/8" = 1'-0"

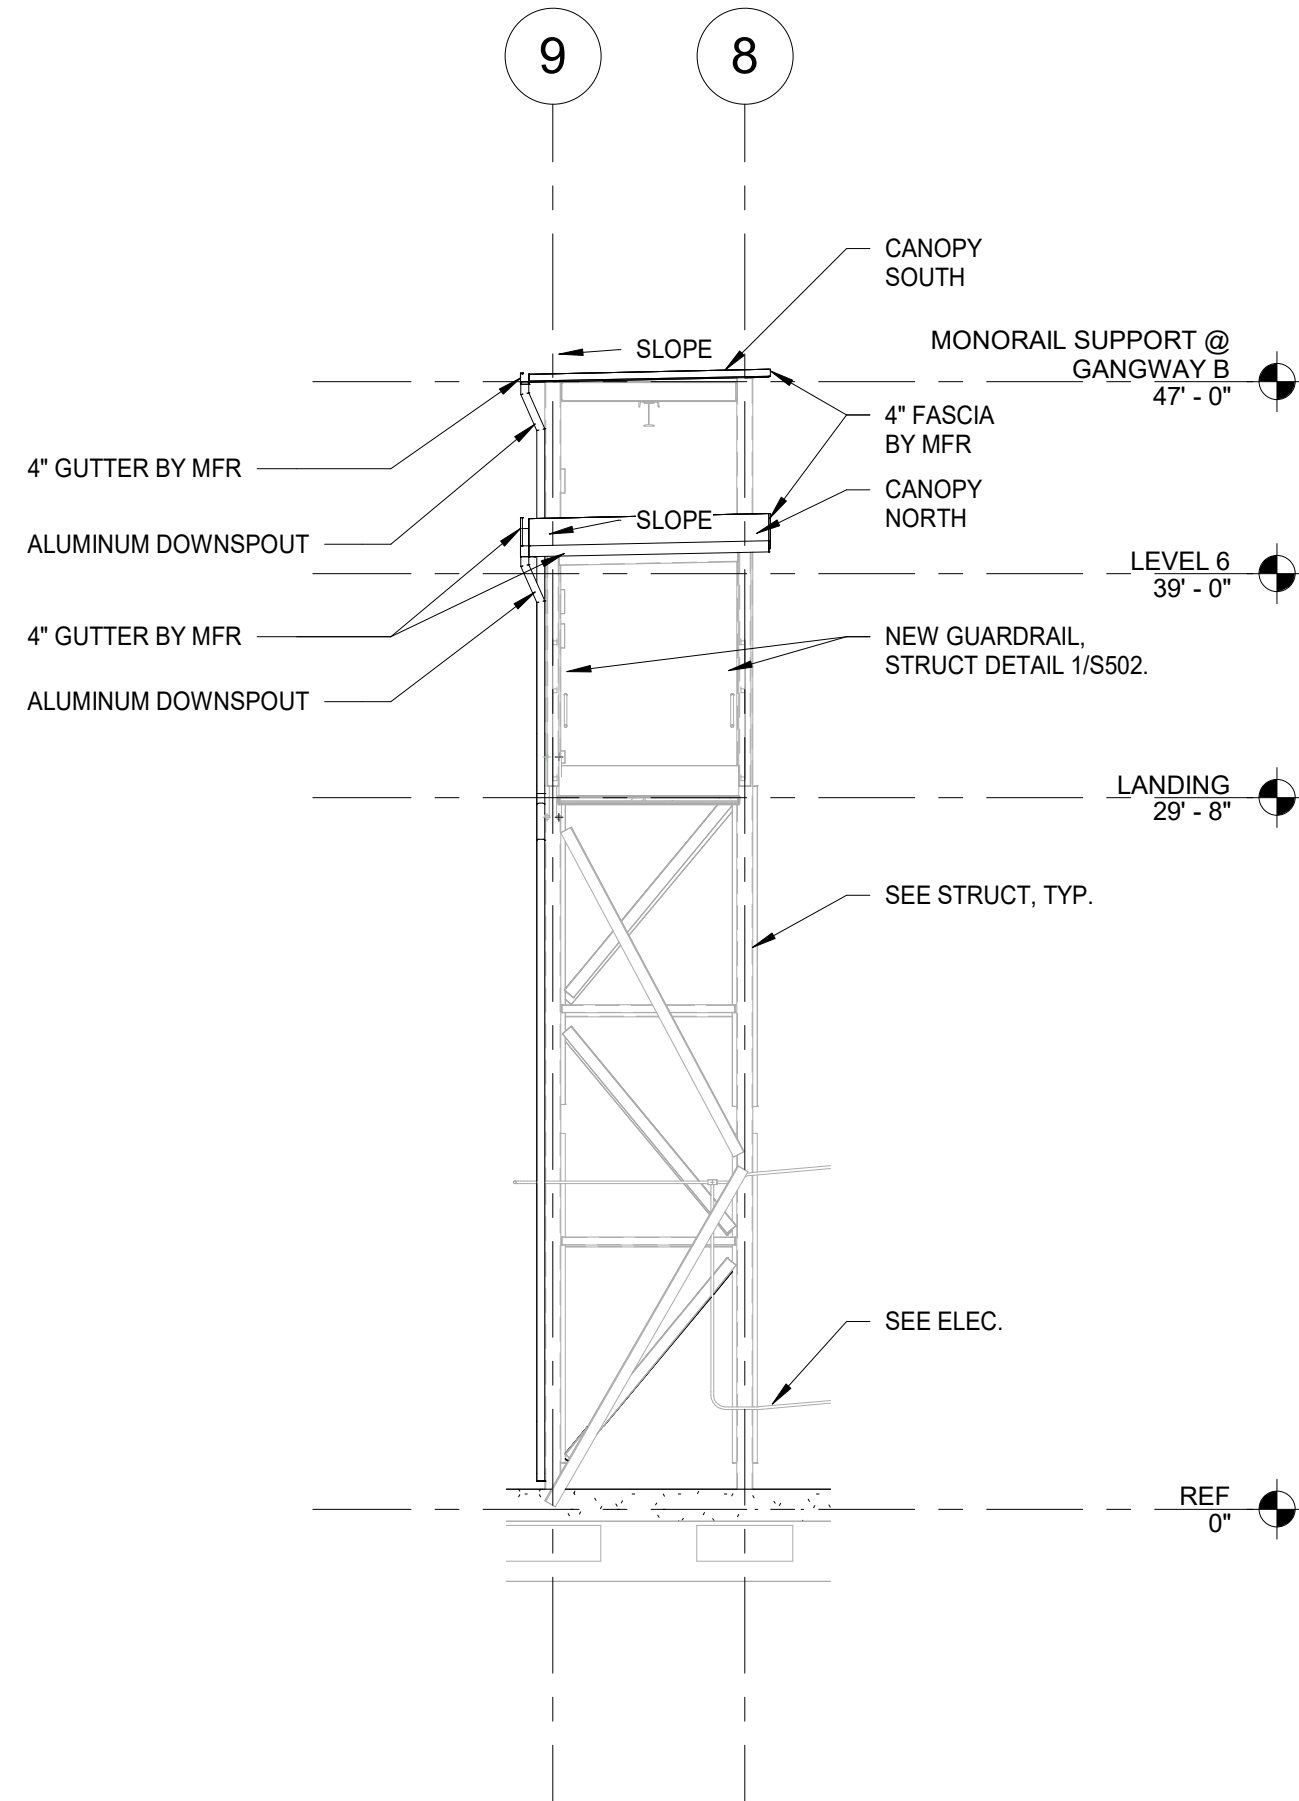

2 NORTHERN ELEVATION
A201 SCALE: 1/8" = 1'-0"

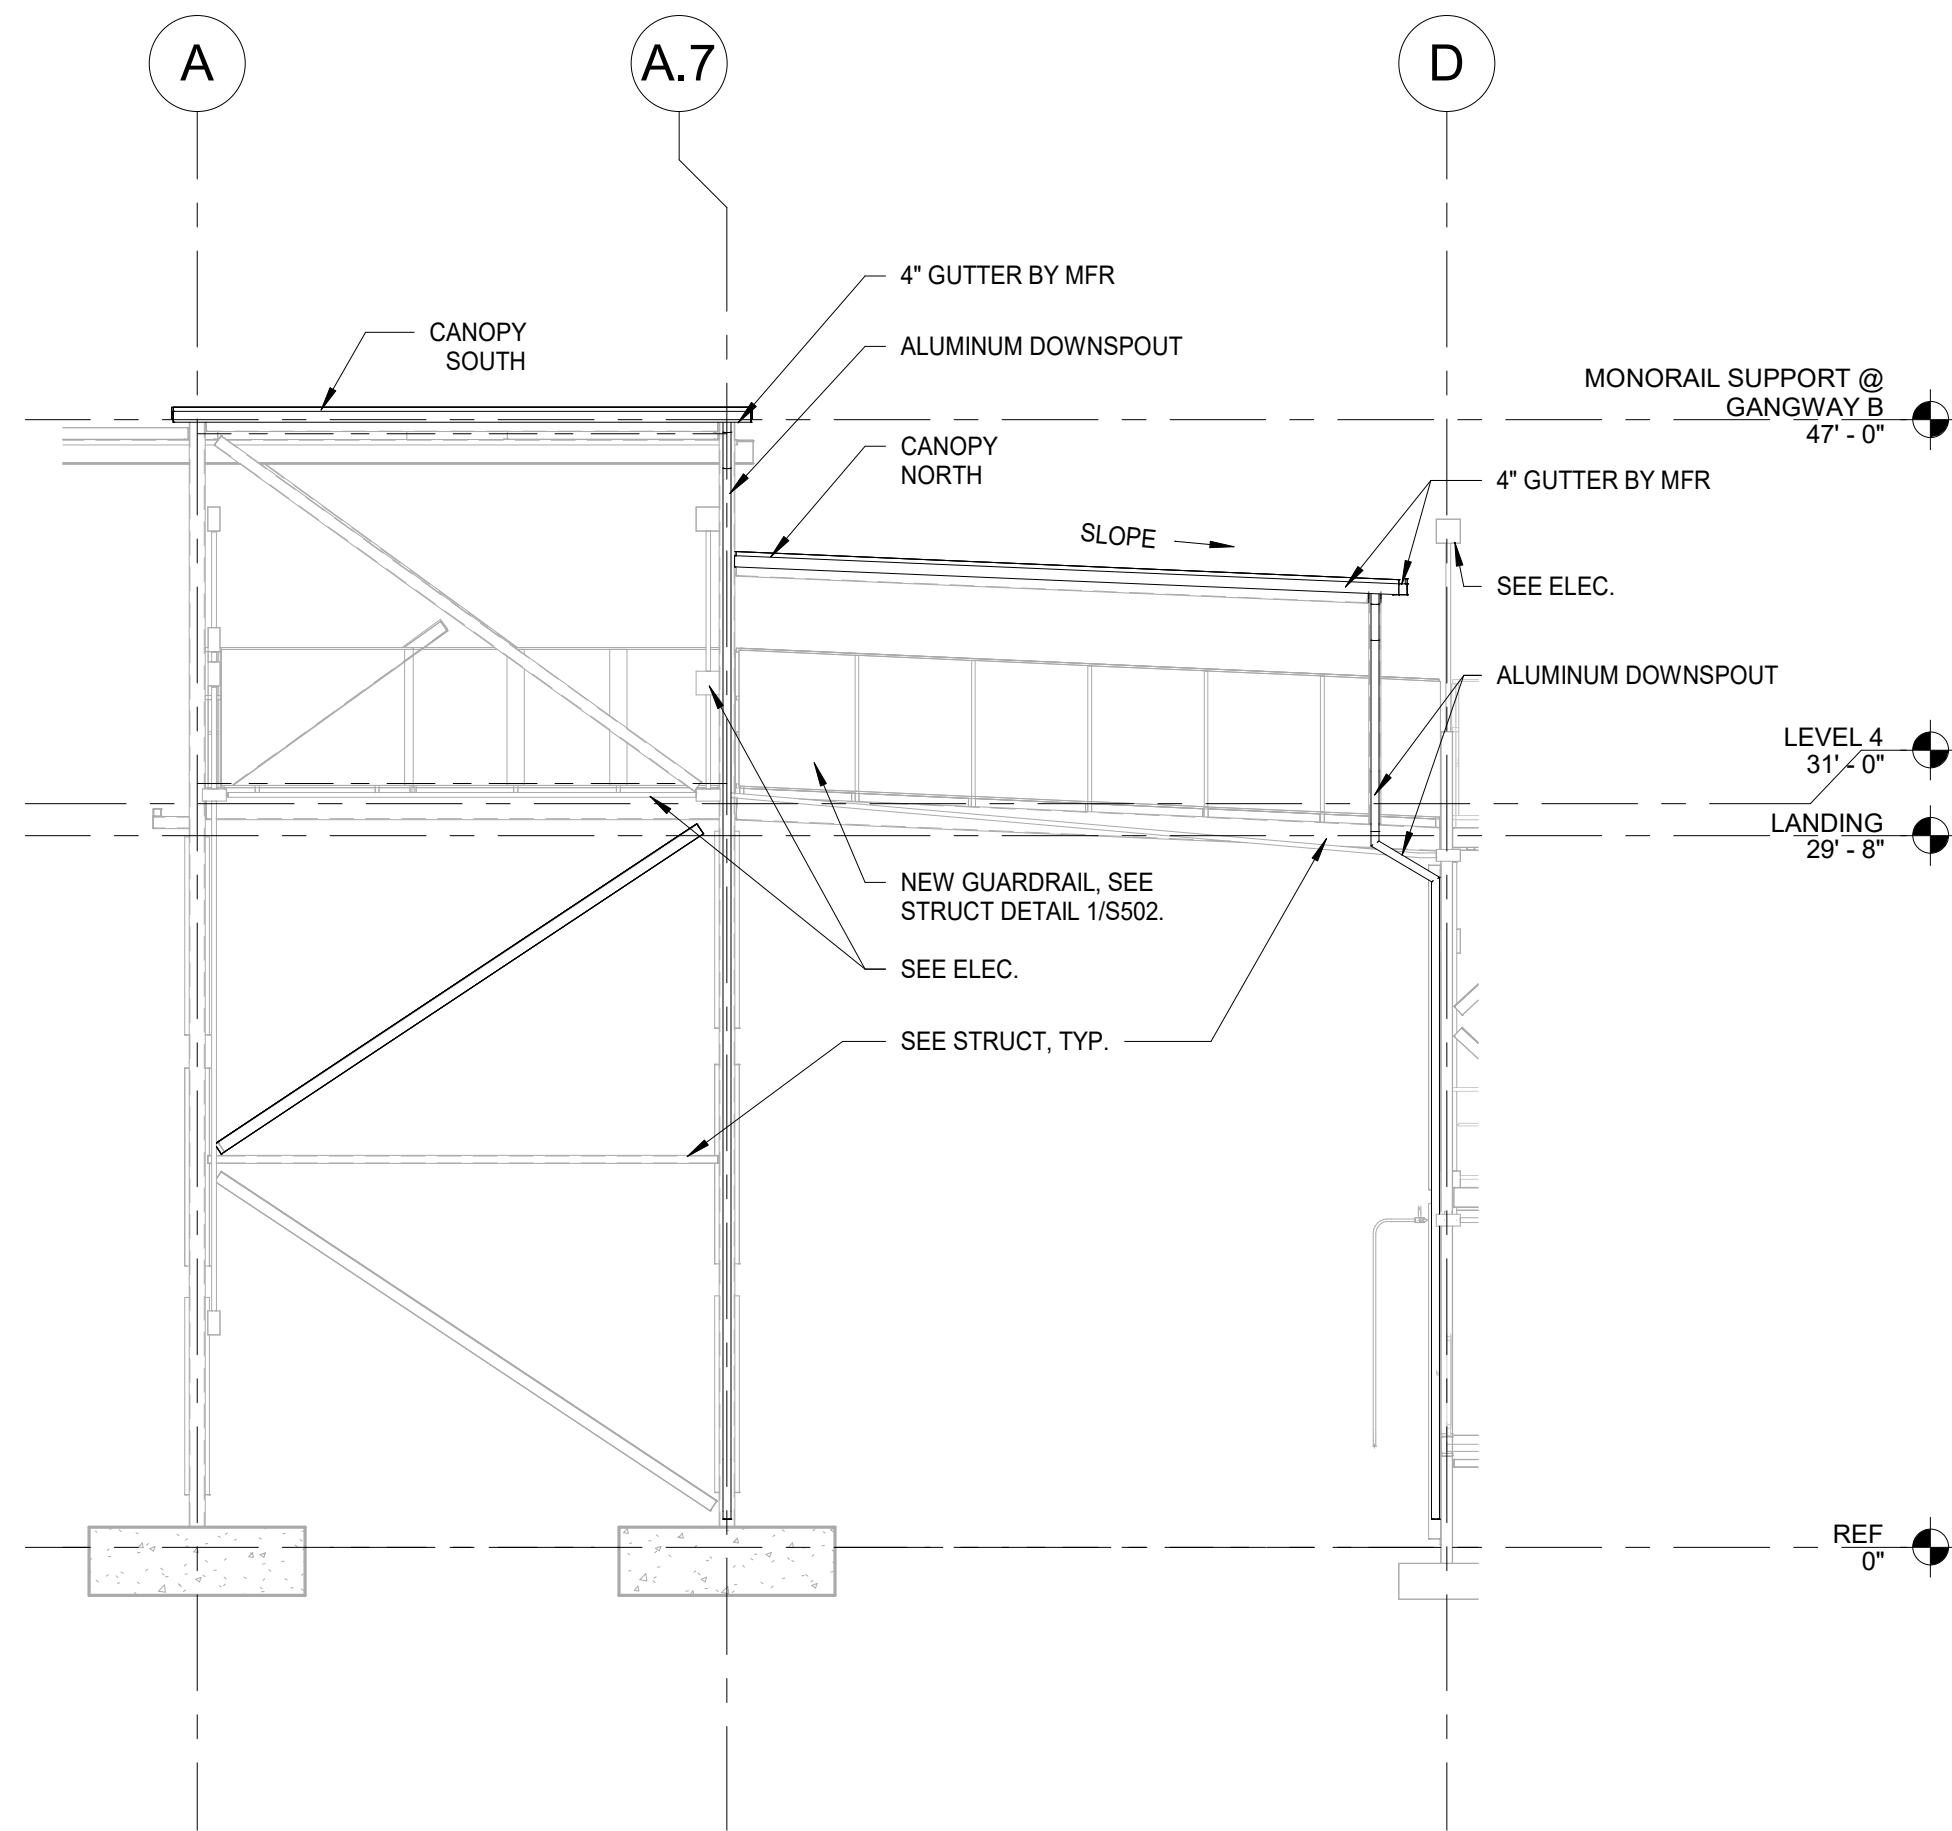

3 EASTERN ELEVATION
A201 SCALE: 1/8" = 1'-0"

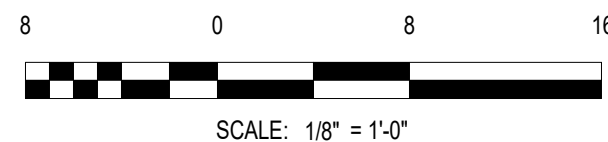


PROJECT TITLE:
JAXPORT CRUISE TERMINAL
GANGWAY MODIFICATION

PROJECT ADDRESS:
9810 AUGUST DRIVE
JACKSONVILLE, FL 32226

REVISIONS		
NO.	DESCRIPTION	DATE

DATE ISSUED: 01/24/2025
REVIEWED BY: SDP
DRAWN BY: ALH
DESIGNED BY: CMV
PROJECT NUMBER:
10014153000

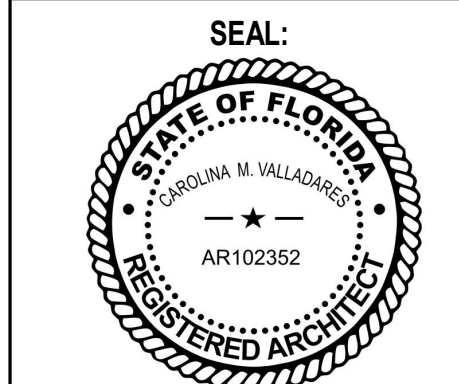

SHEET TITLE:
ELEVATIONS

SHEET ID:
A201

PROJECT STATUS:
100% SUBMITTAL
FOR CONSTRUCTION

PROJECT NOTES

1. WHERE FOOTERS OR FOUNDATIONS ARE INSTALLED BY AUGERING OR DRILLING, SURVEY AND STAKE OR PAINT TO AN ACCURACY OF 0.1' PRIOR TO REQUESTING UTILITY LOCATES. STAKE OR PAINT THE CENTER OF EACH LOCATION AND CLEARLY LABEL WITH STATION, OFFSET, IDENTIFYING STRUCTURE NUMBER, AND DIAMETER OF EXCAVATION IN INCHES.
2. WHERE AUGERING OR DRILLING, EXCAVATE THE FIRST 4 FEET BY NON MECHANICAL AND NON DESTRUCTIVE MEANS.

PROJECT DESCRIPTION

1. PROJECT INCLUDES AN EXTENSION OF THE EXISTING GANGWAY ELECTRICAL POWER AND LOW-VOLTAGE SYSTEMS WITH LIKE-TO-LIKE CONSTRUCTION METHODS LARGELY INCLUDING UV-RESISTANT PVC CONDUIT BODIES AND BOXES AS A BASIS OF DESIGN.

INDEX OF ELECTRICAL PLANS

PLAN SYMBOLS

	SURFACE MOUNTED CONDUIT WITHIN OPEN CEILING, AS INDICATED ON DRAWINGS.
	(1)-1" UV RESISTANT SCHEDULE 40 PVC OR GREATER CONDUIT WITH TYPE THWN-2 CONDUCTORS INSIDE (CONDUIT AND CONDUCTOR SIZE AS SHOWN ON PLAN SHEETS) FOR ELECTRICAL FEEDER.
	(1)-2" UV RESISTANT SCHEDULE 40 PVC OR GREATER CONDUIT WITH PULL CORD FOR PROPOSED CAMERAS. CONDUIT ROUTING INDICATED ON PLANS.
	RECESSED IN-GRADE PRECAST PULL BOX (HANDHOLE) FOR FUTURE UNDERGROUND TELECOMMUNICATIONS AND WITH THE FOLLOWING NOMINAL INSIDE DIMENSIONS: 12" Wx24" Lx24" D. PULLBOX SHALL BE PROVIDED WITH BOLT DOWN CHECKERED STAINLESS STEEL LID IDENTIFIED AS "COMMUNICATIONS".
	RECESSED IN-GRADE PRECAST PULL BOX FOR UNDERGROUND ELECTRIC AND WITH THE FOLLOWING NOMINAL INSIDE DIMENSIONS 24" Wx36" Lx24" D. PULLBOX SHALL BE PROVIDED WITH BOLT DOWN CHECKERED STAINLESS STEEL LID IDENTIFIED AS "ELECTRICAL".
	ACCESSIBLE JUNCTION BOX
	CONDUIT RISER (STUB-UP) AND UNDERGROUND TRANSITION
	ELECTRIC MOTOR (FURNISHED BY OTHERS)
	HOMERUN CIRCUIT. NUMBER REPRESENTS CIRCUIT DESIGNATION. LETTERS REPRESENT PANEL SOURCE.
	SINGLE-POINT TERMINATION TO FURNISHED EQUIPMENT
	SURFACE MOUNTED FUSED DISCONNECT
	DETAIL CALLOUT

ONE-LINE SYMBOLS

	TRANSFORMER
	PANELBOARD / LOAD CENTER
	CIRCUIT BREAKER
	FUSED DISCONNECT, SIZES AS INDICATED ON DRAWINGS
	KILOWATT DEMAND METER
	ELECTRIC MOTOR
	GENERATOR
	AUTOMATIC TRANSFER SWITCH (ATS)

GENERAL NOTES

1. ALL WORK AND EQUIPMENT UNDER THIS DIVISION SHALL BE IN STRICT COMPLIANCE WITH THE PROVISIONS OF THE FOLLOWING CODES AND STANDARDS:
2. FLORIDA BUILDING CODE 2023, NFPA 70 NATIONAL ELECTRICAL CODE 2020, UNDERWRITERS LABORATORIES INC. PUBLICATIONS, NATIONAL FIRE PROTECTION ASSOCIATION (NFPA), AMERICAN NATIONAL STANDARDS INSTITUTE (ANSI), INSTITUTE OF ELECTRICAL AND ELECTRONIC ENGINEERS (IEEE), NATIONAL ELECTRICAL MANUFACTURERS ASSOCIATION (NEMA), INTERNATIONAL POWER CABLE ENGINEERS ASSOCIATION (IPCEA), NATIONAL ELECTRICAL SAFETY CODE, REQUIREMENTS OF LOCAL POWER CORPORATION, AMERICANS WITH DISABILITIES ACT (ADA), ADA STANDARDS FOR ACCESSIBLE DESIGN 2010, AMERICAN SOCIETY FOR TESTING AND MATERIAL (ASTM), THE OCCUPATION SAFETY AND HEALTH ACT (OSHA),
3. IT IS THE INTENT OF THESE DRAWINGS AND OTHER RELATED DOCUMENTS TO PRODUCE A COMPLETE AND FUNCTIONING ELECTRICAL SYSTEM. THE ELECTRICAL CONTRACTOR SHALL PROVIDE ALL LABOR, MATERIAL AND OTHER SERVICES AS MAY BE NECESSARY TO ACHIEVE THIS PRODUCT. IT SHALL BE THE RESPONSIBILITY OF THE CONTRACTOR TO BRING TO THE ATTENTION OF THE ARCHITECT ANY DISCREPANCIES IN THE PLANS AND SPECIFICATIONS THAT WILL AFFECT THE WORK, PRIOR TO SUBMISSION OF HIS BID PRICE.
4. ELECTRICAL CONTRACTOR SHALL PROVIDE A COMPLETE GROUNDING SYSTEM IN ACCORDANCE WITH THE REQUIREMENTS OF NATIONAL ELECTRICAL CODE. WIRE RACEWAYS, EQUIPMENT ENCLOSURES, AND ANY OTHER NON-CURRENT CARRYING METAL PARTS SHALL BE MECHANICALLY JOINED TOGETHER TO FORM A CONTINUOUS CONDUCTING METALLIC PATH TO ASSURE ELECTRICAL CONTINUITY OF THE GROUNDING CIRCUIT. STRANDED COPPER BONDING JUMPER CABLES AND/OR GROUNDING WIRES SHALL BE INSTALLED WHERE REQUIRED.
5. LABELS SHALL BE PROVIDED FOR ALL RECEPTACLES AND LIGHTING SWITCHES. PROVIDE LABEL INDICATING PANEL NAME AND CIRCUIT NUMBER SERVING RECEPTACLES OR SWITCH. INSTALL LABEL NEAR BOTTOM PORTION OF COVER PLATE. LABELS SHALL BE MADE USING T&B E-Z-CODE LABEL PRINTER SOFTWARE OR EQUAL. LABELS SHALL BE MADE OF CLEAR SELF-LAMINATING VINYL WITH APPROXIMATE 1/8 INCH LETTERING, COLOR BLACK.
6. ALL ELECTRICAL ENCLOSURE AND PANELS SHALL BE CLEARLY MARKED AND EQUIPPED WITH ALL REQUIRED WARNING SIGNS. WIRING CONNECTED TO DIFFERENT VOLTAGE SOURCES SHALL BE CLEARLY MARKED WITH THE NAME AND LOCATION OF THE SOURCE. WARNING SIGNS INDICATING MULTIPLE VOLTAGE SOURCES SHALL BE PLACED IN THE PANELS. SEE NEC, ARTICLE 408 FOR REQUIREMENTS.
7. CONDUITS LEAVING OR ENTERING BUILDING SHALL BE SEALED PER NEC TO PREVENT ENTRANCE OF MOISTURE.
8. FOR 120 VOLT/20 AMP BRANCH CIRCUITS, CONTRACTOR SHALL PROVIDE A SEPARATE NEUTRAL CONDUCTOR FOR EACH PHASE CONDUCTOR.
9. FOR 120 VOLT/20 AMP BRANCH CIRCUITS, CONTRACTOR SHALL NOT RUN MORE THAN THREE PHASE CONDUCTORS PLUS THREE NEUTRAL CONDUCTORS IN A SINGLE CONDUIT.
10. ALL EMPTY CONDUITS SHALL CONTAIN A POLYOLEFIN PULL LINE, JET #232 OR APPROVED EQUAL.
11. ALL WIRING AND CONDUIT SIZES SHALL BE BASED ON THE REQUIREMENTS OF THE NATIONAL ELECTRICAL CODE.
12. ALL CONDUCTORS SHALL BE COPPER WITH THWN/THHN AND RATED FOR 600V UNLESS OTHERWISE INDICATED. TERMINATIONS SHALL BE RATED FOR 75 DEGREES C MINIMUM. DEVIATIONS SHALL COMPLY WITH NEC ARTICLE 110-14(c) FOR EXACT EQUIPMENT BEING PROVIDED.
13. MINIMUM CONDUCTOR SIZE: ALL CIRCUIT HOMERUNS AND ALL CONDUIT-AND-WIRE CIRCUITS SHALL BE #12 AWG UNO ON THE DRAWINGS.
14. MINIMUM SIZE CONDUIT SHALL BE 3/4" DIAMETER UNO.
15. 120 VOLT BRANCH CIRCUITS, WHERE THE LENGTH OF CIRCUIT CONDUCTORS COMPLETE FROM CIRCUIT BREAKER IN SOURCE PANEL TO ANY DEVICE ON THE CIRCUIT IS 0-100 FEET FROM THE PANEL ARE TO HAVE #12 MINIMUM BRANCH CIRCUIT WIRING THROUGHOUT CIRCUIT. (CONDUIT SIZE PER SPECIFICATION AND NEC).
16. 120 VOLT BRANCH CIRCUITS, WHERE THE LENGTH OF CIRCUIT CONDUCTORS COMPLETE FROM CIRCUIT BREAKER IN SOURCE PANEL TO ANY DEVICE ON THE CIRCUIT IS 101-175 FEET FROM THE PANEL ARE TO HAVE #10 MINIMUM BRANCH CIRCUIT WIRING HOMERUN (3/4" C.) FROM PANEL CIRCUIT BREAKER TO FIRST DEVICE AND #12 BRANCH CIRCUIT WIRING THROUGHOUT THE REMAINDER OF THE CIRCUIT. (CONDUIT SIZE PER SPECIFICATION AND NEC). FIRST 75 FEET OF COMBINED HOMERUN AND BRANCH CIRCUIT TO BE MINIMUM #10 WIRE. (3/4" C.)
17. 120 VOLT BRANCH CIRCUITS, WHERE THE LENGTH OF CIRCUIT CONDUCTORS COMPLETE FROM CIRCUIT BREAKER IN SOURCE PANEL TO ANY DEVICE ON THE CIRCUIT IS 176-225 FEET FROM THE PANEL ARE TO HAVE #10 MINIMUM BRANCH CIRCUIT WIRING HOMERUN (3/4" C.) FROM PANEL CIRCUIT BREAKER TO FIRST DEVICE AND #10 BRANCH CIRCUIT WIRING THROUGHOUT THE REMAINDER OF THE CIRCUIT. (CONDUIT SIZE PER SPECIFICATION AND NEC). FIRST 125 FEET OF COMBINED HOMERUN AND BRANCH CIRCUIT TO BE MINIMUM #8 WIRE. (1" C.)
19. EXISTING CONDITIONS AND UTILITIES INDICATED ARE TAKEN FROM EXISTING CONSTRUCTION DOCUMENTS, VARIOUS SURVEYS, AND FIELD INVESTIGATIONS. IT IS TO BE UNDERSTOOD THAT UNFORESEEN CONDITIONS PROBABLY EXIST AND NEW WORK MAY NOT BE FIELD LOCATED EXACTLY AS SHOWN ON THE DRAWINGS. COOPERATION WITH OTHER TRADES IN ROUTING AS DETERMINED DURING CONSTRUCTION AND AS DIRECTED BY THE ARCHITECT/ENGINEER MAY BE NECESSARY AND IT IS INTENDED THAT SUCH DEVIATION SHALL BE CONSIDERED A PART OF THIS CONTRACT. IT IS ALSO UNDERSTOOD THAT THE PLANS ARE NOT COMPLETELY TO SCALE. THIS CONTRACTOR IS TO FIELD VERIFY DIMENSIONS OF ALL UTILITIES, ETC. PRIOR TO BID AND INCLUDE ANY DEVIATION IN THE CONTRACT.
20. PROVIDE BARRIERS IN ALL RACEWAYS, WIREWAYS, ETC. FOR DIFFERENT VOLTAGES.
21. ALL EQUIPMENT SHALL BE FACTORY LISTED AS COMPLYING WITH APPLICABLE STANDARDS OF UNDERWRITER'S LABORATORIES INC. OR OTHER SIMILARLY ESTABLISHED STANDARDS OF A NATIONALLY RECOGNIZED TESTING LABORATORY THAT HAS BEEN CERTIFIED BY OSHA FOR THAT REFERENCE STANDARD.



10748 Deerwood Park Blvd. South
Jacksonville, Florida 32256-0597
904-256-2500 Fax 904-256-2503
www.rsandh.com
FL Cert. Nos. AAC001886 * IB26000956 *
5620 * LCC000210 * GB238



PROJECT TITLE:
JAXPORT CRUISE TERMINAL
GANGWAY MODIFICATION

PROJECT ADDRESS:
9810 AUGUST DRIVE
JACKSONVILLE, FL 32226

REVISIONS

NO.	DESCRIPTION	DATE

DATE ISSUED:	01/24/2025
REVIEWED BY:	LAS
DRAWN BY:	TKH
DESIGNED BY:	LAS
PROJECT NUMBER:	10014153000



SHEET TITLE:
ELECTRICAL GENERAL
NOTES, SYMBOLS AND
ABBREVIATIONS

SHEET ID:

E001

PROJECT STATUS:
100% CONSTRUCTION
DOCUMENTS

BASIC ELECTRICAL MATERIALS AND METHODS

PART 1 - GENERAL

1.1 SUMMARY

- A. DIVISION 26 OF THE SPECIFICATIONS COVERS ALL ELECTRICAL WORK FOR THE PROJECT. WORK SHALL INCLUDE LABOR, MATERIAL, AND ACCESSORIES REQUIRED TO ACCOMPLISH THE WORK.

1.2 SUBMITTALS

- A. SHOP DRAWINGS AND PRODUCT DATA
 - 1. SHOP DRAWINGS SHALL BE SUBMITTED AS INDICATED UNDER EACH SECTION. PROVIDE DIMENSIONED PLANS AND SECTIONS OR ELEVATION LAYOUTS. INCLUDE SUFFICIENT INFORMATION TO INDICATE COMPLETE COMPLIANCE WITH THE SPECIFICATIONS.
 - 2. PRODUCT DATA: SHALL INCLUDE ILLUSTRATIONS, CATALOG SHEETS, INSTALLATION INSTRUCTIONS, DRAWINGS, AND CERTIFICATIONS AS NECESSARY. EACH SHEET SHALL SHOW MANUFACTURER'S NAME OR TRADEMARK.
 - 3. AT THE TIME OF EACH SUBMISSION, ANY DEVIATIONS FROM THE CONTRACT DOCUMENTS SHALL BE CALLED TO THE ATTENTION OF THE OWNER IN WRITING, AND BE PLAINLY MARKED ON THE SHOP DRAWINGS AND PRODUCT DATA.
 - 4. WHERE CATALOG SHEETS SUBMITTED INCLUDE MULTIPLE PRODUCTS NOT DIRECTLY ASSOCIATED WITH THE SPECIFIED PROJECT, THE PRODUCTS SOLELY PERTAINING TO THE SPECIFIED PROJECT SHALL BE PLAINLY MARKED.
- B. RECORD DRAWINGS:

- 1. PROVIDE ONE COMPLETE SET OF CONTRACT DRAWINGS IN CLEAN, UNDAMAGED CONDITION, INDICATING ALL SIGNIFICANT CHANGES FROM THE WORK AS SHOWN. USE MULTIPLE PENCIL COLORS TO AID IN THE DISTINCTION BETWEEN WORK OF SEPARATE ELECTRICAL SYSTEMS. IN GENERAL, RECORD EVERY SUBSTANTIVE INSTALLATION OF ELECTRICAL WORK WHICH PREVIOUSLY IS EITHER NOT SHOWN OR FIELD MODIFIED.
 - a. SHOW EXACT LOCATIONS OF UNDERGROUND CABLE AND CONDUITS INCLUDING PULL BOXES AND HANDHOLES, BOTH INTERIOR AND EXTERIOR, DRAWN TO SCALE AND FULLY DIMENSIONED FROM BUILDING COLUMN LINES.
 - b. INDICATE MAINS AND BRANCHES OF WIRING SYSTEMS, WITH PANELBOARDS AND CONTROL DEVICES LOCATED AND NUMBERED. LOCATE DEVICES REQUIRING MAINTENANCE.

1.3 CODES, PERMITS, AND INSPECTIONS

- A. INSTALLATION SHALL COMPLY WITH ALL LAWS APPLYING TO ELECTRICAL INSTALLATION IN EFFECT, WITH THE REGULATIONS OF THE INTERNATIONAL BUILDING CODE (IBC), NATIONAL ELECTRICAL SAFETY CODE, NATIONAL ELECTRICAL CODE (NEC, NFPA-70), OTHER APPLICABLE PUBLICATIONS OF THE NATIONAL FIRE PROTECTION ASSOCIATION, ALL LOCAL GOVERNING CODES AND ORDINANCES AND WITH THE REGULATIONS OF THE SERVING UTILITY COMPANY. PROVIDE REQUIRED PERMITS.

1.4 DEFINITIONS

- A. EMT: ELECTRICAL METALLIC TUBING.
- B. FMC: FLEXIBLE METAL CONDUIT.
- C. IMC: INTERMEDIATE METAL CONDUIT.
- D. LFMC: LIQUIDTIGHT FLEXIBLE METAL CONDUIT.
- E. RGS: GALVANIZED RIGID STEEL CONDUIT.

1.5 QUALITY ASSURANCE

- A. ELECTRICAL COMPONENTS, DEVICES, AND ACCESSORIES: LISTED AND LABELED AS DEFINED IN NFPA 70, ARTICLE 100, BY A TESTING AGENCY ACCEPTABLE TO AUTHORITIES HAVING JURISDICTION, AND MARKED FOR INTENDED USE.
- B. COMPLY WITH NFPA 70.
- C. MANUFACTURERS' NAMES AND CATALOG NUMBERS
 - 1. IN SOME INSTANCES, SPECIFIC REFERENCES HAVE BEEN MADE TO ONE OR MORE MANUFACTURER'S NAMES AND MODEL OR CATALOG NUMBERS. USE OF NAMES AND CATALOG NUMBERS DOES NOT INDICATE THAT THE EQUIPMENT SPECIFIED IS NECESSARILY AN "OFF THE SHELF" ITEM. VARIANCES MAY BE DUE TO REQUIREMENT OF A DESIRED FINISH, MATERIAL, OR OTHER MODIFICATION.
 - 2. IN THE CASE OF PANELBOARDS, SAFETY SWITCHES AND OTHER EQUIPMENT REQUIRING WIRE AND CABLE TERMINATIONS, ASCERTAIN THAT LUG SIZES AND WIRING GUTTERS OR SPACE ALLOWED FOR PROPER ACCOMMODATION AND TERMINATION OF THE WIRES AND CABLES ARE ADEQUATE.
- D. DRAWINGS ARE DIAGRAMMATIC AND INDICATE THE GENERAL ARRANGEMENT OF SYSTEMS AND WORK. EXACT LOCATIONS ARE SUBJECT TO APPROVAL BY OWNER, WHO RESERVES THE RIGHT TO MAKE REASONABLE CHANGES IN THE LOCATION INDICATED WITHOUT CHANGE IN CONTRACT AMOUNT.

1.6 COORDINATION

- A. COORDINATE CHASES, SLOTS, INSERTS, SLEEVES, AND OPENINGS WITH GENERAL CONSTRUCTION WORK AND ARRANGE IN BUILDING STRUCTURE DURING PROGRESS OF CONSTRUCTION TO FACILITATE THE ELECTRICAL INSTALLATIONS THAT FOLLOW.
- B. SEQUENCE, COORDINATE, AND INTEGRATE INSTALLING ELECTRICAL MATERIALS AND EQUIPMENT FOR EFFICIENT FLOW OF THE WORK. COORDINATE INSTALLATION OF EQUIPMENT WITH OTHER TRADES.
- C. COORDINATE THE INSTALLATION OF ALL LV CONDUIT CONNECTIONS WITH JAXPORT OWNERSHIP.

- D. WHERE ELECTRICAL IDENTIFICATION DEVICES ARE APPLIED TO FIELD-FINISHED SURFACES, COORDINATE INSTALLATION OF IDENTIFICATION DEVICES WITH COMPLETION OF FINISHED SURFACE.
- E. WHERE ELECTRICAL IDENTIFICATION MARKINGS AND DEVICES WILL BE CONCEALED BY ACOUSTICAL CEILINGS AND SIMILAR FINISHES, COORDINATE INSTALLATION OF THESE ITEMS BEFORE CEILING INSTALLATION.

1.7 PROTECTION OF ELECTRICAL EQUIPMENT

- A. ELECTRICAL EQUIPMENT SHALL BE PROTECTED FROM THE WEATHER, IN PARTICULAR, DRIPPING OR SPLASHING WATER, AT ALL TIMES DURING SHIPMENT, STORAGE AND CONSTRUCTION. MANUFACTURER'S RECOMMENDATIONS WITH REGARD TO STORAGE AND PROTECTION SHALL BE FOLLOWED. SHOULD ANY APPARATUS BE SUBJECTED TO POSSIBLE DAMAGE BY WATER, IT SHALL BE THOROUGHLY DRIED AND PUT THROUGH A DIELECTRIC TEST, AT THE EXPENSE OF THE CONTRACTOR, TO ASCERTAIN THE SUITABILITY OF THE APPARATUS. OR IT SHALL BE REPLACED WITHOUT ADDITIONAL COST TO THE OWNER.
- B. DAMAGED OR DEFECTIVE EQUIPMENT: INSPECT ALL ELECTRICAL EQUIPMENT AND MATERIALS PRIOR TO INSTALLATION. DAMAGED EQUIPMENT AND MATERIALS SHALL NOT BE INSTALLED OR PLACED IN SERVICE. REPLACE OR REPAIR TO NEW CONDITION AND TEST REPAIRED EQUIPMENT IN COMPLIANCE WITH INDUSTRY STANDARDS AT NO ADDITIONAL COST TO THE OWNER. EQUIPMENT REQUIRED FOR THE TEST SHALL BE PROVIDED BY THE CONTRACTOR.

PART 2 - PRODUCTS

2.1 RACEWAYS

- A. EMT: ANSI C80.3, ZINC-COATED STEEL, WITH SET-SCREW OR COMPRESSION FITTINGS. LIMITED USE EXPECTED.
- B. FMC: ZINC-COATED STEEL.
- C. IMC: ANSI C80.6, ZINC-COATED STEEL, WITH THREADED FITTINGS. LIMITED USE EXPECTED.
- D. LFMC: ZINC-COATED STEEL, WITH SUNLIGHT-RESISTANT AND MINERAL-OIL-RESISTANT PLASTIC JACKET.
 - 1. MANUFACTURED BY HOFFMAN, SQUARE D, OR APPROVED EQUAL.
- 2. MATERIAL AND CONSTRUCTION: SHEET METAL SIZED AND SHAPED AS INDICATED. NEMA 3R AND 4X.
- 3. FITTINGS AND ACCESSORIES: INCLUDE COUPLINGS, OFFSETS, ELBOWS, EXPANSION JOINTS, ADAPTERS, HOLD-DOWN STRAPS, END CAPS, AND OTHER FITTINGS TO MATCH AND MATE WITH WIREWAYS AS REQUIRED FOR COMPLETE SYSTEM.
- 4. SELECT FEATURES, UNLESS OTHERWISE INDICATED, AS REQUIRED TO COMPLETE WIRING SYSTEM AND TO COMPLY WITH NFPA 70.
- 5. FINISH: MANUFACTURER'S STANDARD ENAMEL FINISH.
- E. PVC SCHEDULE 40: POLY (VINYL CHLORIDE), ATSM D 2466
- F. RNC: NEMA TC 2, SCHEDULE 40 PVC, WITH NEMA TC3 FITTINGS.
- G. RACEWAY FITTINGS: SPECIFICALLY DESIGNED FOR THE RACEWAY TYPE WITH WHICH USED.

2.2 CONDUCTORS

- A. CONDUCTORS, NO. 10 AWG AND SMALLER: SOLID OR STRANDED COPPER.
- B. CONDUCTORS, LARGER THAN NO. 10 AWG: STRANDED COPPER.
- C. INSULATION: 600V, THWN-2
- D. WIRE CONNECTORS AND SPLICES: UNITS OF SIZE, AMPACITY RATING, MATERIAL, TYPE, AND CLASS SUITABLE FOR SERVICE INDICATED.

2.3 BOXES, ENCLOSURES, AND CABINETS

- A. SHEET MEAL OUTLET AND DEVICE BOXES: NEMA 3R.
- B. CAST-METAL OUTLET AND DEVICE BOXES: NEMA 3R, TYPE FD, WITH GASKETED COVER.
- C. SMALL SHEET METAL PULL AND JUNCTION BOXES: NEMA 3R.
- D. CAST-METAL PULL AND JUNCTION BOXES: NEMA 3R, CAST PVC WITH GASKETED COVER UNLESS OTHERWISE SPECIFIED ON DRAWINGS.
- E. HINGED-COVER ENCLOSURES: NEMA 250, TYPE 4X, WITH CONTINUOUS HINGE COVER AND FLUSH LATCH.
 - 1. METAL ENCLOSURES: STEEL, FINISHED INSIDE AND OUT WITH MANUFACTURER'S STANDARD ENAMEL.
- F. FINISH: FOR ENCLOSURE OR CABINET COMPONENTS, PROVIDE MANUFACTURER'S STANDARD COLOR PAINT APPLIED AFTER FABRICATION TO FACTORY-ASSEMBLED SURFACE RACEWAYS, ENCLOSURES, AND CABINETS BEFORE SHIPPING.

2.4 SUPPORTING DEVICES

- A. MATERIAL: COLD-FORMED STEEL WITH CORROSION-RESISTANT COATING ACCEPTABLE TO AUTHORITIES HAVING JURISDICTION.
- B. METAL ITEMS FOR USE OUTDOORS OR IN DAMP LOCATIONS: HOT-DIP GALVANIZED STEEL.
- C. SLOTTED-STEEL CHANNEL SUPPORTS: FLANGE EDGES TURNED TOWARD WEB, AND 9/16 - INCH DIAMETER SLOTTED HOLES AT A MAXIMUM OF 2 INCHES O.C., IN WEBS.
- D. SLOTTED-STEEL CHANNEL SUPPORTS:
 - 1. CHANNEL THICKNESS: SELECTED TO SUIT STRUCTURAL LOADING.
 - 2. FITTINGS AND ACCESSORIES: PRODUCTS OF THE SAME MANUFACTURER AS CHANNEL SUPPORTS.
- E. NONMETALLIC CHANNEL AND ANGLE SYSTEMS: STRUCTURAL-GRADE, FACTORY-FORMED, GLASS-FIBER-RESIN CHANNELS AND ANGLES WITH 9/16 INCH DIAMETER HOLES AT A MAXIMUM OF 8 INCHES O.C., IN AT LEAST ONE SURFACE.

- 1. FITTINGS AND ACCESSORIES: PRODUCTS OF THE SAME MANUFACTURER AS CHANNELS AND ANGLES.
- 2. FITTINGS AND ACCESSORY MATERIALS: SAME AS CHANNELS AND ANGLES, EXCEPT METAL ITEMS MAY BE STAINLESS STEEL.

- F. RACEWAY AND CABLE SUPPORTS: MANUFACTURED CLEVIS HANGERS, RISER CLAMPS, STRAPS, THREADED C-CLAMPS WITH RETAINERS, CEILING TRAPEZE HANGERS, WALL BRACKETS, AND SPRING-STEEL CLAMPS OR CLICK-TYPE HANGERS.

- G. PIPE SLEEVES: ASTM A53, TYPE E, GRADE A, SCHEDULE 40, GALVANIZED STEEL, PLAIN ENDS.

- H. EXPANSION ANCHORS: CARBON-STEEL WEDGE OR SLEEVE TYPE.

- I. TOGGLE BOLTS: ALL-STEEL SPRINGHEAD TYPE.

- J. POWDER-DRIVEN THREADED STUDS: HEAT-TREATED STEEL.

2.5 ELECTRICAL IDENTIFICATION

- A. IDENTIFICATION DEVICES: A SINGLE TYPE OF IDENTIFICATION PRODUCT FOR EACH APPLICATION CATEGORY. USE COLORS PRESCRIBED BY ANSI A13.1, NFPA 70, AND THESE SPECIFICATIONS.
- B. RACEWAY AND CABLE LABELS: COMPLY WITH ANSI 13.1 TABLE 3, FOR MINIMUM SIZE OF LETTERS FOR LEGEND AND MINIMUM LENGTH OF COLOR FIELD FOR EACH RACEWAY AND CABLE SIZE.
- C. COLORED ADHESIVE MARKING TAPE FOR RACEWAYS, WIRES, AND CABLES: SELF-ADHESIVE VINYL TAPE, NOT LESS THAN 1 INCH WIDE BY 3 MILS THICK.
- D. TAPE MARKERS FOR WIRE: VINYL-CLOTH, SELF-ADHESIVE, WRAPAROUND TYPE WITH PREPRINTED NUMBERS AND LETTERS.
- E. ENGRAVED-PLASTIC LABELS, SIGNS, AND INSTRUCTION PLATES: ENGRAVING STOCK, MELAMINE PLASTIC LAMINATE PUNCHED OR DRILLED FOR MECHANICAL FASTENERS 1/16-INCH MINIMUM THICKNESS FOR SIGNS UP TO 20 SQ. IN. AND 1/8-INCH MINIMUM THICKNESS FOR LARGER SIZES. LABELS SHALL BE COLOR CODED ACCORDING TO SERVICE/USE OR VOLTAGE AS SCHEDULED HEREIN. LETTERS SHALL BE ENGRAVE, 5/32-INCH HIGH AND ALL CAPITALS.

SERVICE	SURFACE COLOR	LETTER COLOR
POWER: 480 V	WHITE	BLACK
POWER 240 V (208 V)	YELLOW	BLACK
SECURITY	GREEN	WHITE
TELEVISION/VIDEO	PURPLE	WHITE
- F. INTERIOR WARNING AND CAUTION SIGNS: COMPLY WITH 29 CFR, CHAPTER XVII, PART 1910.145, PREPRINTED, ALUMINUM, BAKED-ENAMEL-FINISH SIGNS, PUNCHED OR DRILLED FOR MECHANICAL FASTENERS, WITH COLORS, LEGEND, AND SIZE APPROPRIATE TO THE APPLICATION.
- G. FASTENERS FOR NAMEPLATES AND SIGNS: SELF-TAPING, STAINLESS-STEEL SCREWS OR NO. 10/32 STAINLESS-STEEL MACHINE SCREWS WITH NUTS AND FLAT AND LOCK WASHERS.
- H. RECEPTACLES: TRANSPARENT, VINYL OR MYLAR, ADHESIVE-BACKED LABELS HAVING MACHINE PRINTING WITH BLACK NUMBERS AND LETTERS.

2.6 TOUCHUP PAINT

- A. FOR EQUIPMENT: EQUIPMENT MANUFACTURER'S PAINT SELECTED TO MATCH INSTALLED EQUIPMENT FINISH.

PART 3 - EXECUTION

3.1 ELECTRICAL EQUIPMENT INSTALLATION

- A. HEADROOM MAINTENANCE: IF MOUNTING HEIGHTS OR OTHER LOCATION CRITERIA ARE NOT INDICATED, ARRANGE AND INSTALL COMPONENTS AND EQUIPMENT TO PROVIDE THE MAXIMUM POSSIBLE HEADROOM.
- B. MATERIALS AND COMPONENTS: INSTALL LEVEL, PLUMB, AND PARALLEL AND PERPENDICULAR TO OTHER BUILDING SYSTEMS AND COMPONENTS, UNLESS OTHERWISE INDICATED.
- C. EQUIPMENT: INSTALL TO FACILITATE SERVICE, MAINTENANCE, AND REPAIR OR REPLACEMENT OF COMPONENTS. CONNECT FOR EASE OF DISCONNECTING, WITH MINIMUM INTERFERENCE WITH OTHER INSTALLATIONS.
- D. RIGHT OF WAY: GIVE RACEWAYS AND PIPING SYSTEMS INSTALLED AT A REQUIRED SLOPE.
- E. WORKING CLEARANCE: WORKING CLEARANCES AROUND EQUIPMENT REQUIRING ELECTRICAL SERVICE SHALL COMPLY WITH NEC REQUIREMENTS. NOTIFY THE OWNER OF VIOLATIONS BEFORE PROCEEDING WITH CONNECTION OR PLACEMENT OF EQUIPMENT.

3.2 RACEWAY APPLICATION

- A. USE THE FOLLOWING RACEWAYS FOR OUTDOOR INSTALLATIONS:
 - 1. EXPOSED: RGS / PVC.
 - 2. CONNECTION TO VIBRATING EQUIPMENT: LFMC.
 - 3. BOXES AND MWV: NEMA 250, TYPE 4X, UNLESS OTHERWISE SPECIFIED
- 4. ENCLOSURES: NEMA 250, TYPE 4X, UNLESS OTHERWISE SPECIFIED
- B. USE THE FOLLOWING RACEWAYS FOR INDOOR INSTALLATIONS:
 - 1. EXPOSED: RGS.
 - 2. CONCEALED: RGS.
 - 3. CONNECTION TO VIBRATING EQUIPMENT: FMC; EXCEPT IN WET OR DAMP LOCATIONS, USE LFMC.
 - 4. DAMP OR WET LOCATIONS: IMC OR LFMC.
 - 5. BOXES, SMR, AND ENCLOSURES: NEMA 250, TYPE 1, UNLESS OTHERWISE INDICATED.
- C. MINIMUM RACEWAY SIZE: FOR POWER AND CONTROL: 3/4-INCH TRADE SIZE. FOR TELECOMMUNICATIONS (COMM): 3/4-INCH TRADE SIZE.

3.3 RACEWAY AND CABLE INSTALLATION

- A. INSTALL RACEWAYS AND CABLES AT LEAST 6 INCHES AWAY FROM PARALLEL RUNS OF FLUES AND STEAM OR HOT-WATER PIPES. LOCATE HORIZONTAL RACEWAY RUNS ABOVE WATER AND STEAM PIPING.
- B. USE TEMPORARY RACEWAY CAPS TO PREVENT FOREIGN MATTER FROM ENTERING.
- C. MAKE CONDUIT BENDS AND OFFSETS SO INTERIOR DIAMETER IS NOT REDUCED. KEEP LEGS OF BENDS IN THE SAME PLANE AND STRAIGHT LEGS OF OFFSETS PARALLEL, UNLESS OTHERWISE INDICATED.
- D. USE RACEWAY AND CABLE FITTINGS COMPATIBLE WITH RACEWAYS AND CABLES AND SUITABLE FOR USE AND LOCATION.
 - 1. USE INSULATING BUSHINGS TO PROTECT CONDUCTORS.



10748 Deerwood Park Blvd. South
Jacksonville, Florida 32256-0597
904-256-2500 Fax 904-256-2503
www.rsandh.com
FL Cert. Nos. AAC001886 * IB26000956 *
5620 * LCC000210 * GB238



PROJECT TITLE:
JAXPORT CRUISE TERMINAL
GANGWAY MODIFICATION

PROJECT ADDRESS:
9810 AUGUST DRIVE
JACKSONVILLE, FL 32226

REVISIONS

NO.	DESCRIPTION	DATE

DATE ISSUED:	01/24/2025
REVIEWED BY:	LAS
DRAWN BY:	TKH
DESIGNED BY:	LAS
PROJECT NUMBER:	10014153000





SHEET TITLE:
ELECTRICAL
SPECIFICATIONS

SHEET ID:


E002

PROJECT STATUS:
100% CONSTRUCTION
DOCUMENTS

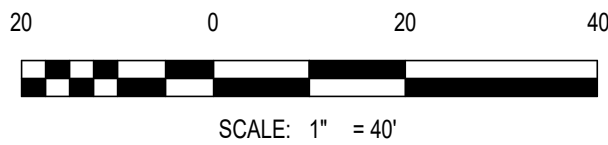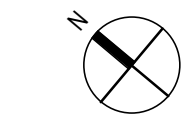

1 ELECTRICAL SITE PLAN

SCALE: 1" = 40'-0"

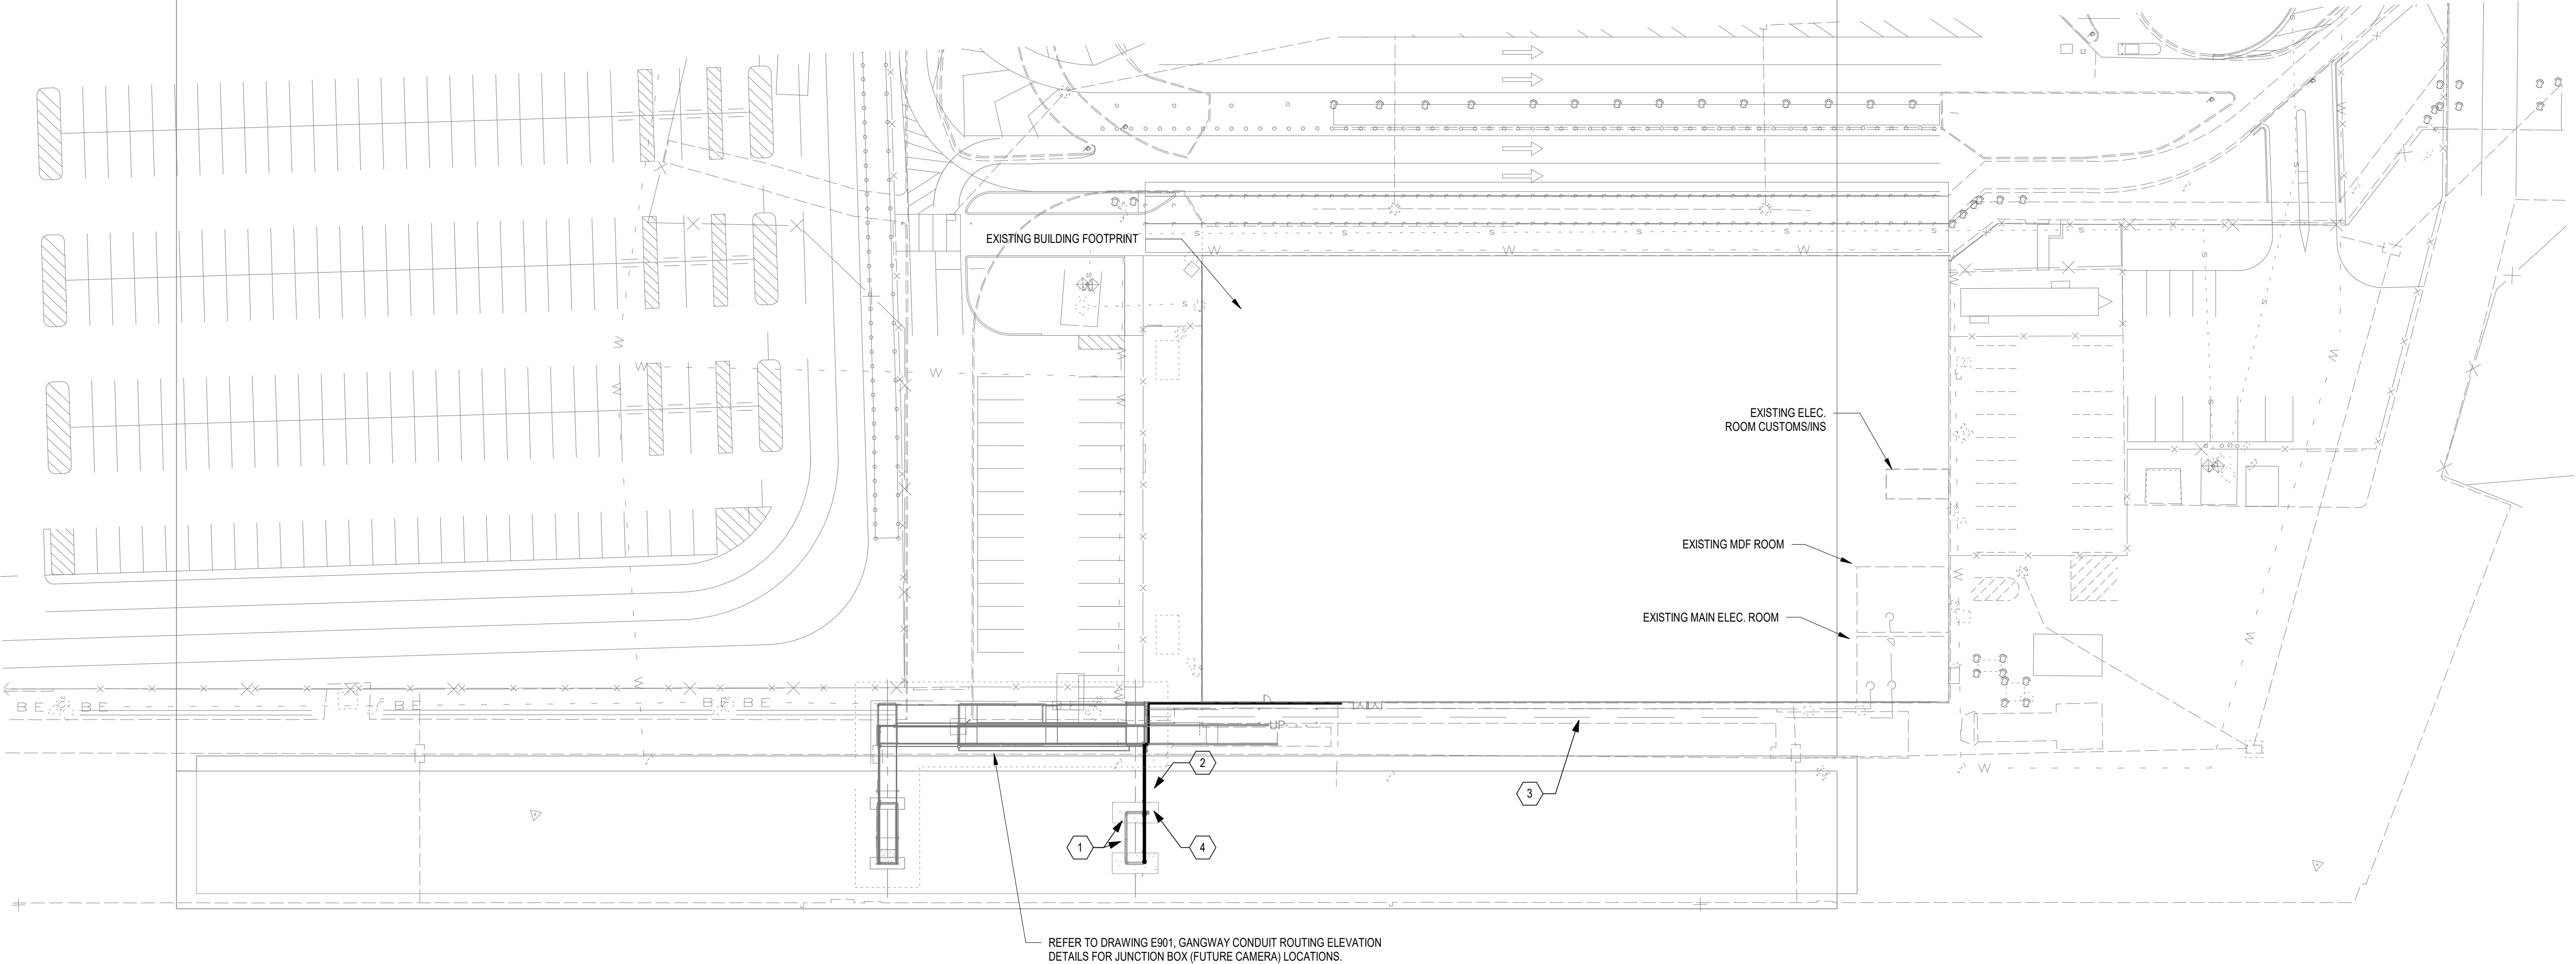

KEYED NOTES:

1. PROPOSED NEW CHAIN HOIST MOTOR AND ASSOCIATED CONTROLS, FURNISHED BY OTHERS AND INSTALLED BY ELECTRICAL CONTRACTOR. COORDINATE EXACT LOCATION WITH STRUCTURAL DRAWINGS, PRIOR TO COMMENCEMENT OF WORK. PROVIDE 3#10,1#10EG - 2" C FROM HB - 20,22,24.
2. PROVIDE SURFACE MOUNTED UV RESISTANT SCHEDULE 40 PVC OR GREATER CONDUIT TO EXISTING AND NEW GANGWAY FOR NEW CHAIN HOIST MOTOR. REFER TO EXISTING PANEL SCHEDULE, ON SHEET E901 FOR CONDUIT AND CONDUCTOR SIZES.
3. PROVIDE 2" SURFACE MOUNTED UV RESISTANT SCHEDULE 40 PVC OR GREATER CONDUIT WITH PULL CORD TO EXISTING AND NEW GANGWAY FOR FUTURE CAMERAS. PROPOSED CONDUIT ROUTING IS SHOWN ON DRAWING E901, GANGWAY CONDUIT ROUTING ELEVATION. ROUTING INDICATED IS FOR ILLUSTRATION PURPOSES. COORDINATE EXACT PATHWAY AND ROUTING WITH BEST PRACTICES OF MEANS AND METHODS.
4. PROVIDE SURFACE MOUNTED 6"X12"X12" UV RESISTANT SCHEDULE 40 PVC OR GREATER JUNCTION BOX TO NEW GANGWAY FOR PROPOSED CAMERA(S). QUANTITIES AND LOCATIONS ARE DEFINED ON SHEET E901, GANGWAY CONDUIT ROUTING ELEVATION.

RS&H
10748 Deerwood Park Blvd. South
Jacksonville, Florida 32256-0597
904-256-2500 Fax 904-256-2503
www.rsandh.com
FL Cert. Nos. AAC001886 * IB26000956 *
5620 * LCC000210 * GB238



PROJECT TITLE:
JAXPORT CRUISE TERMINAL
GANGWAY MODIFICATION

PROJECT ADDRESS:
9810 AUGUST DRIVE
JACKSONVILLE, FL 32226

REVISIONS

NO.	DESCRIPTION	DATE

DATE ISSUED: 01/24/2025
REVIEWED BY: LAS
DRAWN BY: TKH
DESIGNED BY: LAS
PROJECT NUMBER:
10014153000



SHEET TITLE:
ELECTRICAL SITE
PLAN

SHEET ID:

ES101

PROJECT STATUS:
100% CONSTRUCTION
DOCUMENTS

PANEL ID: HB													
POWER SUPPLIED FROM MDP				VOLTAGE: 480/277 Wye				KAIC RATING: 18 kAIC					
MOUNTING: Surface				PHASE: 3				LUG RATING: 600 A					
ENCLOSURE: Type 1				WIRES: 4				MAIN OCPD RATING: MLO					
CIRCUIT DESCRIPTION	TRIP	POLE	CKT	A		B		C		CKT	POLE	TRIP	CIRCUIT DESCRIPTION
EXISTING LOAD	20 A	3	1	0 kVA	0 kVA					2	3	50 A	EXISTING LOAD
			3			0 kVA	0 kVA			4			
			5					0 kVA	0 kVA	6			
EXISTING LOAD	35 A	3	7	0 kVA	0 kVA					8	3	50 A	EXISTING LOAD
			9			0 kVA	0 kVA			10			
			11					0 kVA	0 kVA	12			
GANGWAY LIGHTING	20 A	2	13	0.7 kVA	0 kVA					14	3	50 A	EXISTING LOAD
SPARE	20 A	1	15			0.7 kVA	0 kVA			16			
			17					0 kVA	0 kVA	18			
EXISTING LOAD	50 A	3	19	0 kVA	6.1 kVA					20	3	30 A	HOIST (GANGWAY)
			21			0 kVA	6.1 kVA			22			
			23					0 kVA	6.1 kVA	24			
EXISTING LOAD	50 A	3	25	0 kVA	0 kVA					26	3	20 A	EXISTING LOAD
			27			0 kVA	0 kVA			28			
			29					0 kVA	0 kVA	30			
EXISTING LOAD	50 A	3	31	0 kVA	0 kVA					32	3	50 A	EXISTING LOAD
			33			0 kVA	0 kVA			34			
			35					0 kVA	0 kVA	36			
EXISTING LOAD	50 A	3	37	0 kVA	0 kVA					38	3	50 A	EXISTING LOAD
			39			0 kVA	0 kVA			40			
			41					0 kVA	0 kVA	42			
Total Amps:			24.9 A		25 A		22 A						
Total Load:			6.80 kVA		6.80 kVA		6.10 kVA						
LOAD CLASSIFICATION:			CONNECTED LOAD		DEMAND FACTOR		ESTIMATED DEMAND		PANEL TOTALS				
Spare			19700 VA		100.00%		19700 VA						
									kVA (CONNECTED): 19.7 kVA				
									kVA (ESTIMATED DEMAND): 19.7 kVA				
									CURRENT (CONNECTED): 23.7 A				
									CURRENT (ESTIMATED DEMAND): 23.7 A				
NOTES:													
1. BOLD TEXT INDICATES NEW WORK.													

PANEL ID: LB													
POWER SUPPLIED FROM DP				VOLTAGE: 120/208 Wye						kAIC RATING: 10 kAIC			
MOUNTING: Surface				PHASE: 3						LUG RATING: 225 A			
ENCLOSURE: Type 1				WIRES: 4						MAIN OCPD RATING: MLO			
CIRCUIT DESCRIPTION	TRIP	POLE	CKT	A		B		C		CKT	POLE	TRIP	CIRCUIT DESCRIPTION
				0 kVA	0 kVA								
EXISTING LOAD	20 A	1	1							2	1	20 A	EXISTING LOAD
EXISTING LOAD	20 A	1	3			0 kVA	0 kVA			4	1	20 A	EXISTING LOAD
EXISTING LOAD	20 A	1	5					0 kVA	0 kVA	6	1	20 A	EXISTING LOAD
EXISTING LOAD	20 A	1	7	0 kVA	0 kVA					8	1	20 A	EXISTING LOAD
EXISTING LOAD	20 A	1	9			0 kVA	--			10	1	--	(SPACE)
EXISTING LOAD	20 A	1	11					0 kVA	0 kVA	12	1	20 A	EXISTING LOAD
EXISTING LOAD	20 A	1	13	0 kVA	--					14	1	--	(SPACE)
EXISTING LOAD	20 A	1	15			0 kVA	0 kVA			16	1	20 A	EXISTING LOAD
EXISTING LOAD	20 A	1	17					0 kVA	0 kVA	18	1	20 A	EXISTING LOAD
EXISTING LOAD	20 A	1	19	0 kVA	0 kVA					20	1	20 A	EXISTING LOAD
EXISTING LOAD	20 A	1	21			0 kVA	0 kVA			22	1	20 A	EXISTING LOAD
EXISTING LOAD	20 A	1	23					0 kVA	0 kVA	24	1	20 A	EXISTING LOAD
EXISTING LOAD	20 A	1	25	0 kVA	0 kVA					26	1	20 A	EXISTING LOAD
EXISTING LOAD	20 A	1	27			0 kVA	0 kVA			28	1	20 A	EXISTING LOAD
EXISTING LOAD	20 A	1	29					0 kVA	0 kVA	30	1	20 A	EXISTING LOAD
EXISTING LOAD	20 A	1	31	0 kVA	--					32	1	--	(SPACE)
EXISTING LOAD	20 A	1	33			0 kVA	0 kVA			34	1	20 A	EXISTING LOAD
EXISTING LOAD	20 A	1	35					0 kVA	0 kVA	36	1	20 A	EXISTING LOAD
EXISTING LOAD	20 A	1	37	0 kVA	0 kVA					38	1	20 A	EXISTING LOAD
EXISTING LOAD	50 A	2	39			0 kVA	0 kVA			40	1	20 A	GANGWAY FANS
			41					0 kVA	0 kVA	42	1	20 A	GANGWAY RECS
Total Amps:				0.0 A		0 A		0 A					
Total Load:				0.00 kVA		0.00 kVA		0.00 kVA					
LOAD CLASSIFICATION:				CONNECTED LOAD		DEMAND FACTOR		ESTIMATED DEMAND		PANEL TOTALS			
										kVA (CONNECTED): 0.0 kVA			
										kVA (ESTIMATED DEMAND): 0.0 kVA			
										CURRENT (CONNECTED): 0.0 A			
										CURRENT (ESTIMATED DEMAND): 0.0 A			
NOTES:													
1. BOLD TEXT INDICATES NEW WORK.													



10748 Deerwood Park Blvd. South
Jacksonville, Florida 32256-0597
904-256-2500 Fax 904-256-2503
www.rsandh.com
FL Cert. Nos. AAC001886 * IB26000956 *
5620 * LCC000210 * GB238



PROJECT TITLE:
JAXPORT CRUISE TERMINAL
GANGWAY MODIFICATION

PROJECT ADDRESS:
9810 AUGUST DRIVE
JACKSONVILLE, FL 32226

NO.	DESCRIPTION	DATE


DATE ISSUED: 01/24/2025

REVIEWED BY: LAS

DRAWN BY: TKH

DESIGNED BY: LAS

PROJECT NUMBER:
10014153000

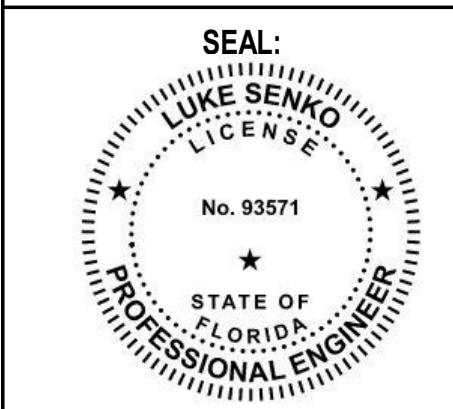


SHEET TITLE:
ELECTRICAL PANEL
SCHEDULES

SHEET ID:


E601

PROJECT STATUS:
100% CONSTRUCTION
DOCUMENTS

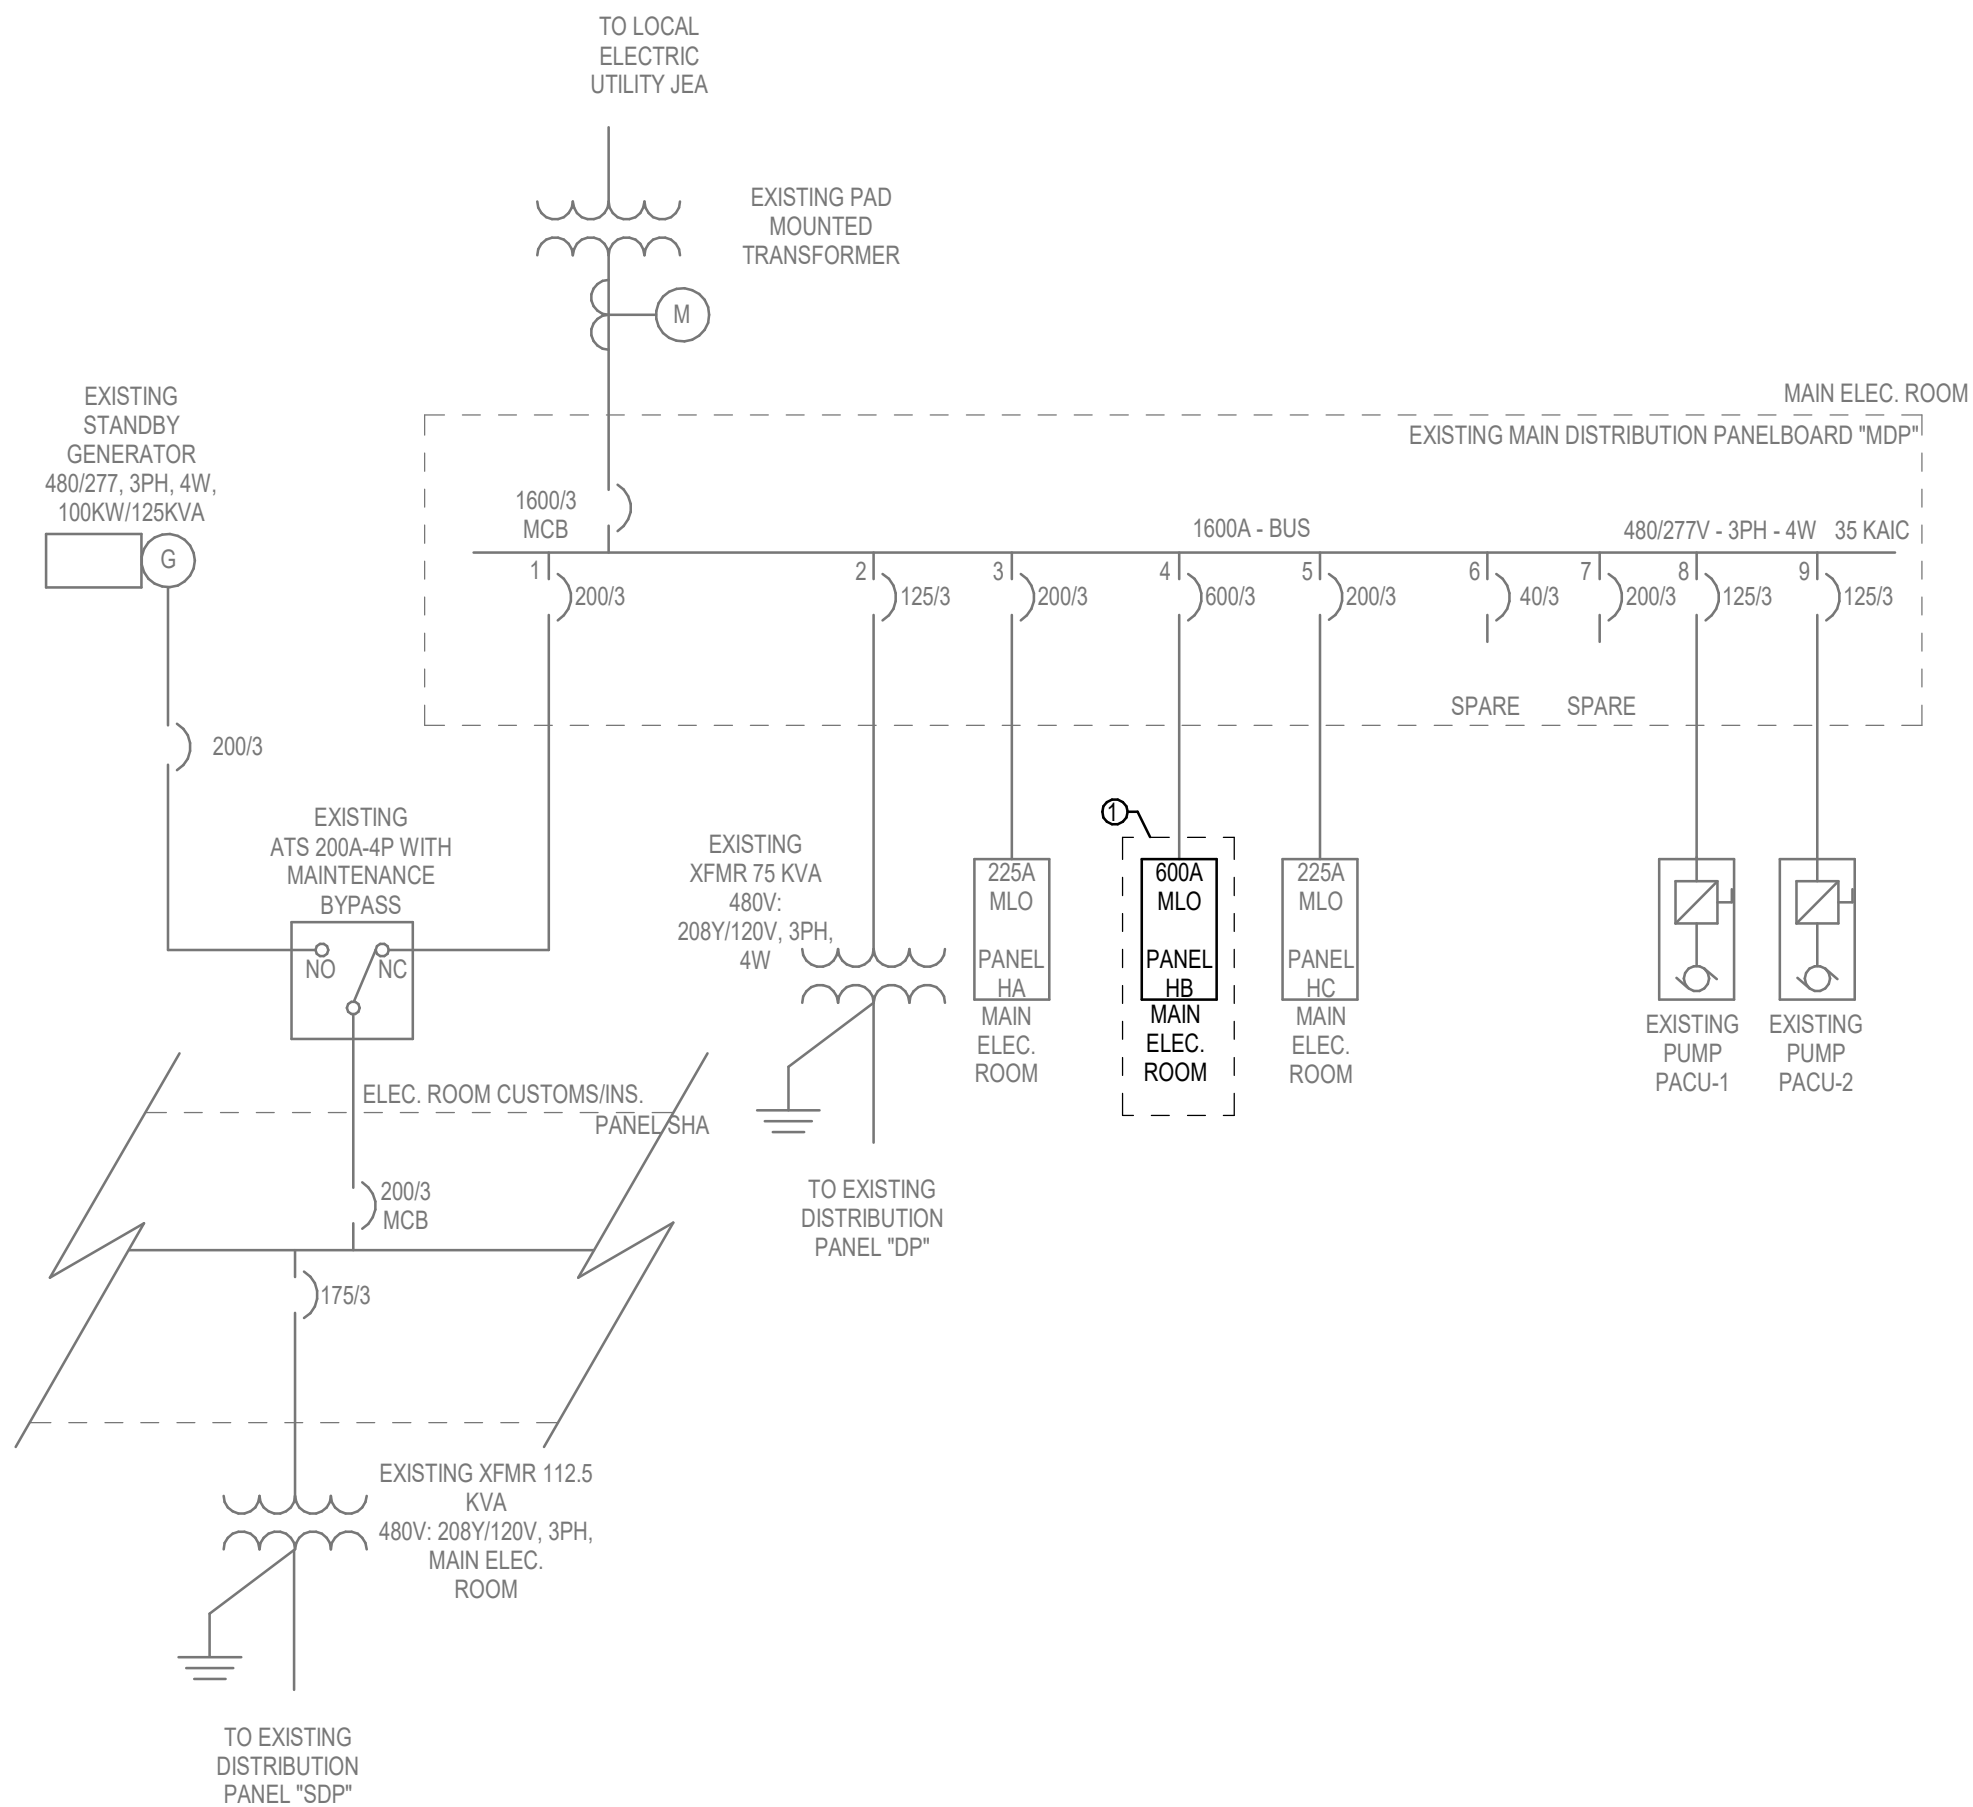


PARTIAL ONE-LINE DIAGRAM-EXISTING BUILDING

SCALE: N.T.S.

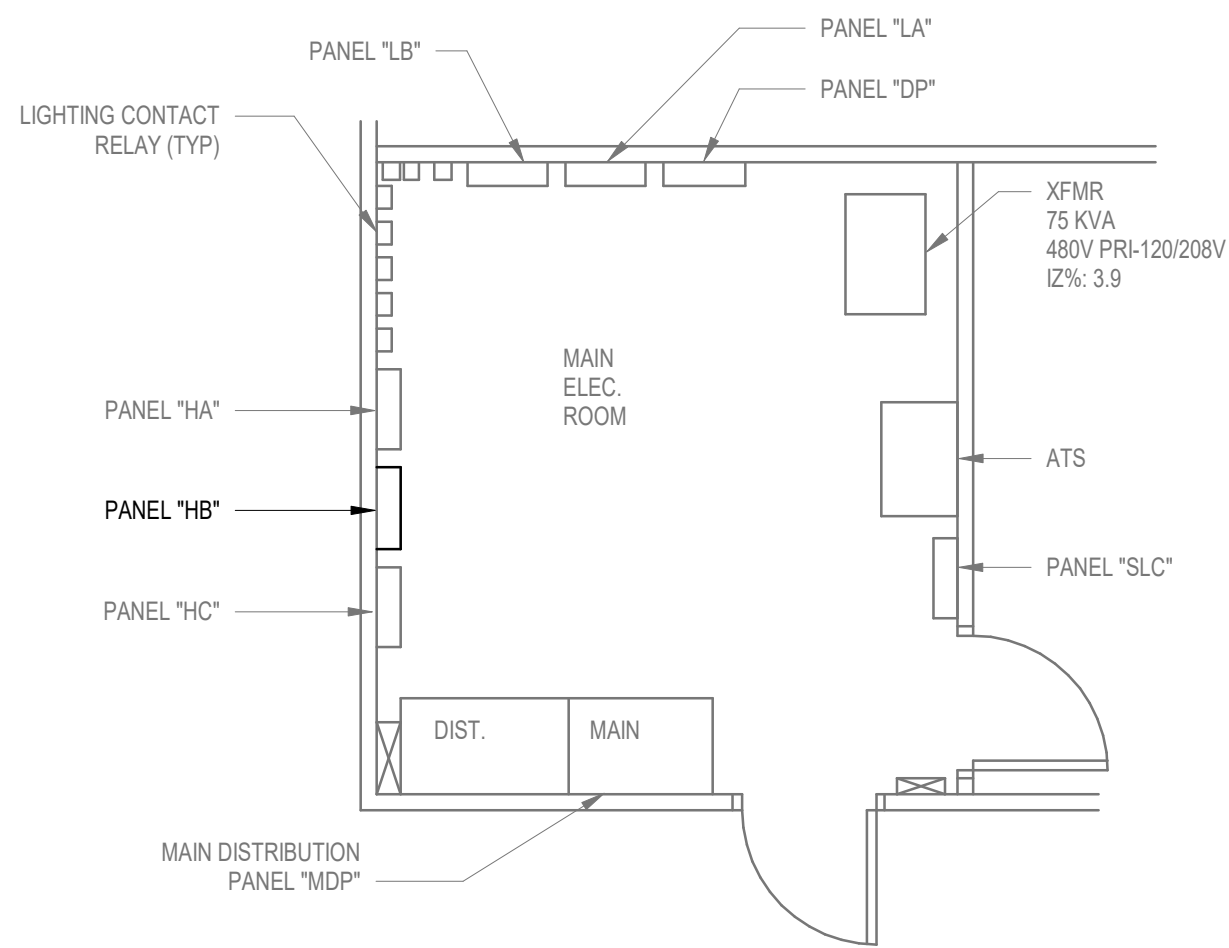

MAIN ELEC. ROOM EXISTING LAYOUT

SCALE: 1/4" = 1'-0"

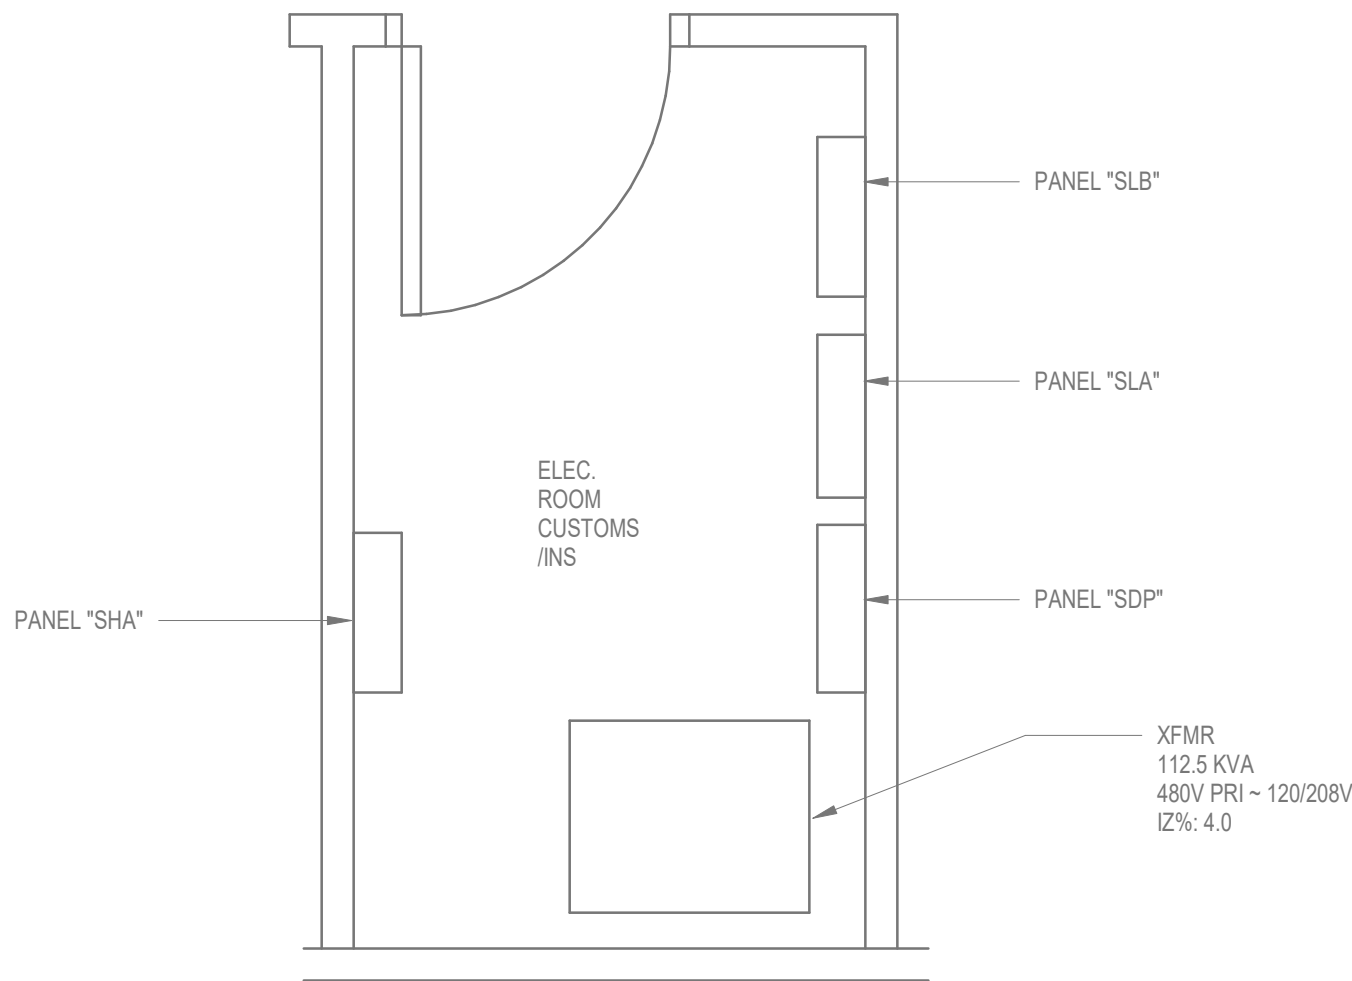

ELEC. ROOM CUSTOMS/INS EXISTING LAYOUT

SCALE: 1/2" = 1'-0"

GENERAL NOTES:

1. ALL ELECTRICAL EQUIPMENT SHOWN ON THIS SHEET IS EXISTING TO REMAIN, UNLESS OTHERWISE NOTED. REFER TO EXISTING PANELBOARD SCHEDULE FOR ADDITIONAL INFORMATION.

KEYED NOTES:

1. REFER TO EXISTING PANELBOARD SCHEDULE FOR ADDITIONAL INFORMATION, SHEET E601.



10748 Deerwood Park Blvd. South
Jacksonville, Florida 32256-0597
904-256-2500 Fax 904-256-2503
www.rsandh.com
FL Cert. Nos. AAC001886 * IB26000956 *
5620 * LCC000210 * GB238



PROJECT TITLE:
JAXPORT CRUISE TERMINAL
GANGWAY MODIFICATION

PROJECT ADDRESS:
9810 AUGUST DRIVE
JACKSONVILLE, FL 32226

REVISIONS		
NO.	DESCRIPTION	DATE

DATE ISSUED: 01/24/2025
REVIEWED BY: LAS
DRAWN BY: TKH
DESIGNED BY: LAS
PROJECT NUMBER: 10014153000



SHEET TITLE:
ELECTRICAL ONE LINE
DIAGRAM


SHEET ID:

E701

PROJECT STATUS:
100% CONSTRUCTION
DOCUMENTS

1/24/2025 2:21:25 PM Autodesk Docs://10014153019_DPMT CT GANGWAY MOD/10014153019_JAXPORT Cruise Gangway_E_R22.rvt

FOR CONTINUATION, REFER TO KEYED NOTE ON ELECTRICAL SITE PLAN ON SHEET ES101.

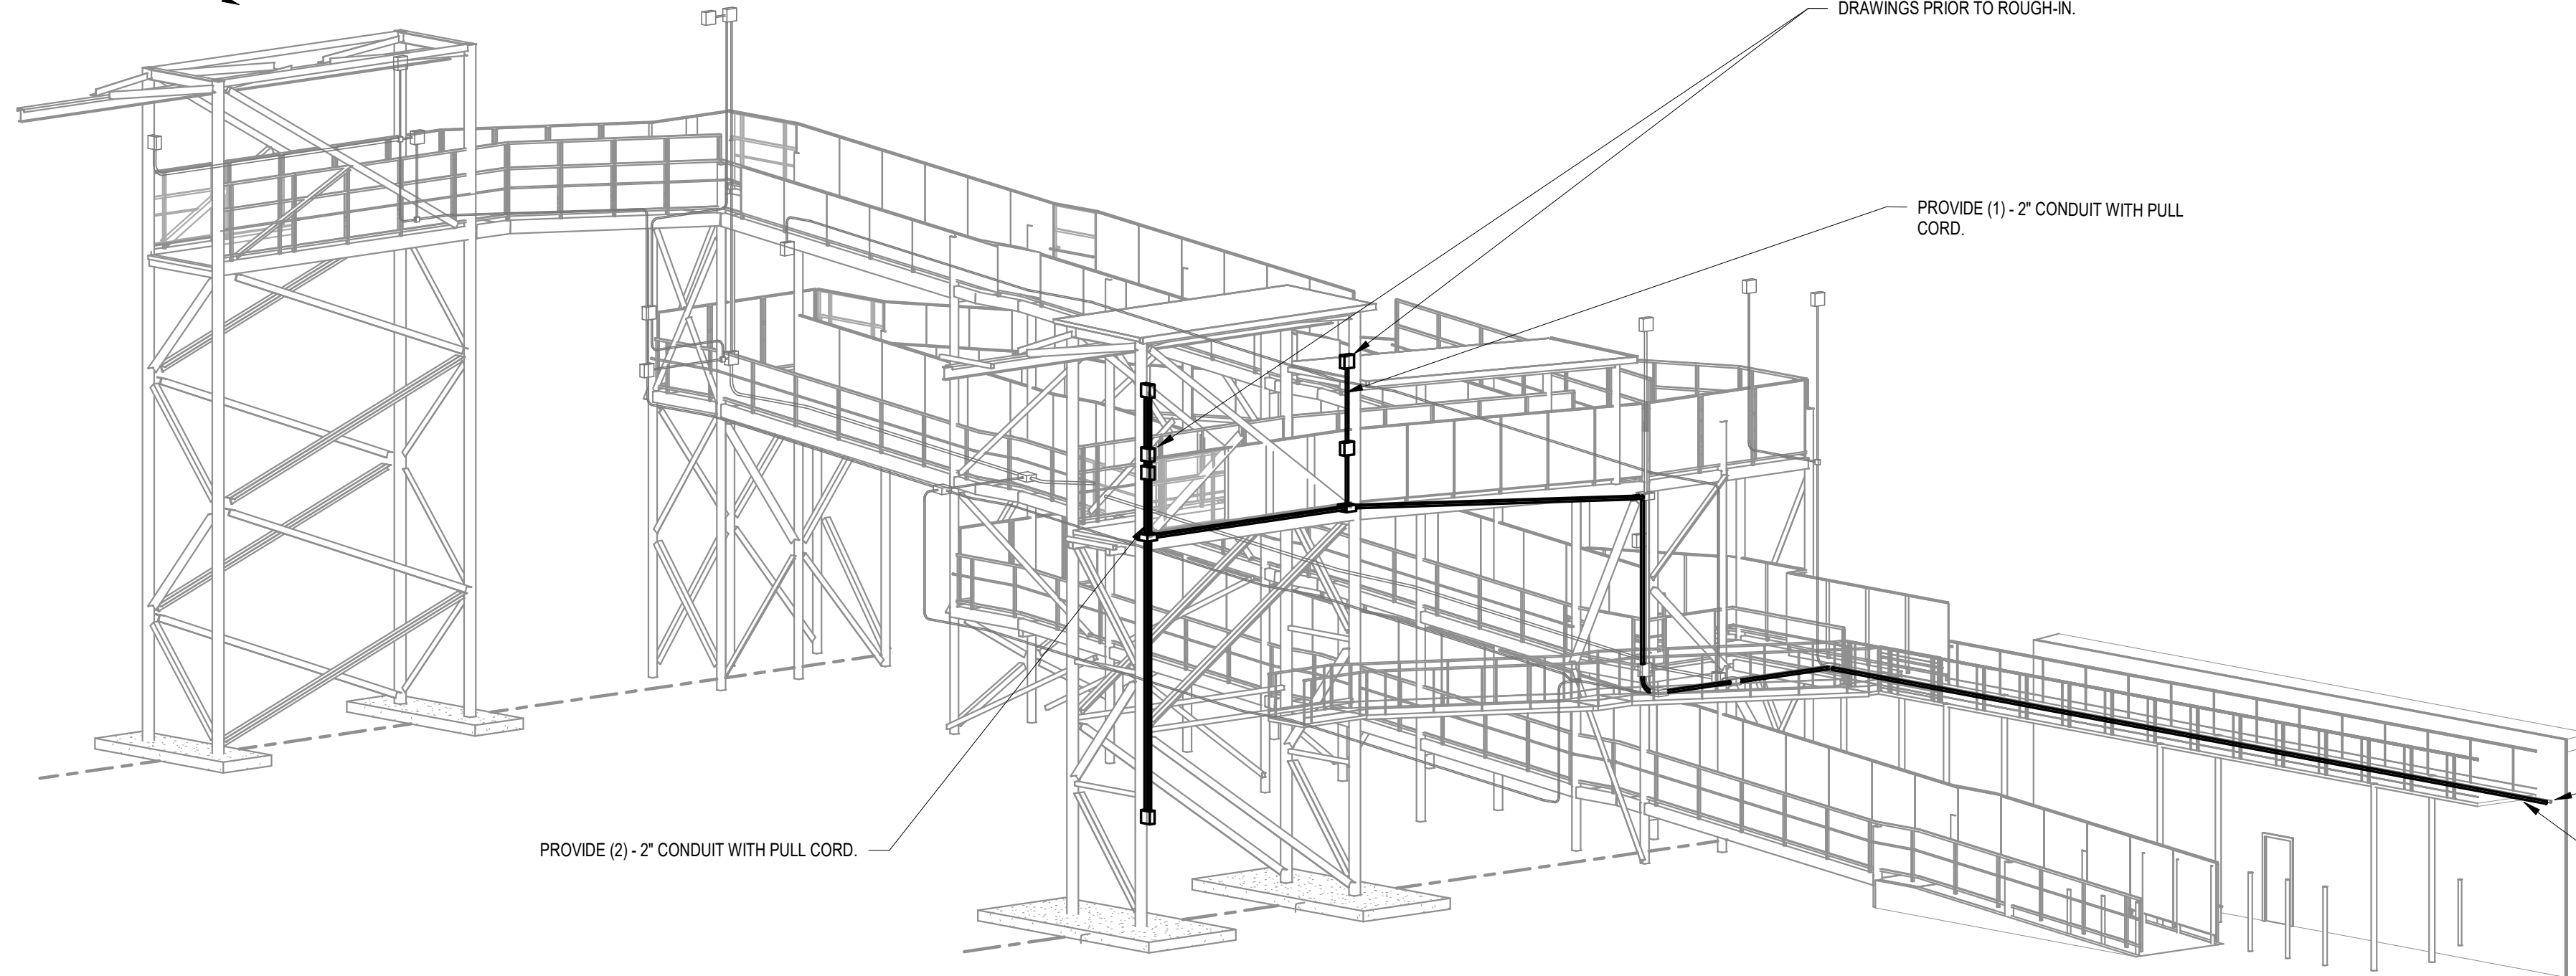

GANGWAY CONDUIT ROUTING - NORTHWEST ELEVATION

2

SCALE: N.T.S.

PROVIDE UV RESISTANT SCHEDULE 40 PVC OR GREATER JUNCTION BOX WITH PULL CORD FOR FUTURE CAMERA, SURFACE MOUNTED ABOVE RAMPS TO GANGWAY STEEL. COORDINATE EXACT LOCATION WITH STRUCTURAL DRAWINGS PRIOR TO ROUGH-IN.

PROVIDE (1) - 2" CONDUIT WITH PULL CORD.

FOR CONTINUATION, REFER TO KEYED NOTE ON ELECTRICAL SITE PLAN ON SHEET E901.

PROVIDE (2) - 2" CONDUIT WITH PULL CORD FROM MDF ROOM.

PROVIDE (2) - 2" CONDUIT WITH PULL CORD.

PROVIDE UV RESISTANT SCHEDULE 40 PVC OR GREATER JUNCTION BOX WITH PULL CORD FOR FUTURE CAMERA, SURFACE MOUNTED ABOVE RAMPS TO GANGWAY STEEL. COORDINATE EXACT LOCATION WITH STRUCTURAL DRAWINGS PRIOR TO ROUGH-IN.

PROVIDE (1) - 2" CONDUIT WITH PULL CORD.

PROVIDE (1) - 2" CONDUIT WITH PULL CORD.

FOR CONTINUATION, REFER TO KEYED NOTE ON ELECTRICAL SITE PLAN ON SHEET ES101.

PROVIDE (2) - 2" CONDUIT WITH PULL CORD FROM MDF ROOM.

FOR CONTINUATION, REFER TO KEYED NOTE ON ELECTRICAL SITE PLAN ON SHEET ES101.

GANGWAY CONDUIT ROUTING - SOUTHEAST ELEVATION

1

SCALE: N.T.S.

RS&H

10748 Deerwood Park Blvd. South
Jacksonville, Florida 32256-0597
904-256-2500 Fax 904-256-2503
www.rsandh.com
FL Cert. Nos. AAC001886 * IB26000956 *
5620 * LCC000210 * GB238



PROJECT TITLE:
JAXPORT CRUISE TERMINAL
GANGWAY MODIFICATION

PROJECT ADDRESS:
9810 AUGUST DRIVE
JACKSONVILLE, FL 32226

REVISIONS

NO.	DESCRIPTION	DATE


DATE ISSUED: 01/24/2025

REVIEWED BY: LAS

DRAWN BY: TKH

DESIGNED BY: LAS

PROJECT NUMBER:
10014153000

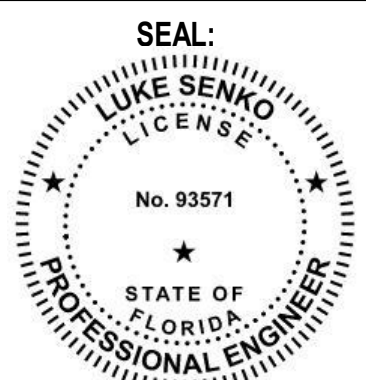

SHEET TITLE:
ELECTRICAL
ISOMETRICS

SHEET ID:

E901

PROJECT STATUS:
100% CONSTRUCTION
DOCUMENTS

"REVISED BID FORM"

JAXPORT PROJECT NO.: D2025-01
JAXPORT CONTRACT NO.: C-2017C
CRUISE TERMINAL NEW GANGWAY
DAMES POINT MARINE TERMINAL

BIDDER'S NAME: _____

The undersigned hereby proposes to furnish all materials, equipment, labor, and supervision for the above identified project, in accordance with the specifications and drawings for Contract No. **C-2017C**, at the following price:

Scope of Work: Furnish to all labor, materials, equipment, incidentals, testing, supervision, means and methods necessary to build a new steel gangway/ramp for passengers' access to a Cruise Ship at the Dames Point Cruise Terminal in accordance and compliance with all applicable local, state and federal codes, standards and regulations, including structural, electrical, mechanical, environmental and safety related standards.

"REVISED BID FORM"				
JAXPORT Cruise Terminal New Gangway				
Item No.	Item Description	Unit of Measure	Estimated Quantities	Total Item Amount
Division 01 - General Requirements				
1.01	Mobilization/Demobilization (60% / 40%)	LS	1	\$
1.02	General Conditions	LS	1	\$
Subtotal (General Requirements):				\$
Division 02 - Existing Conditions				
2.01	Demolition	LS	1	\$
2.02	Sawcut and Remove Existing Asphalt Pavement	SY	12	\$
2.03	Excavation for Footings	SY	50	\$
Subtotal (Existing Conditions):				\$
Division 03 - New Construction				
3.01	Concrete	LS	1	\$
3.02	Steel	LS	1	\$
3.03	Painting	LS	1	\$
3.04	Guardrail Infill (Alucobond Panels and Lexan Panels)	LS	1	\$
3.05	Composite Canopy	SF	2,250	\$
3.06	Hoist	EA	1	\$
3.07	Gangway Bridge (Brow)	EA	1	\$
Subtotal (New Construction):				\$
Division 04 - Electrical				
4.01	Existing Electrical Demo	LS	1	\$
4.02	Pull Box(es)	LS	1	\$
4.03	Branch Circuit (Conduit(s) & Conductors)	LS	1	\$
4.04	Disconnect & Controller	LS	1	\$
Subtotal (Electrical):				\$
Division 05 - IT/Communications				
5.01	Conduit(s) w/ Pull Cord (1 Qty. 2" RMC)	LS	1	\$
5.02	Pull Box(es)	LS	1	\$
Subtotal (IT/Communications):				\$
Bid Total:				\$

"REVISED BID FORM"

JAXPORT PROJECT NO.: D2025-01
JAXPORT CONTRACT NO.: C-2017C
CRUISE TERMINAL NEW GANGWAY
DAMES POINT MARINE TERMINAL

(Submission of more than one bid form for the same work by an individual, firm, partnership or corporation under the same or different names and/or any alterations, exceptions or comments contained within the bid form shall be grounds for rejection of the bid)

Basis of Award: The Authority reserves the right to award this contract to the bidder whose prices is the lowest based on Total Bid Amount (Division Items 01 - 05), subject to availability of appropriated funds.

JAXPORT reserves the right to award this contract to the lowest, responsive, responsible bidder, whose bid is fully conforming to the requirements of the bid documents. Nevertheless, JAXPORT reserves the right to waive informalities or minor irregularities in any bid, to reject any or all bids, and to accept the bid which, in its judgment, will be in the best interest of JAXPORT. JAXPORT will be the sole judge of which proposal will be in its best interest and its decision will be final.

JAXPORT reserves the right to award this contract to the bidder offering the lowest price consistent with meeting all specifications, terms, conditions, delivery requirements set forth on this bid. No award will be made until all necessary inquiries have been made into the responsibility of the lowest conforming bidder and JAXPORT is satisfied that the lowest bidder met all the requirements, is qualified and has the necessary organization, capital and resources required to perform the work under the terms and conditions of the contract. JAXPORT reserves the right to accept or reject any or all proposals, in whole or in part.

Bidder's Attestation:

Initials:_____ Date:_____ I hereby attest, as the Bidder's authorized agent, that Firm is not owned, an affiliate of, or substantially controlled or influenced by the government of a foreign country of concern as defined below.

Under Florida Statutes, JAXPORT, like all state agencies and local government entities, is prohibited from entering into any contract or agreement with a foreign country of concern, which has been defined as "the People's Republic of China, the Russian Federation, the Islamic Republic of Iran, the Democratic People's Republic of Korea, the Republic of Cuba, the Venezuelan regime of Nicolás Maduro, or the Syrian Arab Republic, including any agency of or any other entity of significant control of such foreign country of concern."

The required bid guaranty is attached hereto (see "Supplemental Instructions to Bidders") of the contract documents.

"REVISED BID FORM"

JAXPORT PROJECT NO.: D2025-01
JAXPORT CONTRACT NO.: C-2017C
CRUISE TERMINAL NEW GANGWAY
DAMES POINT MARINE TERMINAL

Acknowledgment of the following addenda is hereby made (see "Supplemental Instructions to Bidders"):

Addendum No. 1, Dated: _____ Initials: _____

Addendum No. 2, Dated: _____ Initials: _____

Addendum No. 3, Dated: _____ Initials: _____

Addendum No. 4, Dated: _____ Initials: _____

See also "Bid Contents and Format" section of the "Supplemental Instructions to Bidders".

Name of Contractor

AUTHENTICATION (see "Supplemental Instructions to Bidders")

Firm

Business Address

City

State

Zip Code

Mailing Address, if different from above

Authorized Signature

Date Executed

Typed Name

Title

E-Mail Address

Telephone Number

Facsimile Number

Company Federal Tax I.D. No.

Company's Business License No.



"EXISTING GANGWAY AS-BUILT DRAWINGS"

(informational only)

DAMES POINT MARINE TERMINAL CRUISE TERMINAL GANGWAY

JPA CONTRACT NO. C-1642
RS&H PROJECT NO. 101-0003-027



AS-BUILT
TO THE BEST OF OUR KNOWLEDGE
THESE DRAWINGS REPRESENT THE
AS CONSTRUCTED CONDITIONS OF
THIS PROJECT.

ACON CONSTRUCTION CO., INC.



SHEET NO.	SHEET TITLE
G001	KEY SHEET
S012	STRUCTURAL GENERAL NOTES
S013	STRUCTURAL ISOMETRIC - 1
S014	STRUCTURAL ISOMETRIC - 2
SD101	EXISTING RAMP DEMOLITION PLAN
S101	FOUNDATION PLAN
S102	RAMP FRAMING PLAN - LOWER
S103	RAMP FRAMING PLAN - INTERMEDIATE
S104	RAMP FRAMING PLAN - UPPER
S105	RAMP GUARDRAIL PLANS
S201	FRAMING ELEVATIONS - 1
S202	FRAMING ELEVATIONS - 2
S203	FRAMING ELEVATIONS - 3
S204	FRAMING ELEVATIONS - 4
S301	STRUCTURAL SECTIONS
S401	ENLARGED LANDING PLANS
S501	FOUNDATION SECTIONS & DETAILS
S502	FRAMING SECTIONS & DETAILS - 1
S503	FRAMING SECTIONS & DETAILS - 2
S801	REFERENCE DRAWING-1
S802	REFERENCE DRAWING-2
S803	REFERENCE DRAWING-3
S804	REFERENCE DRAWING-4
S805	REFERENCE DRAWING-5
S806	REFERENCE DRAWING-6

E-1 - E-6 ELECTRICAL PLANS
(See Index on Sheet E-1)

**JAXPORT CRUISE
TERMINAL GANGWAY**

CONSULTANTS

AS-BUILT
TO THE BEST OF OUR KNOWLEDGE
THESE DRAWINGS REPRESENT THE
AS CONSTRUCTED CONDITIONS OF
THIS PROJECT.

ACON CONSTRUCTION CO., INC.

REVISIONS

[illegible]

DATE ISSUED: 8/16/18

REVIEWED BY: _____ REP _____

DRAWN BY: PFM

DESIGNED BY: DMH

RS&H PROJECT NO.

101-0003-027

© 2017 RS&H, INC.

SHEET TITLE

KEY SHEET


SHEET NUMBER

G001

CONSTRUCTION DOCUMENTS

AB	ANCHOR BOLT	IAW	IN ACCORDANCE WITH
ADJ	ADJACENT	IF	INSIDE FACE
AFF	ABOVE FINISH FLOOR	INT	INTERIOR
B/	BOTTOM OF	JT	JOINT
BC	BOTTOM CHORD		
BLDG	BUILDING	KSI	KIPS PER SQUARE INCH
BM	BEAM		
BOTT	BOTTOM	LLH	LONG LEG HORIZONTAL
BRG	BEARING	LLV	LONG LEG VERTICAL
BTW	BETWEEN	LOC	LOCATION
		LSV	LONG SIDE VERTICAL
CCJ	CONTRACTION CONTROL JOINT		
CFMF	COLD FORMED METAL FRAMING	M	MECHANICAL
CL	CENTERLINE	MAX	MAXIMUM
CLR	CLEAR	MC	MOMENT CONNECTION
CMU	CONCRETE MASONRY UNIT	MFR	MANUFACTURER
COL	COLUMN	MIN	MINIMUM
CONC	CONCRETE	MSL	MEAN SEA LEVEL
CONT	CONTINUOUS		
		OAE	OR APPROVED EQUAL
D	DEEP	OC	ON CENTER
DET	DETAIL	OF	OUTSIDE FACE
DIA	DIAMETER	OH	OPPOSITE HAND
E	ELECTRICAL	PAF	POWDER ACTUATED FASTENER
EA	EACH	PL	PLATE
EJ	EXPANSION JOINT	PSF	POUNDS PER SQUARE FOOT
EL	ELEVATION	PSI	POUNDS PER SQUARE INCH
EMBED	EMBEDMENT		
EOD	EDGE OF DECK	R	RADIUS
EP	EMBEDDED PLATE	REINF	REINFORCEMENT
EPS	EXPANSIVE POLYSTYRENE GEOFOAM		
EQ	EQUAL	SIM	SIMILAR
EQUIP	EQUIPMENT	SLV	SHORT LEG VERTICAL
EXIST	EXISTING	STD	STANDARD
EXP	EXPANSION	STL	STEEL
EXT	EXTERIOR		
		T&B	TOP AND BOTTOM
FDN	FOUNDATION	T/	TOP OF
FTG	FOOTING	TH	THICK
FV	FIELD VERIFY	TRANS	TRANSVERSE
		TYP	TYPICAL
GALV	GALVANIZED		
GR	GRADE	UNO	UNLESS NOTED OTHERWISE
HDG	HOT DIPPED GALVANIZED	VERT	VERTICAL
HORIZ	HORIZONTAL		
HSA	HEADED STUD ANCHOR	W	WIDE
HSS	HOLLOW STEEL SECTION	W/	WITH
HT	HEIGHT	WF	WIDE FLANGE
		WP	WORK POINT

ULTIMATE COMPONENTS & CLADDING PRESSURES FOR VERTICAL COMPONENTS (PSF)				
ZONE	EFFECTIVE WIND AREA (S.F.)			
	≤ 10	25	50	100
(4)	-51.4	-48.7	-46.5	-44.3
(5)	-63.2	-57.5	-53.6	-49.2
(4) & (5)	47.4	44.8	42.6	40.4

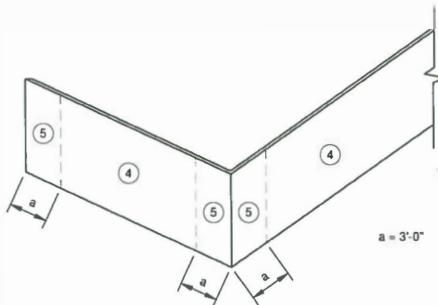

1. EDGE ZONE (a) IS DISTANCE FROM CORNERS OF COMPONENTS, AND IS SHOWN IN THE DIAGRAM, ABOVE.
2. POSITIVE AND NEGATIVE SIGNS SIGNIFY PRESSURES ACTING TOWARDS AND AWAY FROM SURFACES, RESPECTIVELY.
3. FOR EFFECTIVE AREAS BETWEEN VALUES GIVEN, INTERPOLATION MAY BE USED. OTHERWISE USE THE LOWER EFFECTIVE AREA.

1. FOUNDATIONS SHALL BE IN ACCORDANCE WITH GEOTECHNICAL RECOMMENDATIONS FROM CSI GEO, INC PROJECT NO 71-18-120-31, JAXPORT 175B-PC3929, DATED 5/23/2018.
2. ALLOWABLE SOIL BEARING PRESSURE = 2500 PSF
3. FOUNDATIONS ON THE RELIEVING PLATFORM ARE DESIGNED FOR A MAXIMUM BEARING PRESSURE OF 1500 PSF.
4. SITE PREPARATION AND FILL AND FOUNDATION BEARING SURFACES SHALL BE IN ACCORDANCE WITH THE GEOTECH REPORT.

1. ALL CONCRETE SHALL BE DESIGNED PER ACI 318-14.
2. ALL CONCRETE SHALL BE DESIGNED BY AN APPROVED LABORATORY, AND THE DESIGN MIX SHALL SUBMITTED TO THE ARCHITECT/ENGINEER FOR REVIEW, AND OBTAIN APPROVAL PRIOR TO USE.

<u>LOCATION</u>	<u>STRENGTH @ 28 DAYS</u>
<u>NORMAL WEIGHT CONCRETE</u>	
FOUNDATIONS	3000 PSI
SLAB ON GRADE	3000 PSI
ELEVATED COMPOSITE DECK	4000 PSI
ALL OTHER CONCRETE	3000 PSI

3. NO PIPES OR DUCTS SHALL BE PLACED IN STRUCTURAL CONCRETE UNLESS SPECIFICALLY DETAILED. SEE ARCHITECTURAL AND MECHANICAL DRAWINGS FOR LOCATION OF SLEEVES, MOULDS, FLOOR HINGES, ETC. TO BE CAST INTO THE CONCRETE.

1. REINFORCING STEEL SHALL BE DEFORMED BARS CONFORMING TO ASTM SPECIFICATION A615 GRADE 60. ALL MESH REINFORCING SHALL CONFORM TO A.S.T.M. SPECIFICATION A1064.
2. SPLICES IN REINFORCING, WHERE PERMITTED, SHALL BE CLASS B TENSION LAP SPLICES, U.N.O.
3. MINIMUM LAP OF MESH REINFORCING SHALL BE ONE FULL MESH PLUS 2" OR 6", WHICHEVER IS GREATER.
4. UNLESS OTHERWISE SHOWN ON DRAWINGS, MINIMUM COVER FOR REINFORCING SHALL BE AS FOLLOWS:

FOOTINGS	3"
SLABS ON GRADE	TOP THIRD
5. ALL REINFORCING SHALL BE HELD SECURELY IN POSITION WITH STANDARD ACCESSORIES IN CONFORMANCE WITH CRSI MANUAL OF STANDARD PRACTICE AND ACI 531' DURING THE PLACING OF CONCRETE.
6. PROVIDE CORNER REINFORCING TO MATCH HORIZONTAL REINFORCING AT ALL CORNERS OF CONTINUOUS FOOTINGS AND TIE BEAMS.
7. ALL HOOKS IN REINFORCING BARS SHALL BE AN ACI STANDARD HOOK, UNLESS NOTED OTHERWISE.
8. REINFORCING BARS CONFORMING TO ASTM A706 SHALL BE USED FOR BARS REQUIRING WELDING.

1. GANGWAY SHALL BE DESIGNED IN ACCORDANCE WITH THE 2017 FLORIDA BUILDING CODE.
2. GANGWAY SHALL BE DESIGNED FOR A UNIFORM LIVE LOAD OF 100PSF.
3. GANGWAY SHALL BE PROVIDED WITH LIFTING LUGS.
4. GANGWAY SHALL BE FABRICATED FROM 6061-T6 ALUMINUM MATERIAL.
5. BREAK ALL EDGES ABOVE DECK LEVEL.
6. HANDRAIL, GUARDS AND INFILL SHALL COMPLY WITH THE 2017 FLORIDA BUILDING CODE – ACCESSIBILITY.
7. PIPE RAIL SHALL HAVE A BRUSH FINISH AFTER FABRICATION.
8. SUBMIT SHOP DRAWINGS FOR APPROVAL PRIOR TO FABRICATION. SHOP DRAWING SHALL BE SIGNED AND SEALED BY A PROFESSIONAL ENGINEER REGISTERED IN THE STATE OF FLORIDA.
9. BASIS OF DESIGN: BELLINGHAM MARINE INDUSTRIES, INC.

1. ALL INFILL PANELS SHALL BE 6 MM ALUCOBOND PE PANELS EXCEPT WHERE OTHERWISE NOTED ON THE PLANS. PANELS MARKED WITH AN SHALL BE 6 MM LEXAN XL102UV SHEETS. COLORS SHALL BE SELECTED BY JAXPORT. SUBMIT SAMPLES.
2. SHEET PRODUCTS SHALL BE SAWN AND CUT ACCURATELY USING STANDARD WORKSHOP EQUIPMENT, HOWEVER, MANUFACTURER'S WRITTEN GUIDELINES SHALL BE FOLLOWED.
3. ALL PANEL BUTT JOINTS SHALL BE VERTICAL. NO HORIZONTAL OR SLANTED JOINTS ARE PERMITTED.
4. PANELS SHALL BE FASTENED TO ALL HORIZONTAL RAILS WITH MIN #8 SS SELF TAPPING, SELF DRILLING SCREWS WITH BONDED WASHERS AT 12" O.C. HOLES IN THE PANELS SHALL BE 2 TIMES THE SCREW SIZE AND SHALL BE DRILLED WITH STANDARD HIGH SPEED DRILLS IN ACCORDANCE WITH MANUFACTURER'S INSTRUCTIONS. HEAT GENERATION SHALL BE KEPT TO AN ABSOLUTE MINIMUM.
5. PANELS SHALL BE INSTALLED BY A SUBCONTRACTOR WHO HAS SUCCESSFULLY COMPLETED AT LEAST 3 PROJECTS OF SIMILAR SIZE AND SCOPE TO THIS PROJECT.
6. ALL EXPOSED PANEL EDGES SHALL BE BEVELED OR ROUNDED TO ELIMINATE SHARP EDGES.
7. SUBMIT SHOP DRAWINGS SHOWING PROJECT LAYOUT AND ELEVATIONS, FASTENING AND ANCHORING METHODS, DETAIL AND LOCATION OF JOINTS, SEALANTS AND GASKETS, INCLUDING JOINTS NECESSARY TO ACCOMMODATE THERMAL MOVEMENT.
8. BASIS OF DESIGN:

ALUCOBOND: **PIEDMONT PLASTICS**
2175 MASON AVE, DAYTONA BEACH, FL 32117
(800) 874-7512
CONTACT: **DALE SHELTON, TERRITORY MANAGER**
(904) 472-8015

LEXAN: SABIC
PITTSFIELD, MA
CONTACT: MICHAEL CORUZZI
(856) 904-3581
MICHAEL.CORUZZI@SABIC.COM

1.	ALL WORK TO CONFORM TO THE FOLLOWING: 2017 FLORIDA BUILDING CODE - BUILDING, SIXTH EDITION ASCE 7-10	
2.	LIVE LOADS: WALKWAYS AND RAMPS	100 PSF
3.	WIND DESIGN DATA (ASCE 7-10): ULTIMATE DESIGN WIND SPEED, V_{ult} (3-SECOND GUST) NOMINAL DESIGN WIND SPEED, V_{asd} (3-SECOND GUST) BUILDING RISK CATEGORY WIND EXPOSURE	126 MPH 98 MPH II D

1. CONTRACTOR SHALL VERIFY ALL DIMENSIONS ON JOB SITE WITH COMPLETE SET OF LATEST DRAWINGS. NOTES AND DIMENSIONS SHALL BE CHECKED AND VERIFIED WITH ARCHITECTURAL AND STRUCTURAL DRAWINGS. ANY DISCREPANCIES SHALL BE BROUGHT TO THE ATTENTION OF THE ARCHITECT/ENGINEER BEFORE COMMENCING WORK SO THAT PROPER REMEDIAL WORK CAN BE EXECUTED.
2. UNLESS SPECIFICALLY DETAILED ON THESE DRAWINGS, CONTRACTOR SHALL FURNISH AND INSTALL ADEQUATE SHORING, BRACING, ETC. REQUIRED TO SAFELY EXECUTE ALL WORK AND SHALL BE FULLY RESPONSIBLE FOR THE SAME.
3. DETAILS AND CONDITIONS NOT SPECIFICALLY SHOWN SHALL BE CONSTRUCTED IN ACCORDANCE WITH DETAILS SHOWN FOR SIMILAR CONDITION AND MATERIAL.

1. THE EXISTING CONSTRUCTION SHOWN ON THE DRAWINGS WAS OBTAINED FROM EXISTING DRAWINGS BY W.Y. GRISWOLD, JR., PE, DATED 8/29/03. THE CONTRACTOR SHALL VERIFY ALL EXISTING CONDITIONS PRIOR TO PROCEEDING WITH WORK. CONTRACTOR SHALL NOTIFY ARCHITECT / ENGINEER OF ALL EXCEPTIONS TO ASSUMED CONDITIONS.
2. ALL REMOVAL, CUTTING, DRILLING, ETC. OF EXISTING CONSTRUCTION SHALL BE PERFORMED WITH GREAT CARE IN ORDER TO NOT DAMAGE THE EXISTING AND JEOPARDIZE THE INTEGRITY OF THE EXISTING BUILDING TO REMAIN.

1. STRUCTURAL STEEL SHALL BE DESIGNED PER THE AISC 360-05, THIRTEENTH EDITION.
WIDE FLANGE SHAPES A.S.T.M. A992, Fy = 50 KSI
STEEL TUBES A.S.T.M. A500, GRADE "C" Fy = 50 KSI
STEEL PIPES A.S.T.M. A500, GRADE "C" Fy = 46 KSI
ALL OTHER STEEL A.S.T.M. A36, Fy = 36 KSI
2. ALL BOLTS SHALL BE 3/4"Ø (ASTM A325) UNLESS OTHERWISE NOTED.
3. ALL ANCHOR RODS SHALL BE ASTM F1554 GRADE 36 UNLESS OTHERWISE NOTED.
4. WELDING SHALL CONFORM TO ANS/ASW 5.1.1.
5. MINIMUM SIZE OF ALL FILLET WELDS SHALL CONFORM TO TABLE J2.4 OF AISC SPECIFICATIONS EVEN IF SHOWN OTHERWISE ON ARCHITECTURAL AND STRUCTURAL DRAWINGS.
6. FABRICATOR SHALL SUBMIT SHOP DRAWINGS TO STRUCTURAL ENGINEER FOR REVIEW PRIOR TO START OF FABRICATION. FABRICATION SHALL CONFORM TO AISC SPECIFICATIONS.
7. ALL STRUCTURAL STEEL AND METAL DECK SHALL BE FIELD PAINTED PER THE SPECIFICATIONS.

1. ALL STEEL FLOOR DECK SHALL BE IN CONFORMANCE WITH THE LATEST EDITION OF THE STEEL DECK INSTITUTE (SDI).
2. ALL STEEL FLOOR DECK SHALL BE GALVANIZED G 90.
3. ALL FLOOR DECK SHALL BE COMPOSITE DECK EQUAL TO NEW MILLENNIUM TYPE 1.5CD, 18 Ga THICKNESS, WITH MINIMUM YIELD STRENGTH OF 40 ksi.
 - A. FLOOR DECK MINIMUM PROPERTIES $f_y = 0.279 \text{ in}^2/\text{ft}$, $I_n = 0.281 \text{ in}^4/\text{ft}$, $S_p = 0.304 \text{ in}^3/\text{ft}$, $S_n = 0.315 \text{ in}^3/\text{ft}$.
4. FLOOR SLAB SHALL HAVE AN OVERALL NOMINAL THICKNESS OF 3 1/2" FROM TOP OF CONCRETE TO BOTTOM OF METAL DECK. UNO. REINFORCE W/ 6X6- W1.4 X W1.4.
5. REINFORCING FOR SLAB SHALL BE 3/4" FROM TOP OF SLAB.
6. ALL FLOOR DECK SHALL BE FASTENED TO STEEL SUPPORTS AT ENDS OF SHEET AND INTERMEDIATE SUPPORTS. MIN BEARING LENGTH = 1 1/2." SUPPORT FASTENERS SHALL BE ~~50 MPa~~ *#12 Hilti Deck Screw* RIVET WELD, WITH SPACING OF MAX 12" OC.
7. DECKING SLAB HAVE NESTED OR INTERLOCKING SIDE LAPS. SIDE LAPS SHALL BE FASTENED WITH #10 DRILL SCREWS AT MAX 36" OC.
8. ALL DECKS SHALL ARE DESIGNED FOR SINGLE SPANS. TWO OR MORE SPANS MAY BE USED WHERE GEOMETRY ALLOWS.
9. SEE SHEET S502 FOR METAL FLOOR DECK DETAILS.

1. CANOPY SHALL BE IN ACCORDANCE WITH THE 2017 FLORIDA BUILDING CODE.
2. STEEL POSTS, PURLINS AND HOOPS SHALL CONFORM TO ASTM A53 GRADE A AND SHALL BE HOT DIP GALVANIZED.
3. BOLTS SHALL BE STAINLESS STEEL AND CONFORM TO ASTM A307 AND A325.
4. SHADE FABRIC MATERIAL SHALL MATCH EXISTING AND SHALL HAVE A 10 YEAR WARRANTY AGAINST FADING, ROT, UV DETERIORATION, LOSS OF STRENGTH, COLOR CHANGE OR FAULTY WORKMANSHIP.
5. BASIS OF DESIGN: SHADE AMERICA, ST. AUGUSTINE, FLORIDA.

CONTACT: MULLER OTTO
(904) 217-0516
(904) 803-6594

**JAXPORT CRUISE
TERMINAL GANGWAY**

[illegible]

DATE ISSUED: 9/12/18

REVIEWED BY: _____ REP: _____

DRAWN BY: PFM

DESIGNED BY: DMH

RS&H PROJECT NO.

101-0003-027


© 2017 RS&H, INC.

SHEET TITLE

SHEET NUMBER

S012

CONSTRUCTION DOCUMENTS

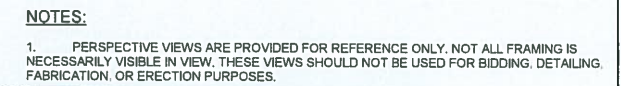

RS&H, Inc.
10748 Deerwood Park Blvd. South
Jacksonville, Florida 32256-0597
904-256-2500 Fax 904-256-2503
www.rsandh.com
FL Cert. Nos. AAC001896 * IB26000956 *
5620 * LCC000210 * GB238



AS-BUILT
TO THE BEST OF OUR KNOWLEDGE
THESE DRAWINGS REPRESENT THE
AS CONSTRUCTED CONDITIONS OF
THIS PROJECT.

REVISIONS

DATE ISSUED: 8/16/18

REVIEWED BY: REP

DRAWN BY: PFM

DESIGNED BY: DMH

RS&H PROJECT NO.

101-0003-027

© 2017 RS&H, INC.


SHEET TITLE

SHEET NUMBER

S013

CONSTRUCTION DOCUMENTS

1 3D PERSPECTIVE - BUILDING SIDE
S013 SCALE

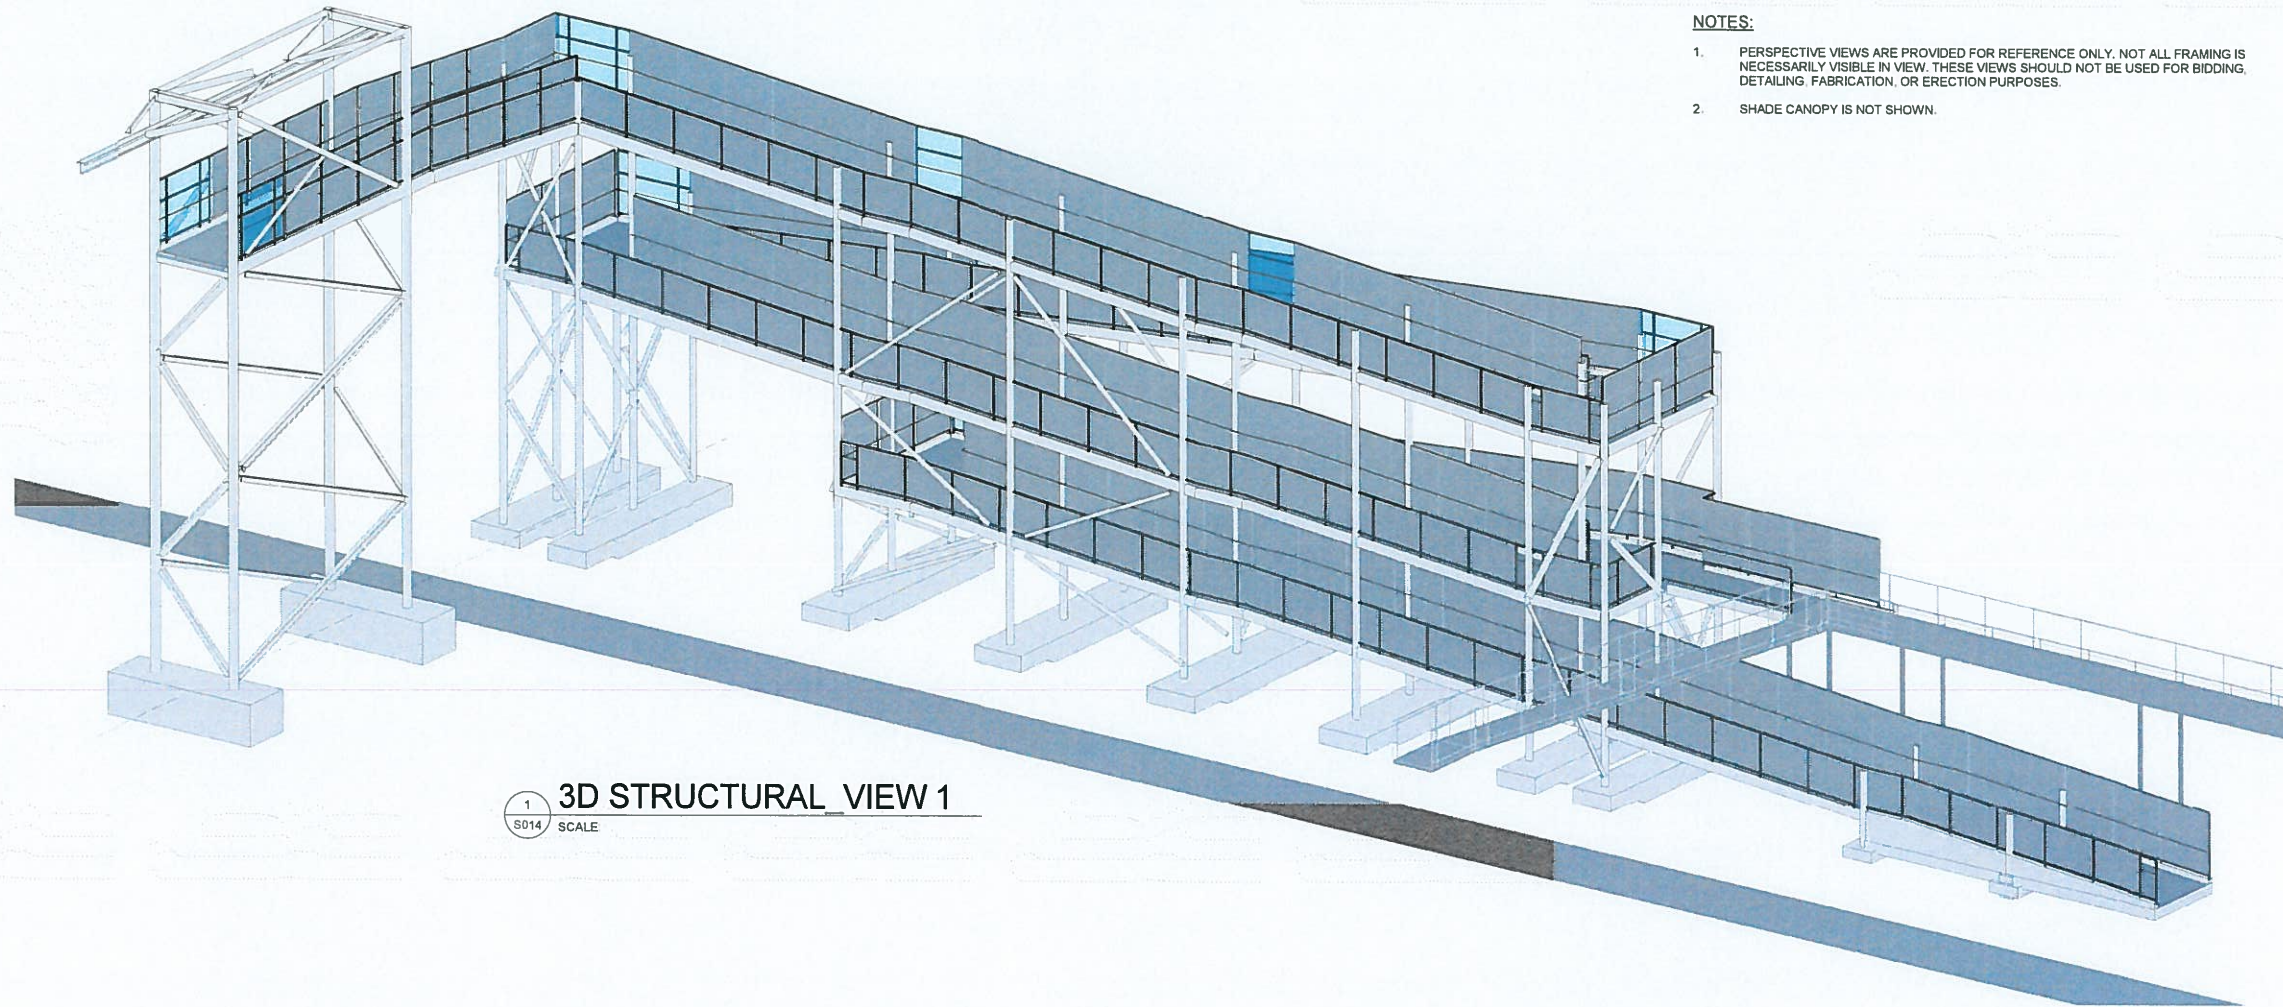


1
S014
SCALE

3D STRUCTURAL VIEW 1

NOTES:

1. PERSPECTIVE VIEWS ARE PROVIDED FOR REFERENCE ONLY. NOT ALL FRAMING IS NECESSARILY VISIBLE IN VIEW. THESE VIEWS SHOULD NOT BE USED FOR BIDDING, DETAILING, FABRICATION, OR ERECTION PURPOSES.
2. SHADE CANOPY IS NOT SHOWN.

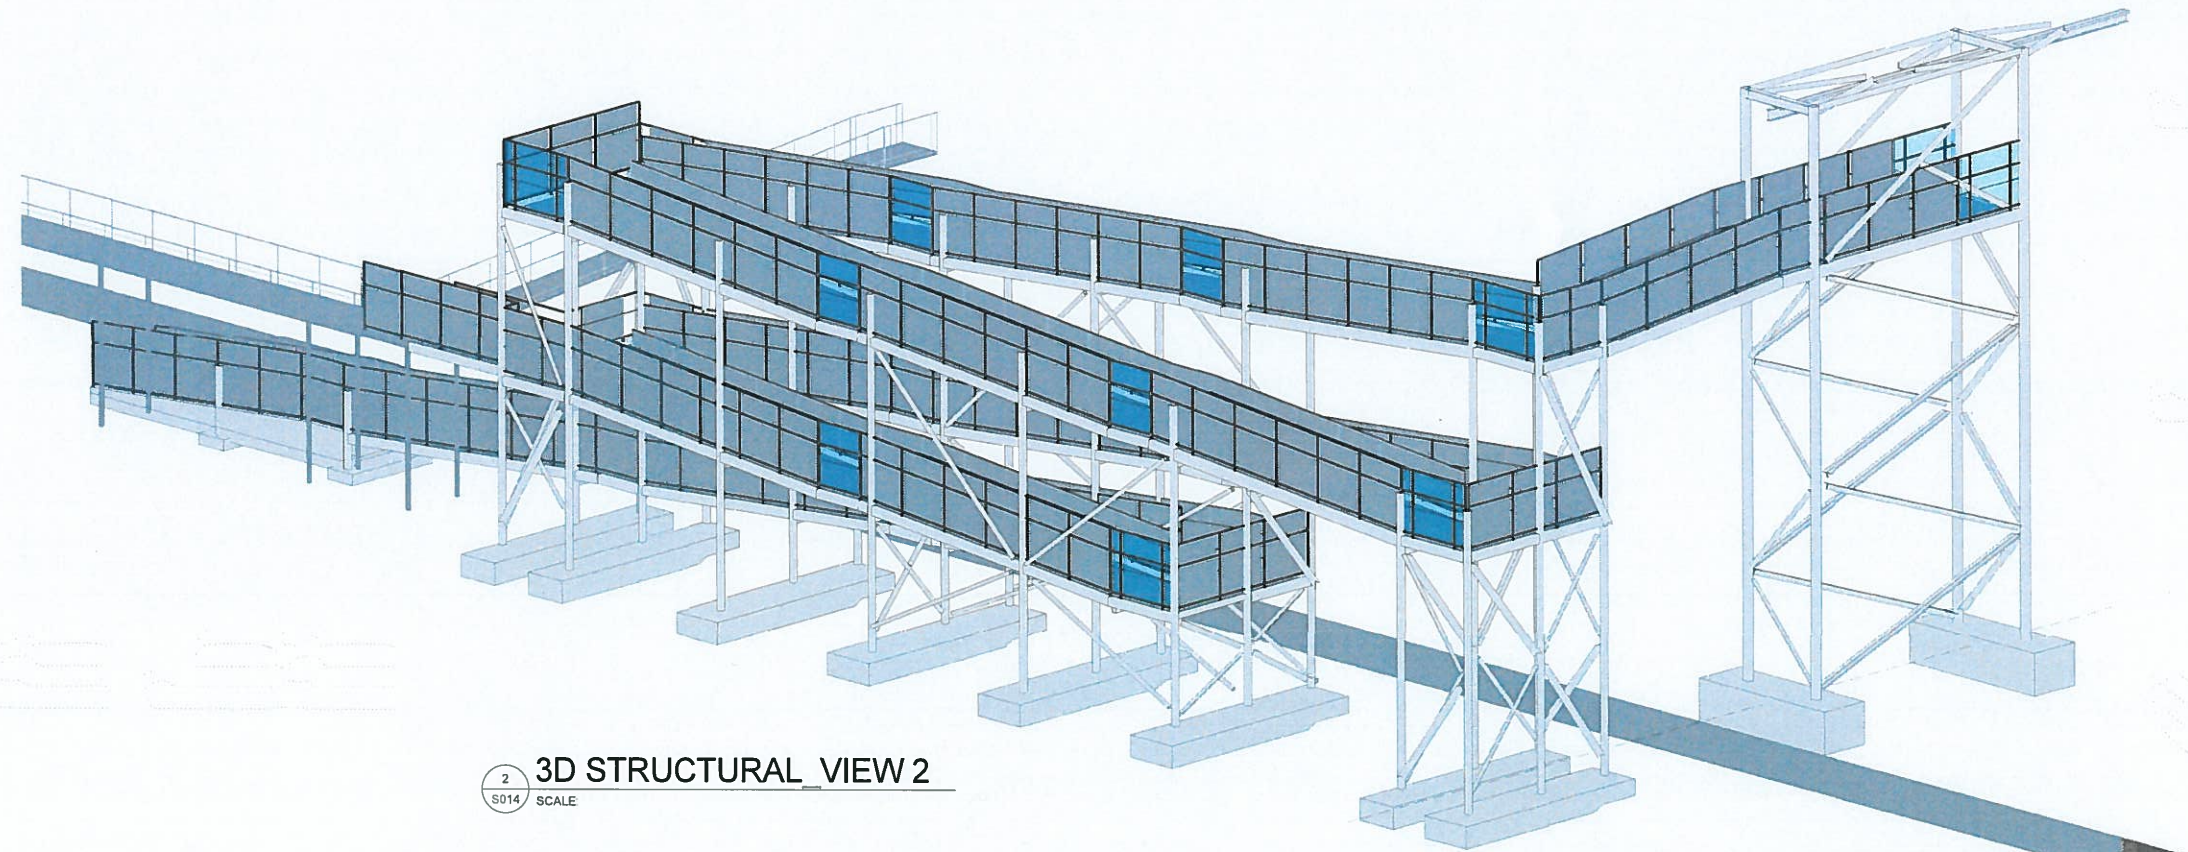

2
S014
SCALE

3D STRUCTURAL VIEW 2

RS&H

Engineer of Record:
Richard E. Peters
P.E. No. 33996

RS&H, Inc.
10748 Deerwood Park Blvd. South
Jacksonville, Florida 32256-0597
904-256-2500 Fax 904-256-2503
www.rsandh.com
FL Cert. Nos. AAC001886 * IB26000956 *
5620 * LCC000210 * GB238

JAXPORT
JACKSONVILLE PORT AUTHORITY

**JAXPORT CRUISE
TERMINAL GANGWAY**

CONSULTANTS

AS-BUILT
TO THE BEST OF OUR KNOWLEDGE
THESE DRAWINGS REPRESENT THE
AS CONSTRUCTED CONDITIONS OF
THIS PROJECT.

ACON CONSTRUCTION CO., INC.

REVISIONS

NO.	DESCRIPTION	DATE

DATE ISSUED: 8/16/18

REVIEWED BY: REP

DRAWN BY: PFM

DESIGNED BY: DMH

RS&H PROJECT NO.

101-0003-027

© 2017 RS&H, INC.


SHEET TITLE

**STRUCTURAL
ISOMETRIC - 2**



SHEET NUMBER

S014

**CONSTRUCTION
DOCUMENTS**

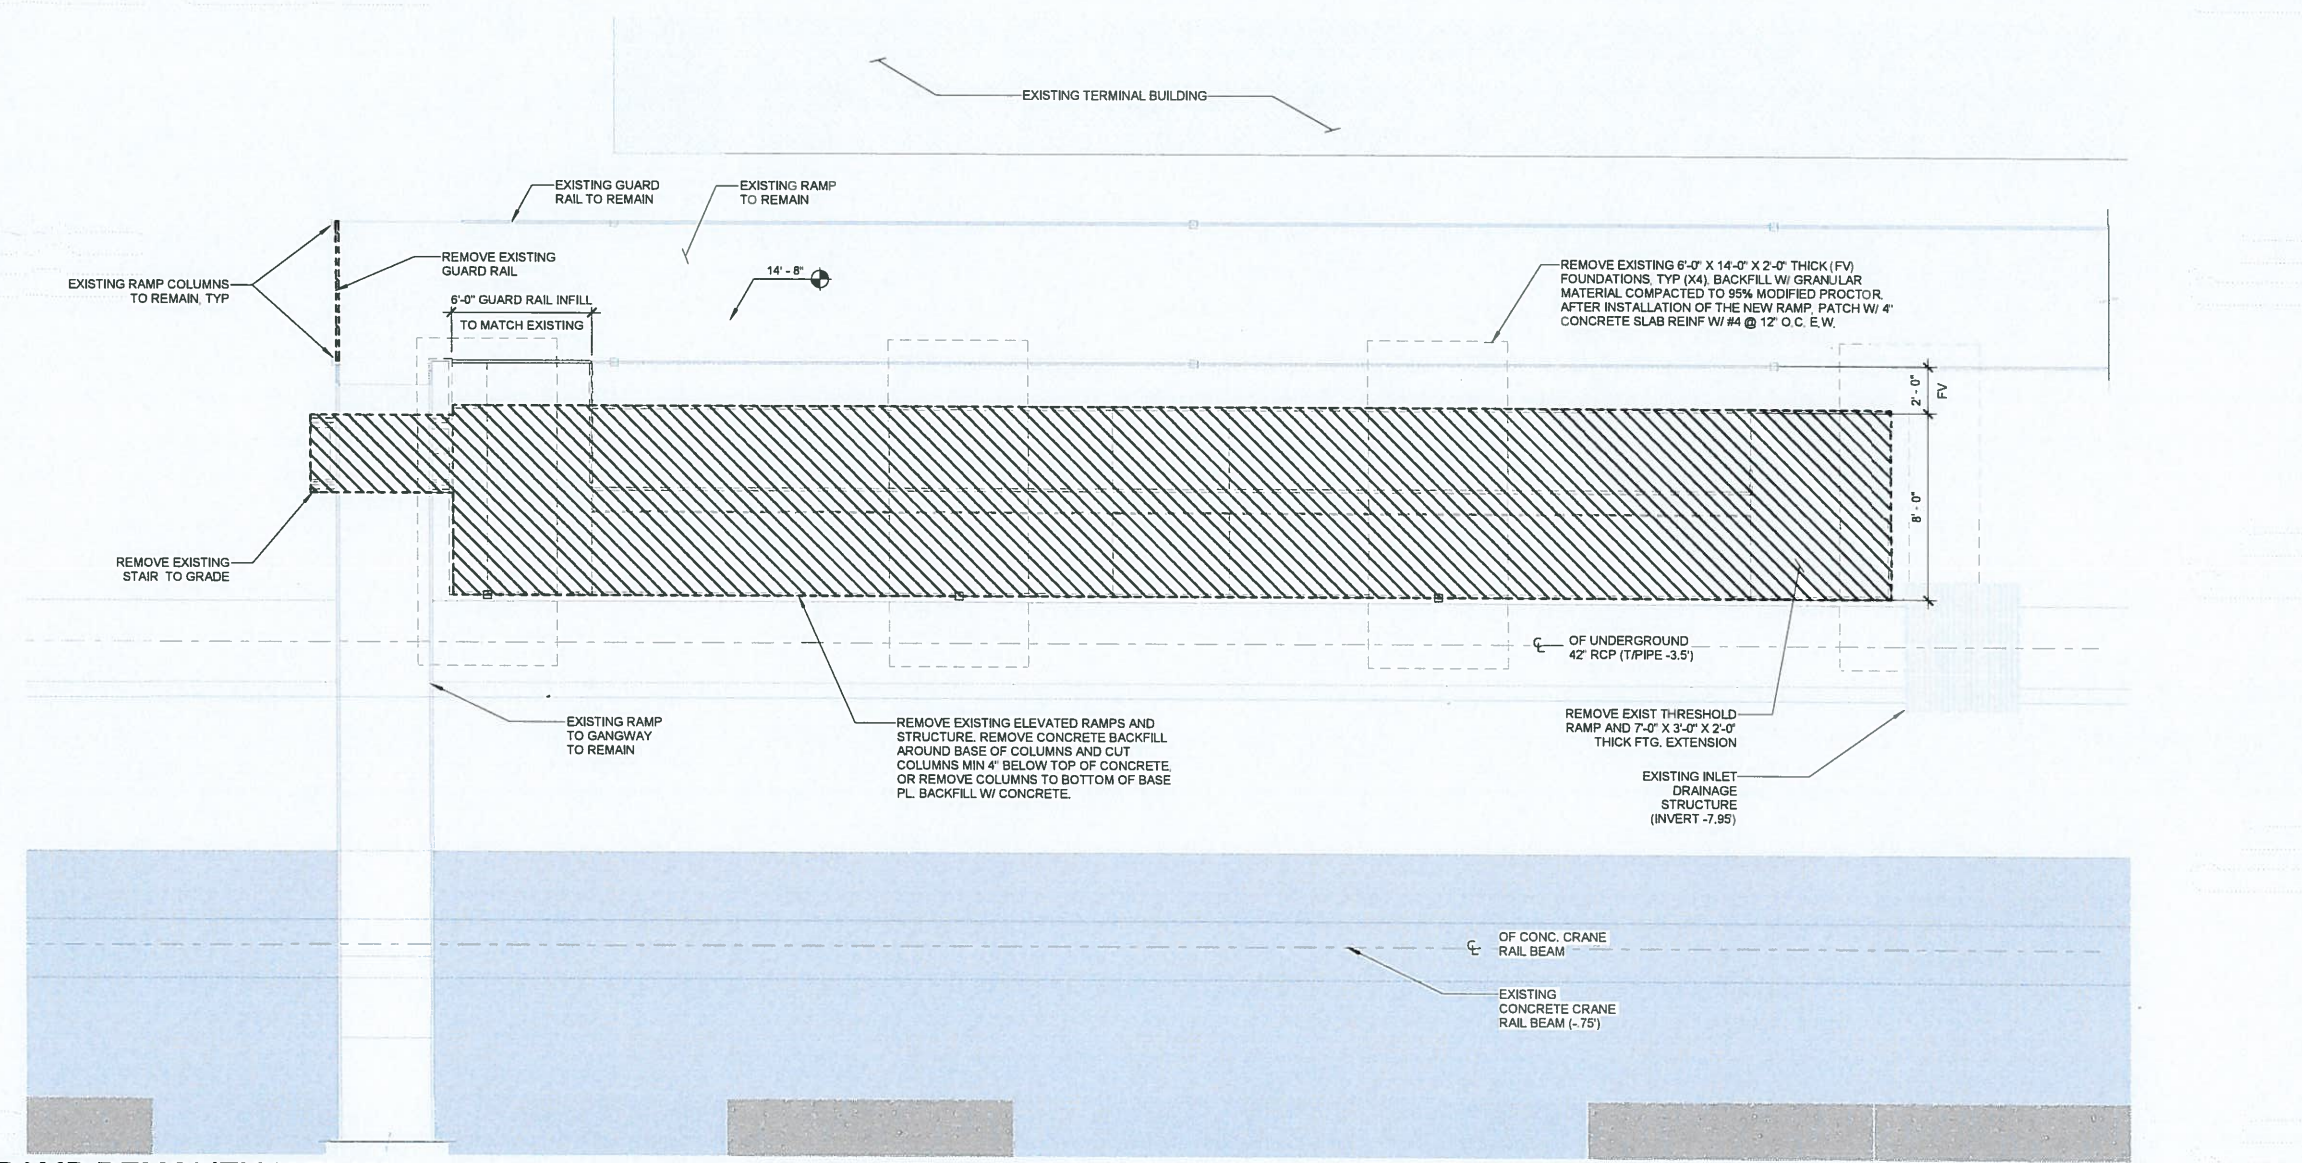

1
SD101 SCALE: 1/4" = 1'-0"

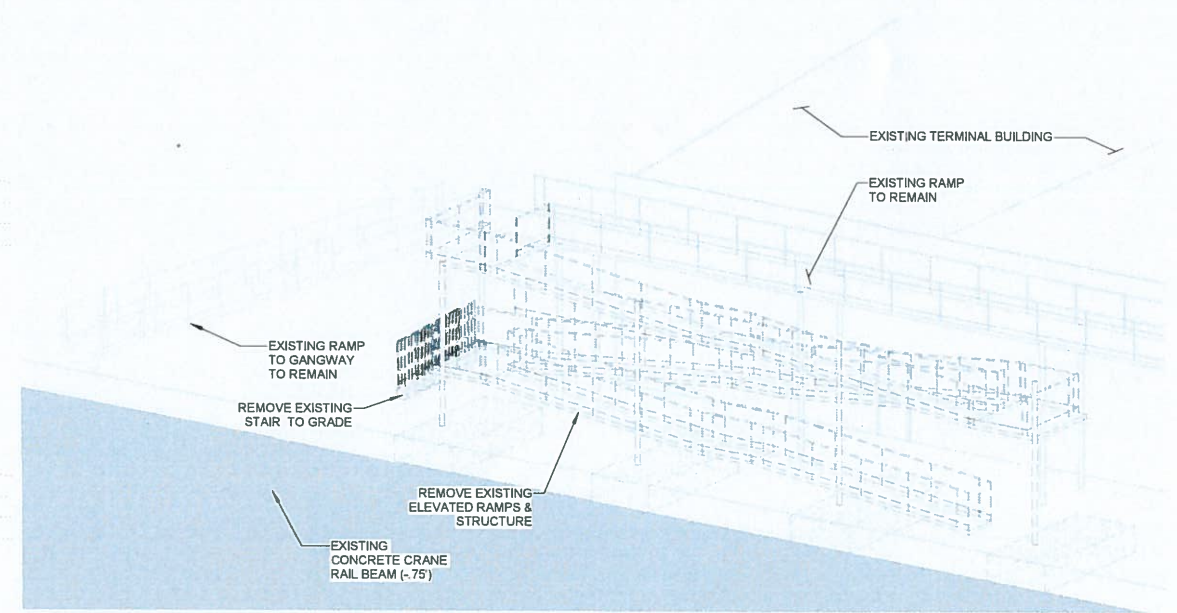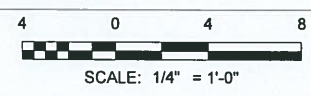

2
SD101 SCALE

RS&H

Engineer of Record:
Richard E. Peters
P.E. No. 33996

RS&H, Inc.

10748 Deerwood Park Blvd. South
Jacksonville, Florida 32256-0597
904-256-2500 Fax 904-256-2503
www.rsandh.com
FL Cert. Nos. AAC001886 * IB26000956 *
5620 * LCC000210 * GB238



**JAXPORT CRUISE
TERMINAL GANGWAY**

CONSULTANTS

AS-BUILT
TO THE BEST OF OUR KNOWLEDGE
THESE DRAWINGS REPRESENT THE
AS CONSTRUCTED CONDITIONS OF
THIS PROJECT.

ACON CONSTRUCTION CO., INC.

REVISIONS

NO.	DESCRIPTION	DATE

DATE ISSUED: 8/16/18
REVIEWED BY: REP
DRAWN BY: PFM
DESIGNED BY: DMH

RS&H PROJECT NO.

101-0003-027

© 2017 RS&H, INC.

SHEET TITLE

**EXISTING RAMP
DEMOLITION
PLAN**

SHEET NUMBER

SD101

**CONSTRUCTION
DOCUMENTS**





JAXPORT CRUISE TERMINAL GANGWAY

CONSULTANTS

AS-BUILT

TO THE BEST OF OUR KNOWLEDGE
THESE DRAWINGS REPRESENT THE
AS CONSTRUCTED CONDITIONS OF
THIS PROJECT.

ACON CONSTRUCTION CO., INC.

REVISIONS

[illegible]

DATE ISSUED: 8/16/18

REVIEWED BY: REP

DRAWN BY: PFM

DESIGNED BY: DMH

RS&H PROJECT NO.

101-0003-027

© 2017 RS&H, INC.


SHEET TITLE

RAMP FRAMING PLAN - LOWER

SHEET NUMBER

S102

CONSTRUCTION DOCUMENTS

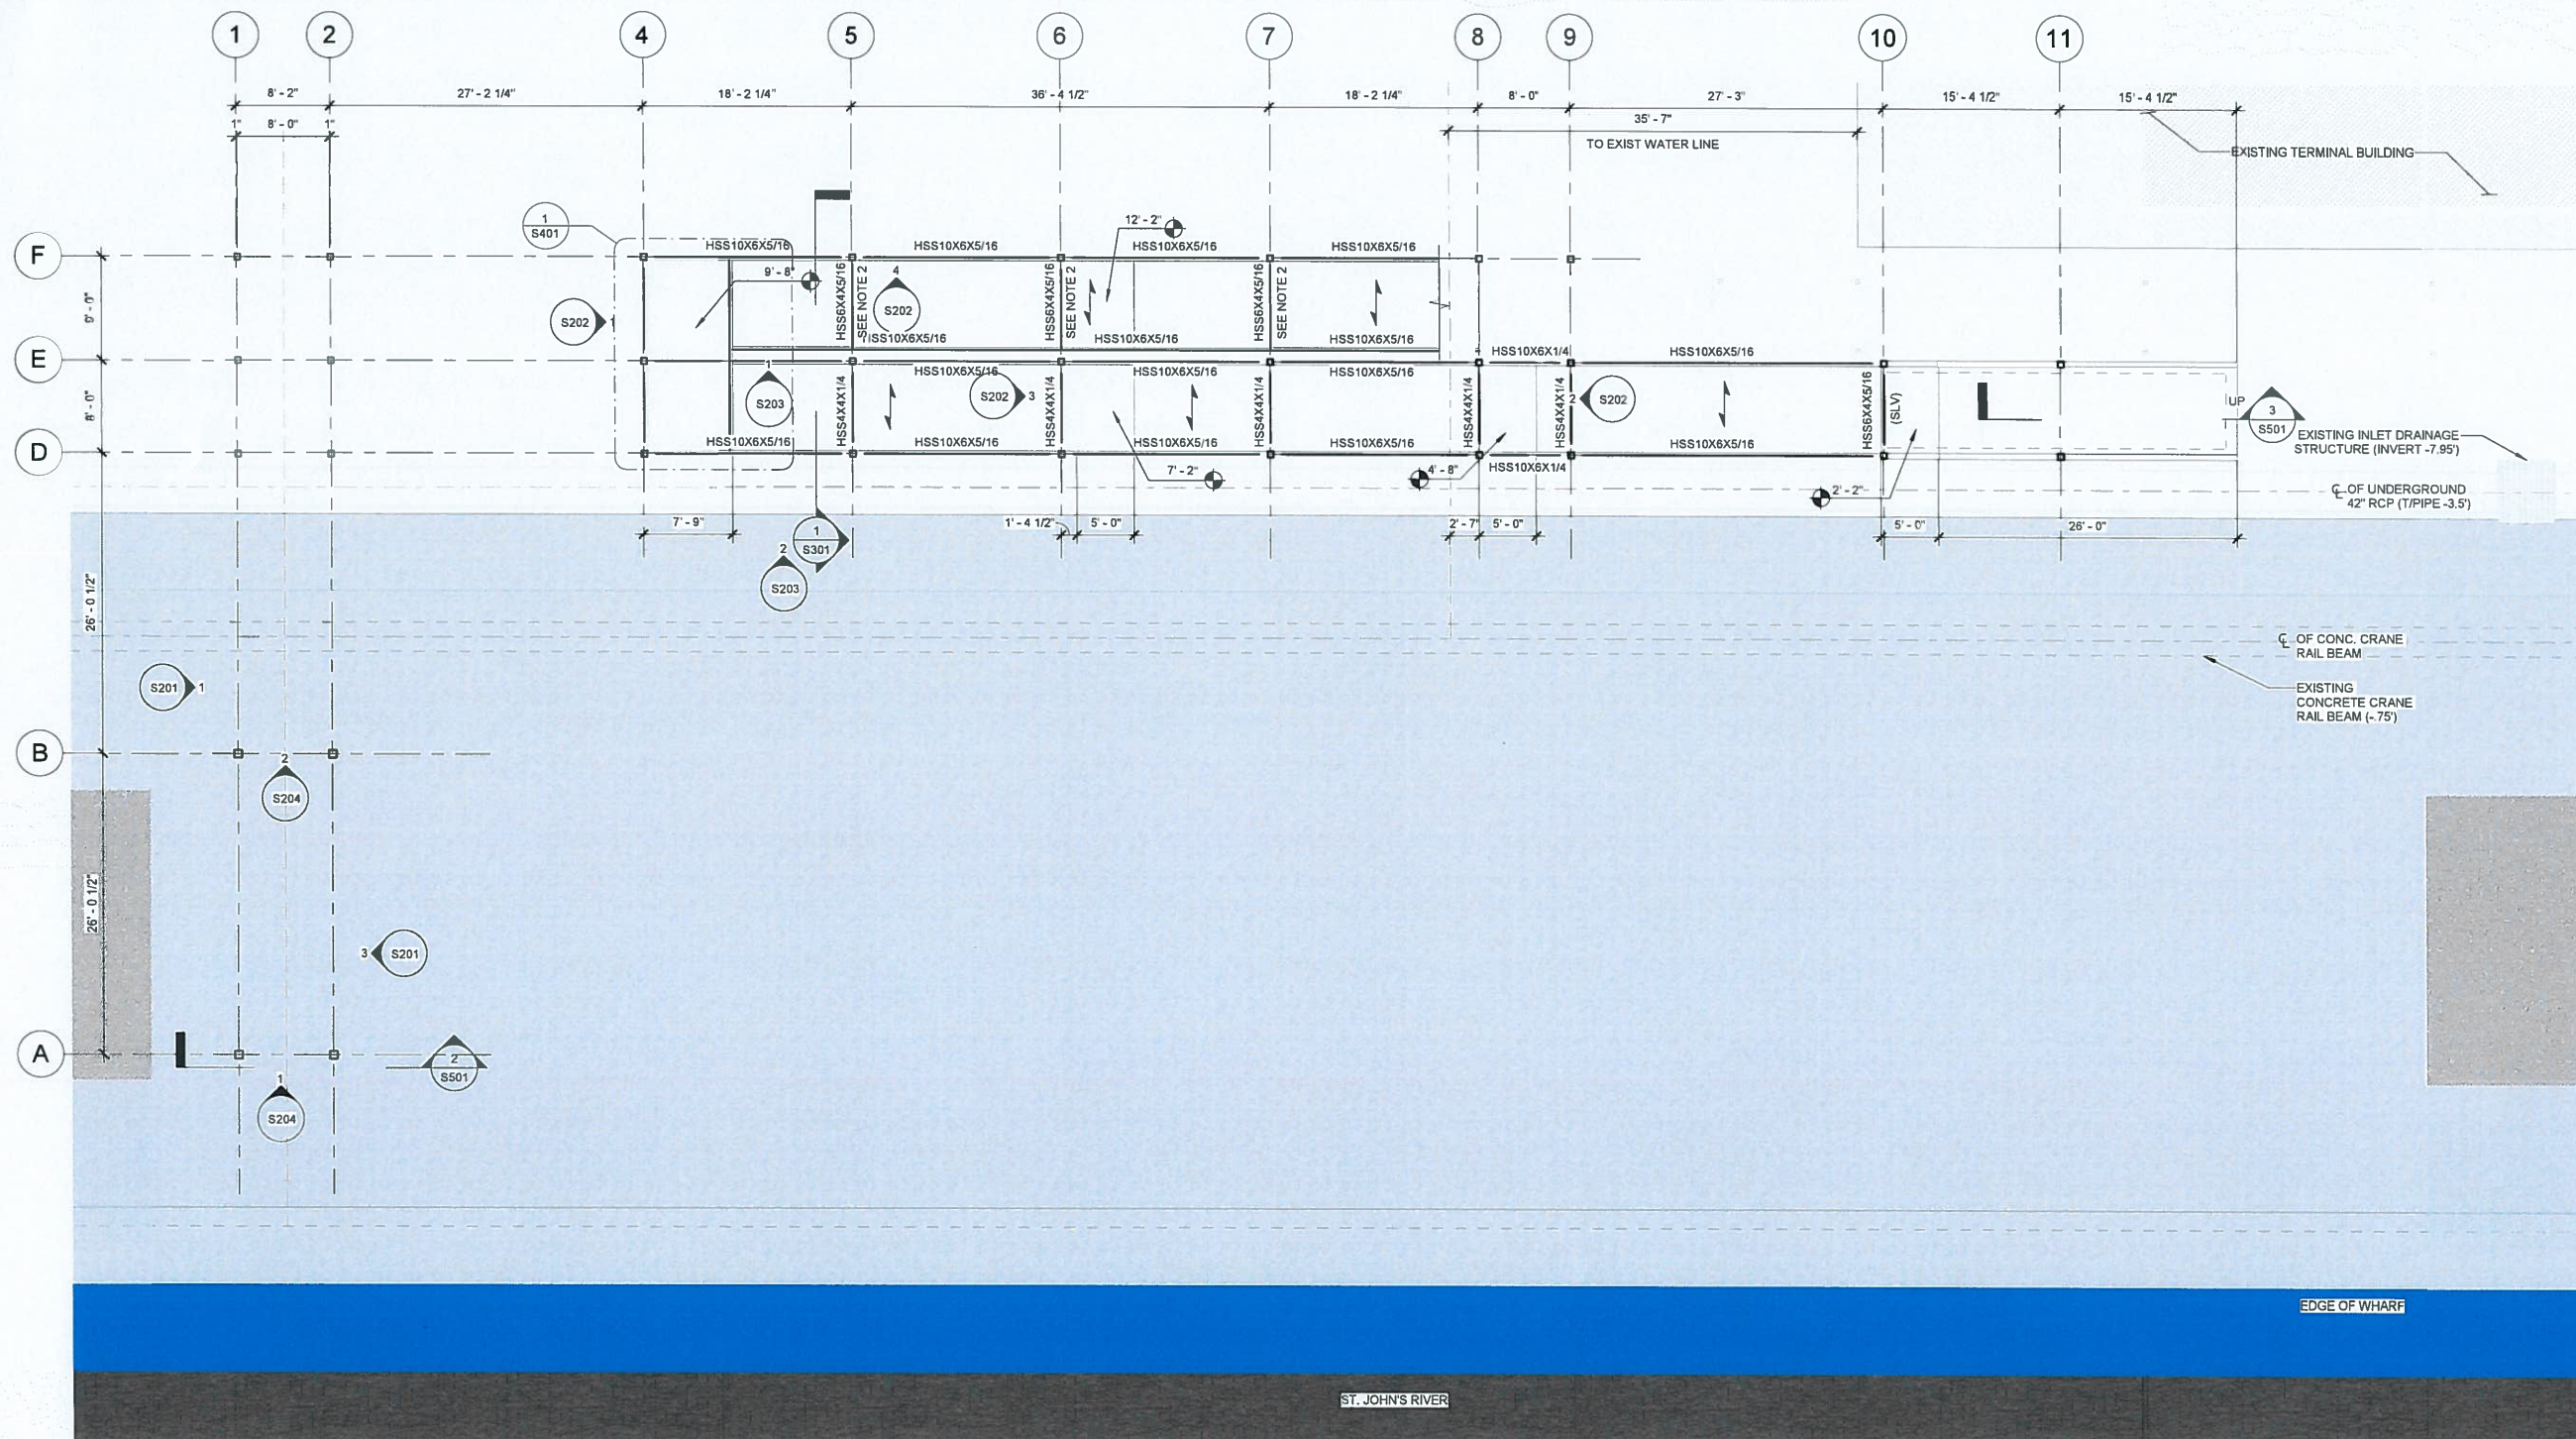

RAMP FRAMING PLAN - LOWER

SCALE: 1/8" = 1'-0"




NOTES:

1. T/STL STRINGER AT PLATFORM & RAMP EDGES IS +4" FROM T/DECK.
2. FOR TRANSVERSE HSS BEAM ELEVATIONS, SEE S200 SHEETS.
3. SEE SHEET S502 & S503 FOR TYPICAL CONNECTIONS.
4. PROVIDE CONTRACTION CONTROL JT'S AT MAX 5'-0" OC AT RAMPS, TYP. SEE S501 FOR DETAIL.
5.  INDICATES FLOOR METAL DECK SPAN DIRECTION. SEE SHEET S012 FOR DECK NOTES.

8 0 8 1

SCALE: 1/8" = 1'-0"

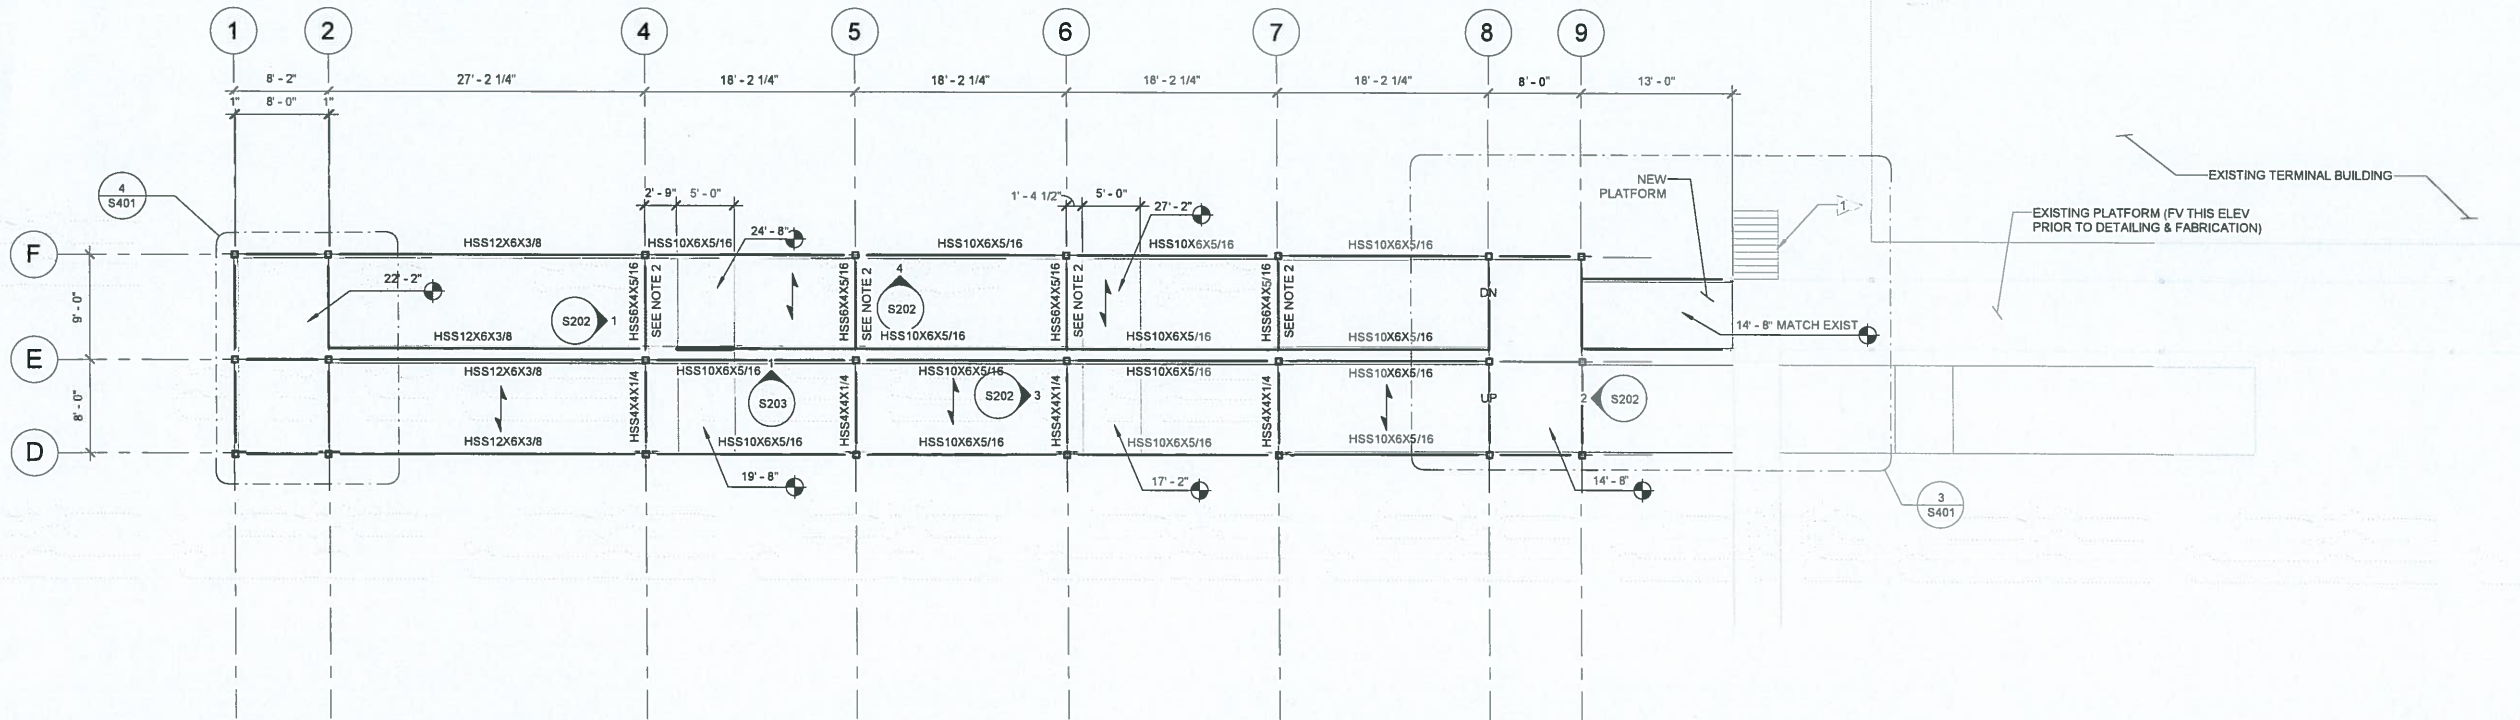


RAMP FRAMING PLAN - INTERMEDIATE



SCALE 1/8" = 1'-0"

- NOTES:**
1. T/STL STRINGER AT PLATFORM & RAMP EDGES IS +4" FROM T/DECK.
 2. FOR TRANSVERSE HSS BEAM ELEVATIONS, SEE S200 SHEETS.
 3. SEE SHEET S502 & S503 FOR TYPICAL CONNECTIONS.
 4. PROVIDE CONTRACTION CONTROL JT'S AT MAX 5'-0" OC AT RAMPS. TYP. SEE S501 FOR DETAIL.
 5. INDICATES FLOOR METAL DECK SPAN DIRECTION. SEE SHEET S012 FOR DECK NOTES.

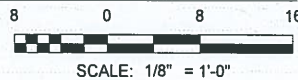

RS&H

Engineer of Record:
Richard E. Peters
P.E. No. 33996

RS&H, Inc.

10748 Deerwood Park Blvd. South
Jacksonville, Florida 32256-0597
904-256-2500 Fax 904-256-2503
www.rsandh.com
FL Cert. Nos. AAC001886 * IB26000955 *
5626 * LCC000210 * GB238

JAXPORT
JACKSONVILLE PORT AUTHORITY

**JAXPORT CRUISE
TERMINAL GANGWAY**

CONSULTANTS

AS-BUILT

TO THE BEST OF OUR KNOWLEDGE
THESE DRAWINGS REPRESENT THE
AS CONSTRUCTED CONDITIONS OF
THIS PROJECT.

ACON CONSTRUCTION CO., INC.

REVISIONS

NO.	DESCRIPTION	DATE

DATE ISSUED: 8/16/18

REVIEWED BY: REP

DRAWN BY: PFM

DESIGNED BY: DMH

RS&H PROJECT NO.

101-0003-027

© 2017 RS&H, INC.


SHEET TITLE

**RAMP FRAMING
PLAN -
INTERMEDIATE**


SHEET NUMBER

S103

**CONSTRUCTION
DOCUMENTS**

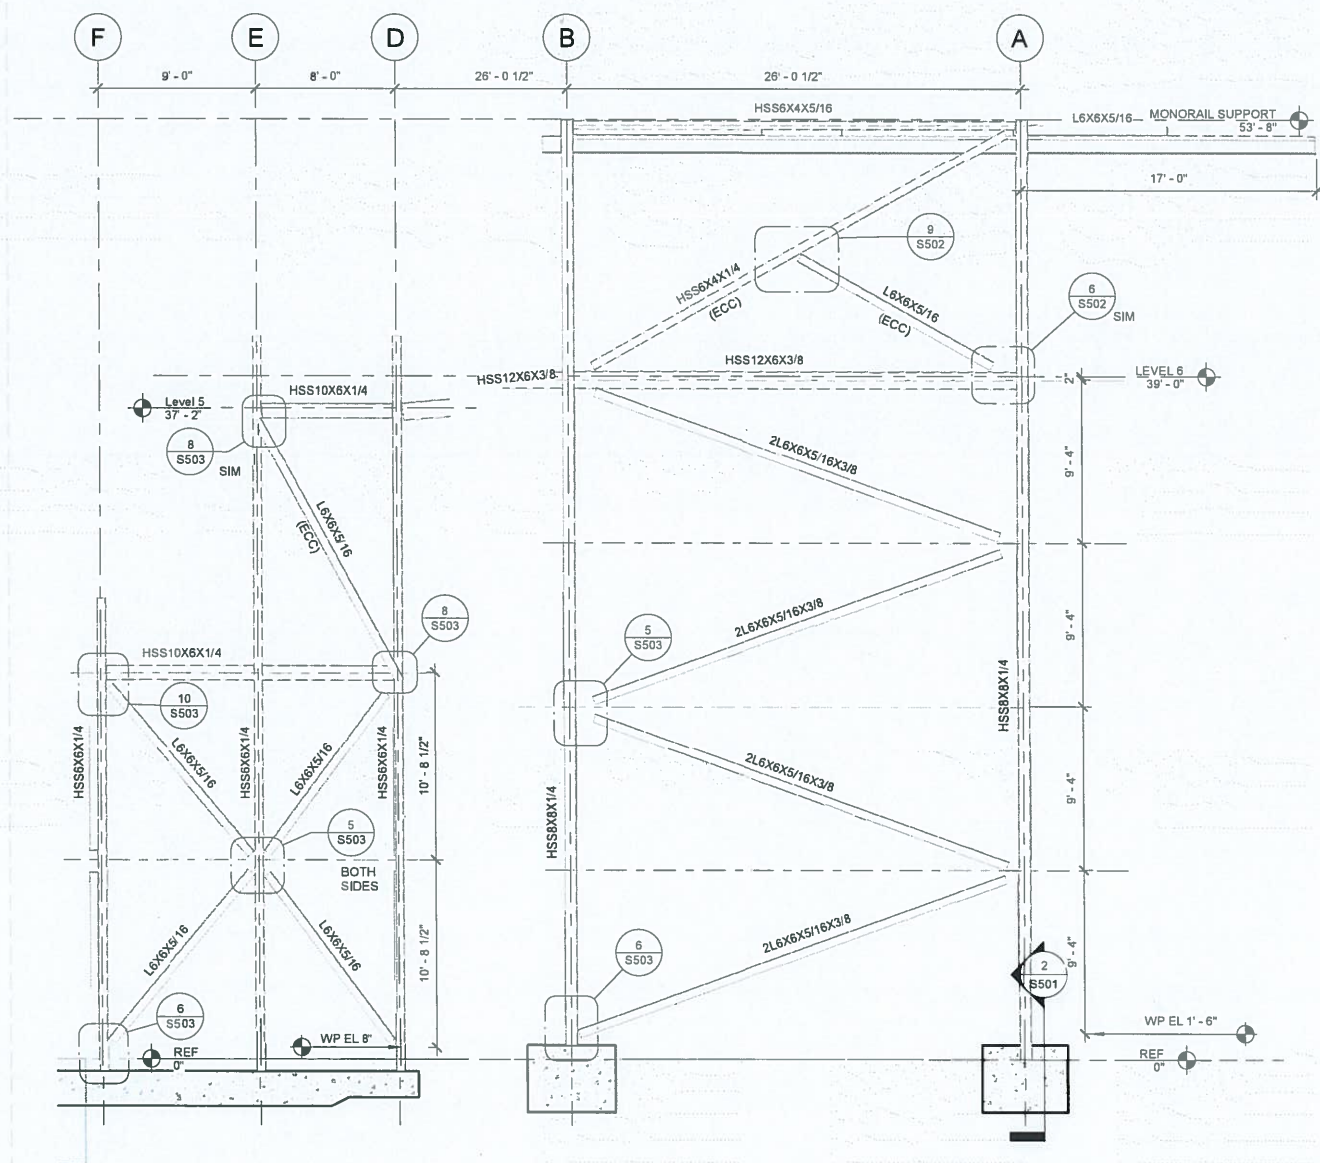

GRID 1 FRAMING ELEVATION

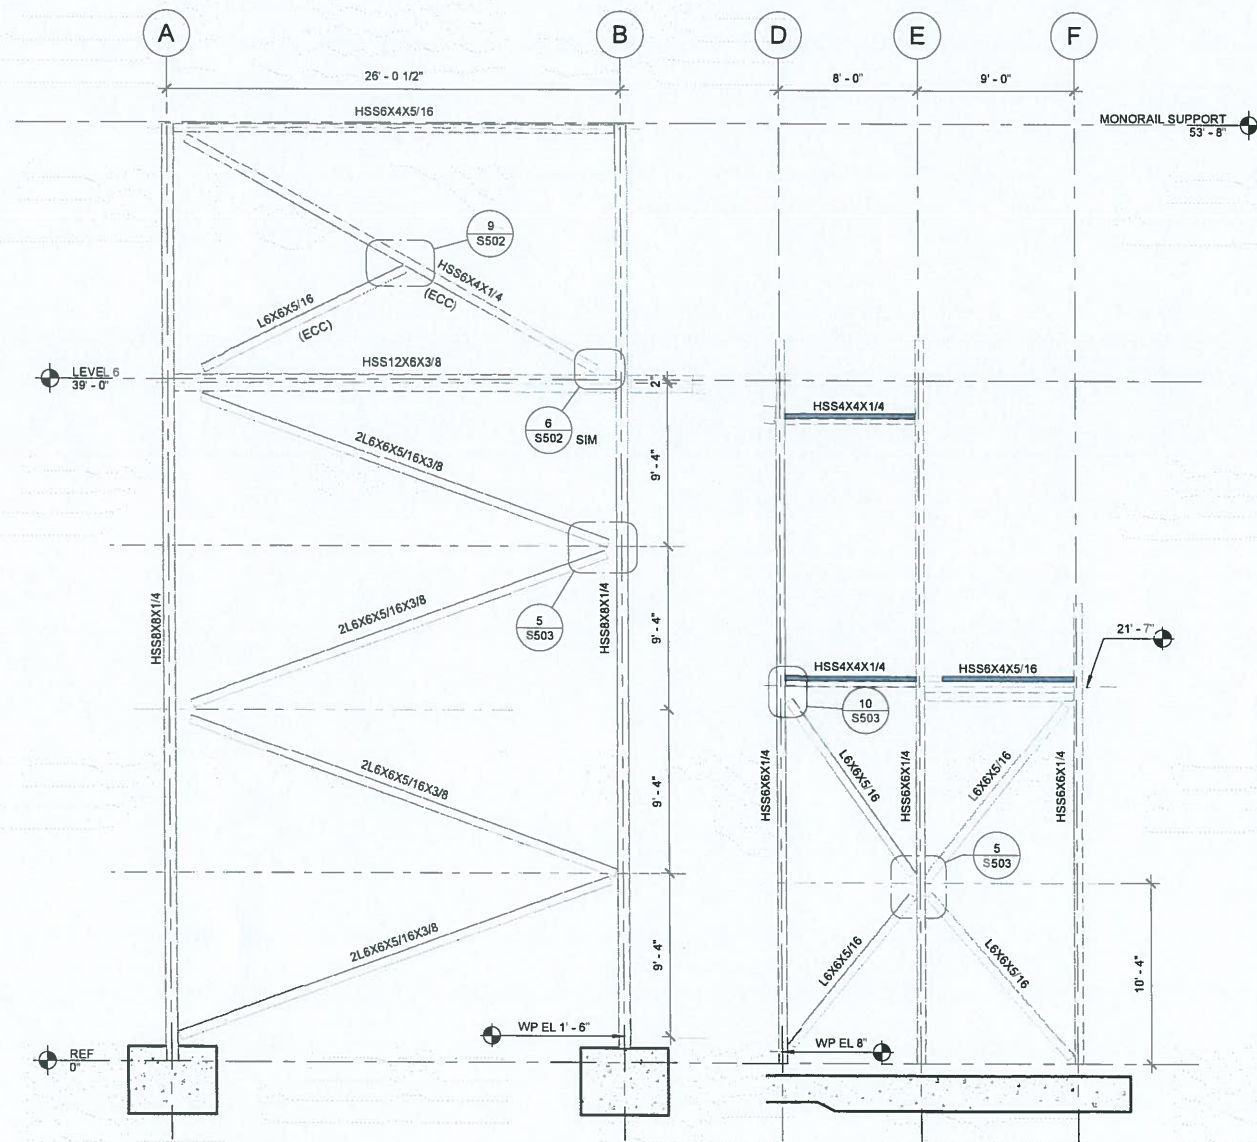

3 GRID 2 FRAMING ELEVATION
S201 SCALE: 3/16" = 1'-0"

FRAMING ELEVATION NOTES:

-  INDICATES TOP OF RAMP ELEVATION.
- (+/- 'X'-X") INDICATES WORK POINT ELEVATION ABOVE OR BELOW TOP OF RAMP.
1. T/STL STRINGER IS +4' FROM T/DECK.
 2. FOR LANDING DIMENSIONS AND ELEVATIONS. SEE FRAMING PLANS.
 3. SEE SHEET S502 & S503 FOR TYPICAL CONNECTIONS.
 4. (ECG) INDICATES ECCENTRIC BRACE. FOR WHICH FACE OF BRACE IS ALIGNED TO FACE OF SUPPORTING HSS MEMBERS AT END CONNECTIONS.

RS&H

Engineer of Record:
Richard E. Peters
P.E. No. 33996

RS&H, Inc.

10748 Deerwood Park Blvd. South
Jacksonville, Florida 32256-0597
904-256-2500 Fax 904-256-2503
www.rsandh.com
FL Cert. Nos. AAC001886 * IB26000956 *
5620 * LCC000210 * GB238



**JAXPORT CRUISE
TERMINAL GANGWAY**

CONSULTANTS

AS-BUILT
TO THE BEST OF OUR KNOWLEDGE
THESE DRAWINGS REPRESENT THE
AS CONSTRUCTED CONDITIONS OF
THIS PROJECT.

ACON CONSTRUCTION CO., INC

REVISIONS

[illegible]

DATE ISSUED: 8/16/18

REVIEWED BY: REP

DRAWN BY: PFM

DESIGNED BY: DMH

RS&H PROJECT NO.

101-0003-027

© 2017 RS&H, INC.


SHEET TITLE




FRAMING ELEVATIONS - 1

SHEET NUMBER

S201

CONSTRUCTION DOCUMENTS

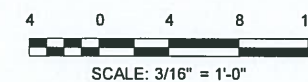

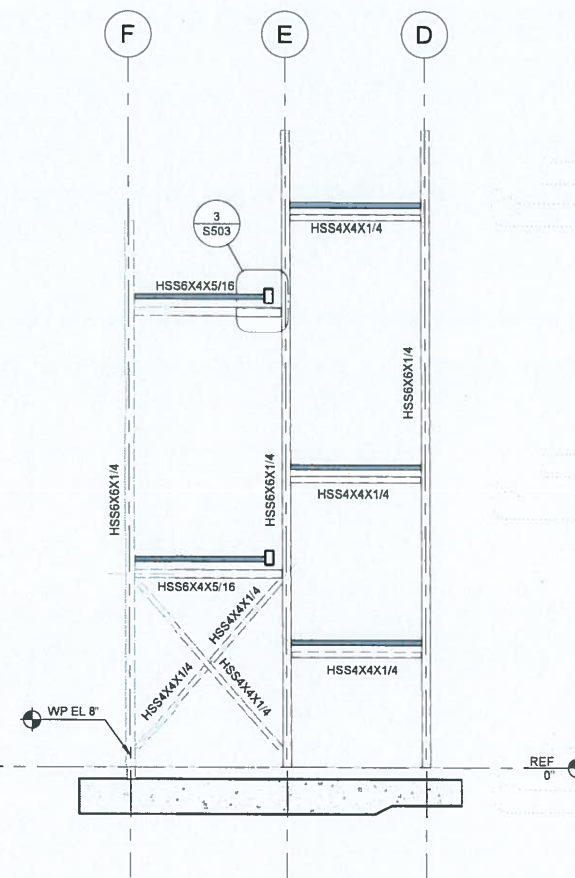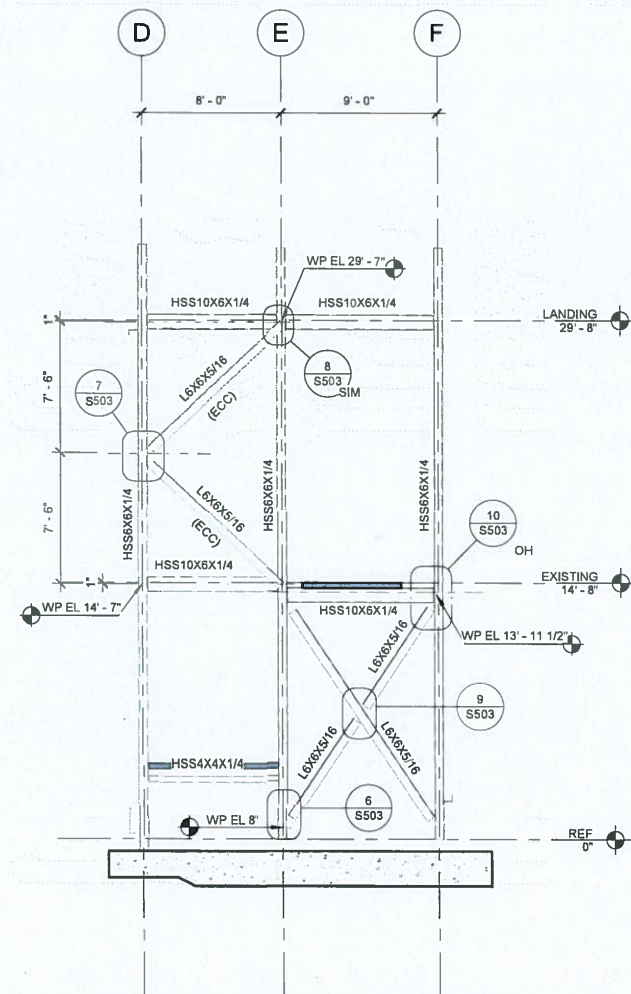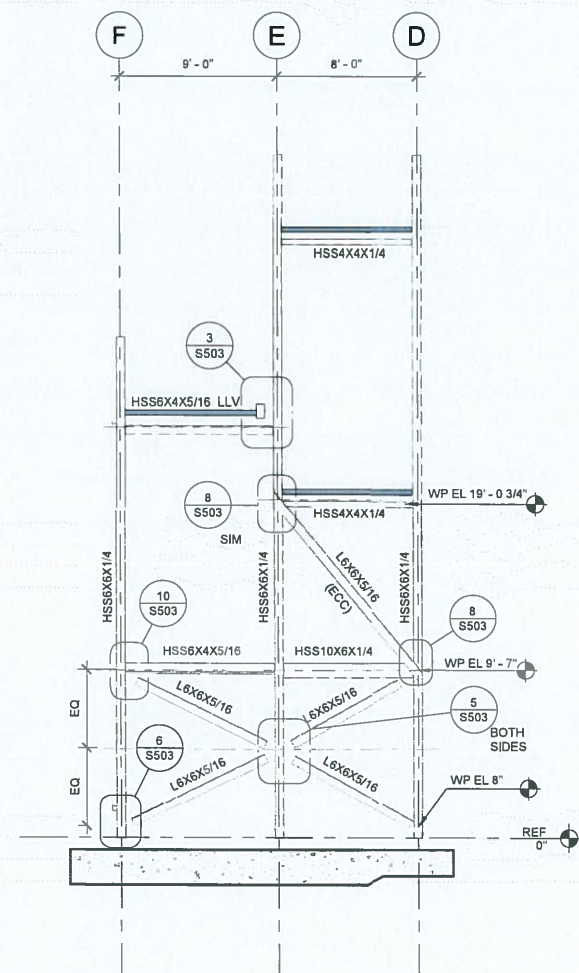


FRAMING ELEVATION NOTES:

 INDICATES TOP OF RAMP ELEVATION.

(+/- X'-X'") INDICATES WORK POINT ELEVATION ABOVE OR BELOW TOP OF RAMP.

1. T/STL STRINGER IS +4" FROM T/DECK.
2. FOR LANDING DIMENSIONS AND ELEVATIONS, SEE FRAMING PLANS.
3. SEE SHEET S502 & S503 FOR TYPICAL CONNECTIONS.
4. (ECC) INDICATES ECCENTRIC BRACE, FOR WHICH FACE OF BRACE IS ALIGNED TO FACE OF SUPPORTING HSS MEMBERS AT END CONNECTIONS.

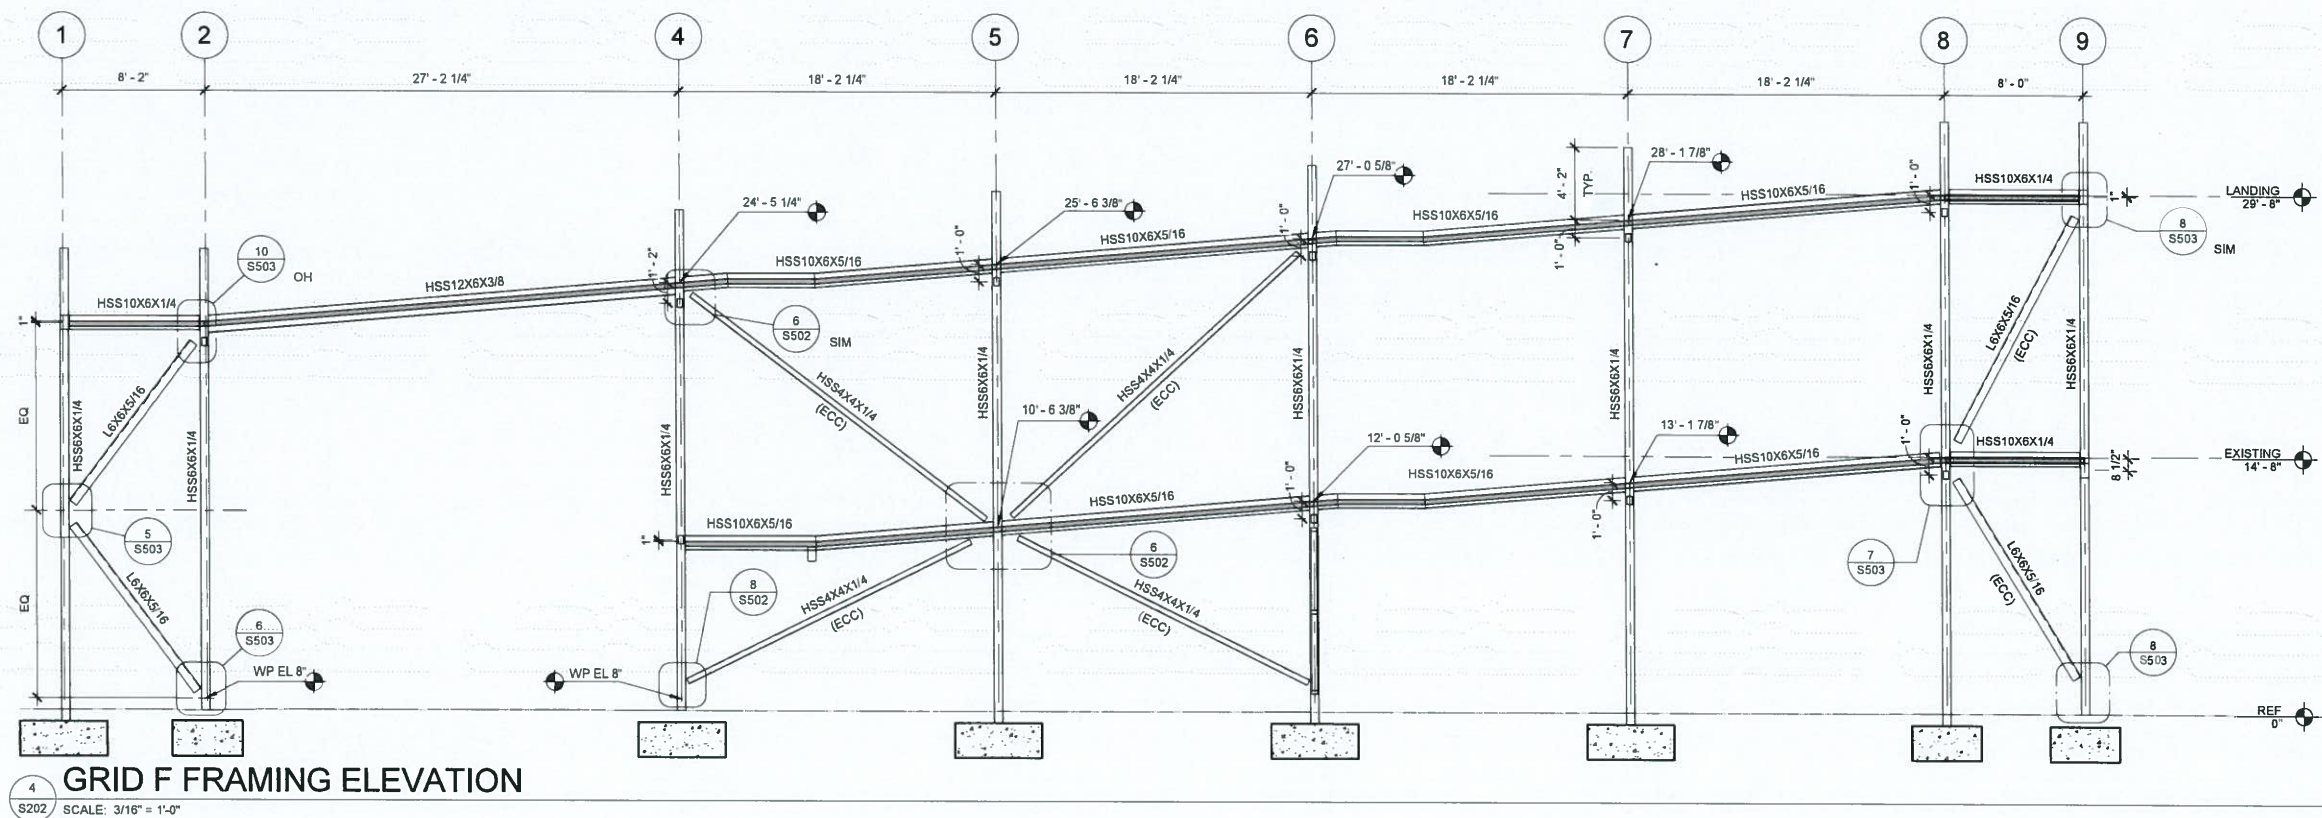

4 0 4 8 1
SCALE: $\frac{3}{16}" = 1'-0"$

C:\Users\mullr\Documents\1010003026_JAXPORT Cruise Gangway S_R17 pmull.rvt

8/17/2018 12:51:16 PM

RS&H

Engineer of Record:
Richard E. Peters
P.E. No. 33996

RS&H, Inc.

10748 Deerwood Park Blvd. South
Jacksonville, Florida 32256-0597
904-256-2500 Fax 904-256-2503
www.rsandh.com
FL Cert. Nos. AAC901886 * IB26000956 *
5620 * LCC000210 * GB238



**JAXPORT CRUISE
TERMINAL GANGWAY**

CONSULTANTS

AS-BUILT

TO THE BEST OF OUR KNOWLEDGE
THESE DRAWINGS REPRESENT THE
AS CONSTRUCTED CONDITIONS OF
THIS PROJECT.

ACON CONSTRUCTION CO., INC.

REVISIONS

[illegible]

DATE ISSUED: 8/16/18

REVIEWED BY: REP

DRAWN BY: **PFM**

DESIGNED BY: DMH

RS&H PROJECT NO.

101-0003-027

© 2017 RS&H, INC.


SHEET TITLE

FRAMING ELEVATIONS - 2

SHEET NUMBER

S202


CONSTRUCTION DOCUMENTS

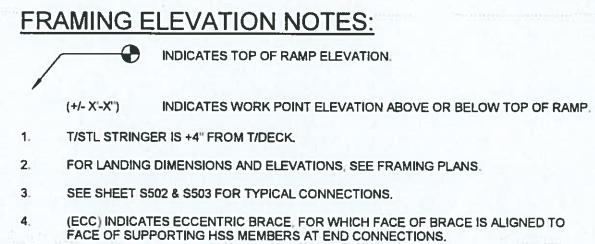[illegible]


8 0 8 16

SCALE: $1/8" = 1'-0"$

CONSTRUCTION DOCUMENTS

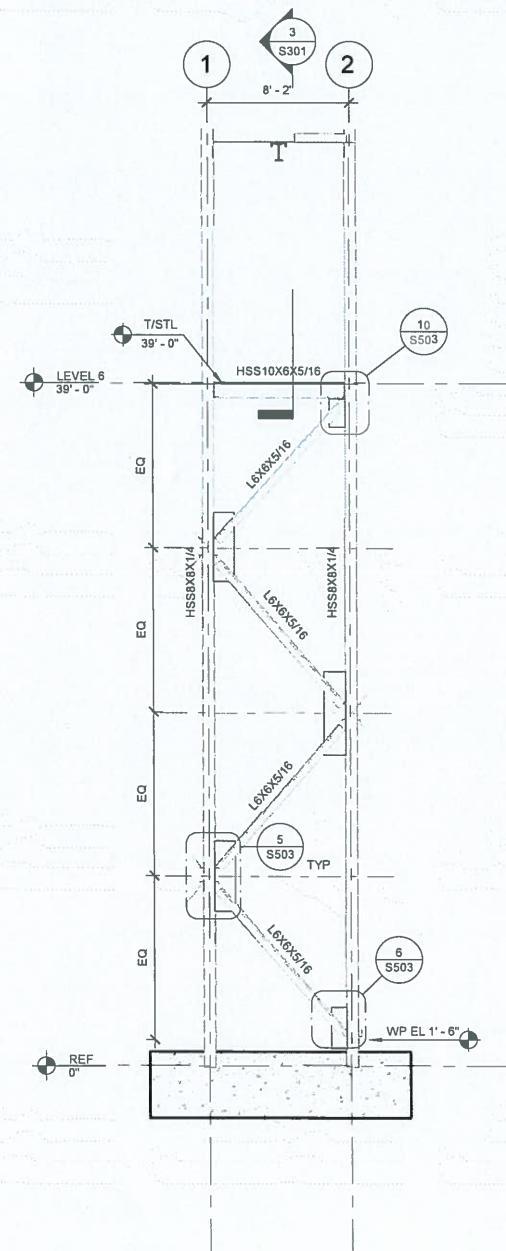

GRID A FRAMING ELEVATION

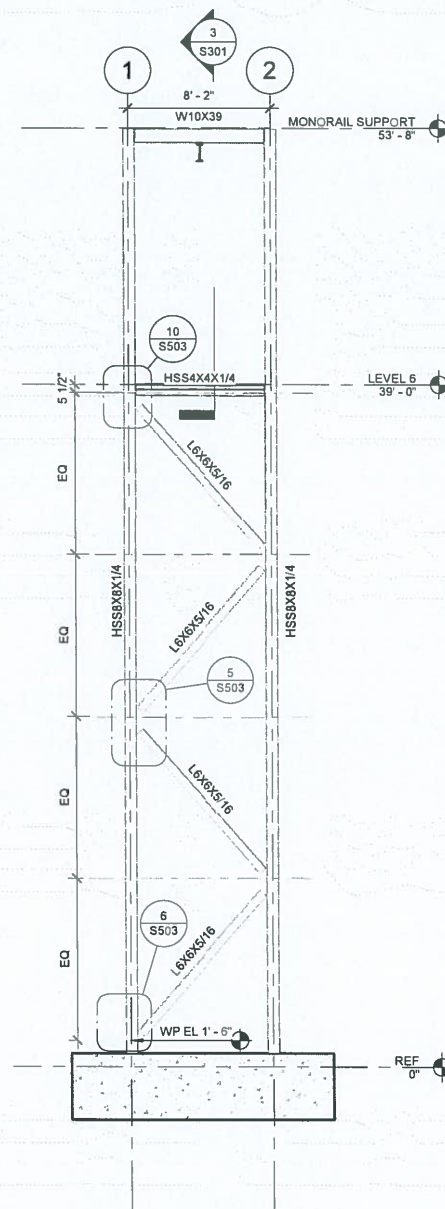

2 GRID B FRAMING ELEVATION
S204 SCALE 3/16" = 1'-0"

FRAMING ELEVATION NOTES:

-  INDICATES TOP OF RAMP ELEVATION.
-  (+/- 'X'-'X') INDICATES WORK POINT ELEVATION ABOVE OR BELOW TOP OF RAMP.
1. T&T/L STRINGER IS +4" FROM T/DECK.
 2. FOR LANDING DIMENSIONS AND ELEVATIONS, SEE FRAMING PLANS.
 3. SEE SHEET S502 & S503 FOR TYPICAL CONNECTIONS.
 4. (EC) INDICATES ECCENTRIC BRACE, FOR WHICH FACE OF BRACE IS ALIGNED TO FACE OF SUPPORTING HSS MEMBERS AT END CONNECTIONS.

RS&H

Engineer of Record:
Richard E. Peters
P.E. No. 33996

RS&H, Inc.

10748 Deerwood Park Blvd. South
Jacksonville, Florida 32256-0597
904-256-2500 Fax 904-256-2503
www.rsandh.com
FL Cert. Nos. AAC001886 * IB26000956 *
5620 * LCC000210 * GB238



**JAXPORT CRUISE
TERMINAL GANGWAY**

CONSULTANTS

AS-BUILT

TO THE BEST OF OUR KNOWLEDGE
THESE DRAWINGS REPRESENT THE
AS CONSTRUCTED CONDITIONS OF
THIS PROJECT.

ACON CONSTRUCTION CO., INC.

REVISIONS

[illegible]

DATE ISSUED:	8/16/18
REVIEWED BY:	REP
DRAWN BY:	PFM
DESIGNED BY:	DMH

RS&H PROJECT NO.

101-0003-027

© 2017 RS&H, INC.


SHEET TITLE

FRAMING ELEVATIONS - 4


SHEET NUMBER

S204



CONSTRUCTION DOCUMENTS

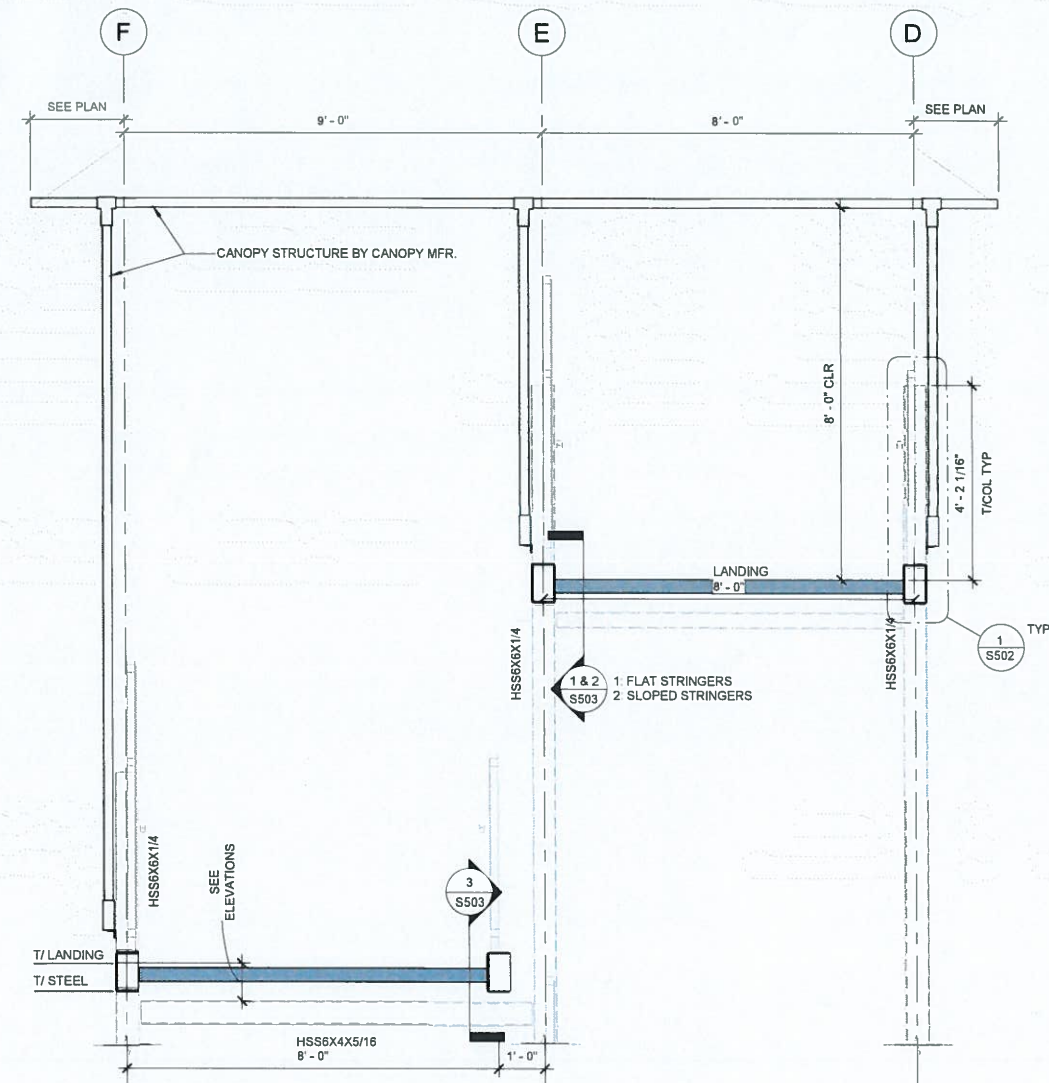

1 TYPICAL RAMP SECTION
SCALE: 1/2" = 1'-0"

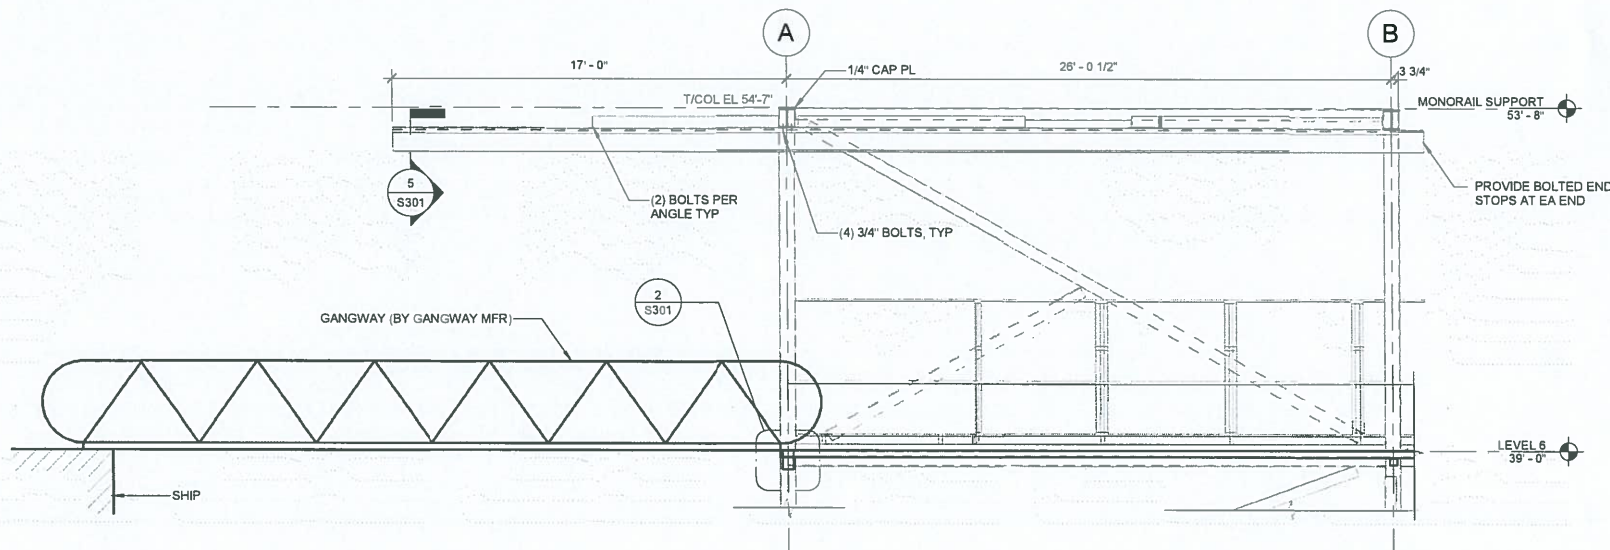


3 MONORAIL SUPPORT SECTION
SCALE: 1/4" = 1'-0"

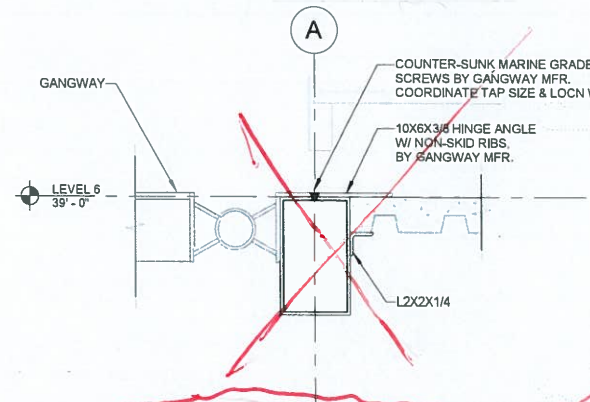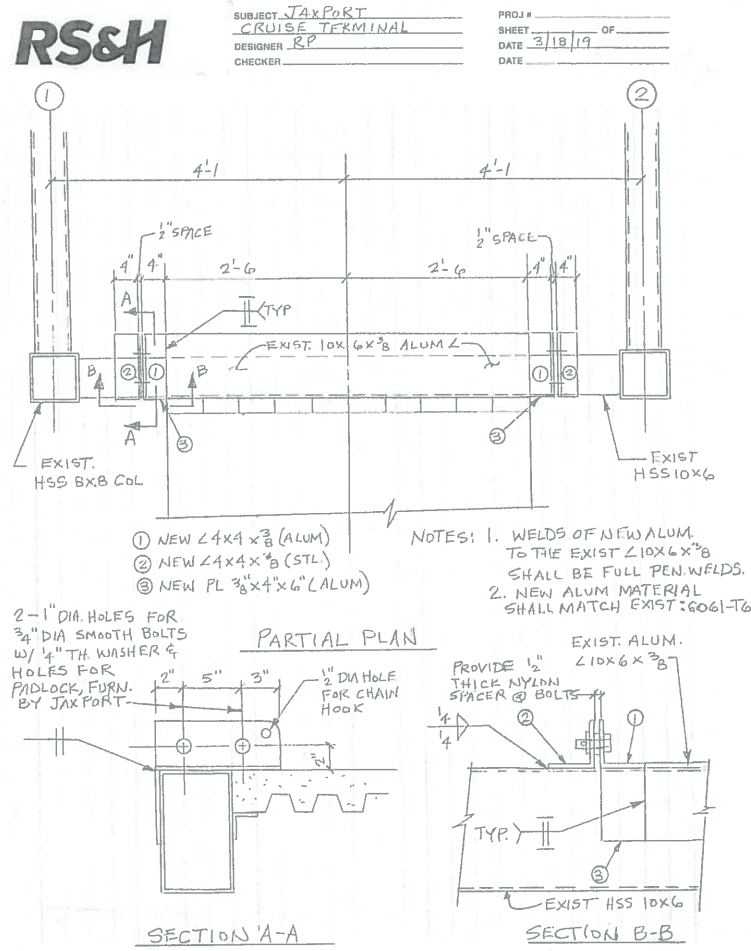

2 GANGWAY CONN DETAIL
SCALE: 1 1/2" = 1'-0"
Revised



5 SECTION
SCALE: 3/4" = 1'-0"

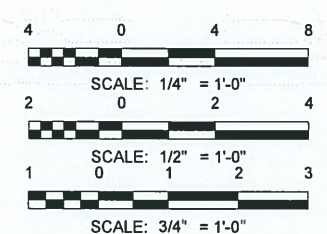

RS&H

Engineer of Record:
Richard E. Peters
P.E. No. 33996

RS&H, Inc.
10748 Deerwood Park Blvd. South
Jacksonville, Florida 32256-0597
904-256-2500 Fax 904-256-2503
www.rsandh.com
FL Cert. Nos. AAC001886 * IB25000956 *
5620 * LCC000210 * GB238

JAXPORT
JACKSONVILLE PORT AUTHORITY

**JAXPORT CRUISE
TERMINAL GANGWAY**

CONSULTANTS

AS-BUILT
TO THE BEST OF OUR KNOWLEDGE
THESE DRAWINGS REPRESENT THE
AS CONSTRUCTED CONDITIONS OF
THIS PROJECT.

ACON CONSTRUCTION CO., INC.

REVISIONS

NO.	DESCRIPTION	DATE

DATE ISSUED: 8/16/18
REVIEWED BY: REP
DRAWN BY: PFM
DESIGNED BY: DMH

RS&H PROJECT NO.

101-0003-027

© 2017 RS&H, INC.

SHEET TITLE

**STRUCTURAL
SECTIONS**

SHEET NUMBER

S301


**CONSTRUCTION
DOCUMENTS**



Expansion Joint Added



CONSTRUCTION DOCUMENTS

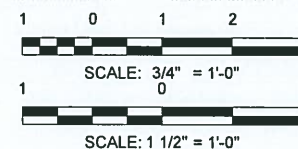

CONSTRUCTION DOCUMENTS

Engineer of Record:
Richard E. Peters
P.E. No. 33996

RS&H, Inc.
10748 Deerwood Park Blvd. South
Jacksonville, Florida 32256-0597
904-256-2500 Fax 904-256-2503
www.rsandh.com
FL Cert. Nos. AAC901886 * IB26000956 *
5620 * LCC000210 * GB238



**JAXPORT CRUISE
TERMINAL GANGWAY**

CONSULTANTS

AS-BUILT
TO THE BEST OF OUR KNOWLEDGE
THESE DRAWINGS REPRESENT THE
AS CONSTRUCTED CONDITIONS OF
THIS PROJECT.

ACON CONSTRUCTION CO., INC.

REVISIONS

[illegible]

DATE ISSUED: 8/16/18

REVIEWED BY: REP

DRAWN BY: PFM

DESIGNED BY: DMH

RS&H PROJECT NO.

101-0003-027

© 2017 RS&H, INC.


SHEET TITLE

REFERENCE DRAWING-1

SHEET NUMBER

S801

CONSTRUCTION DOCUMENTS

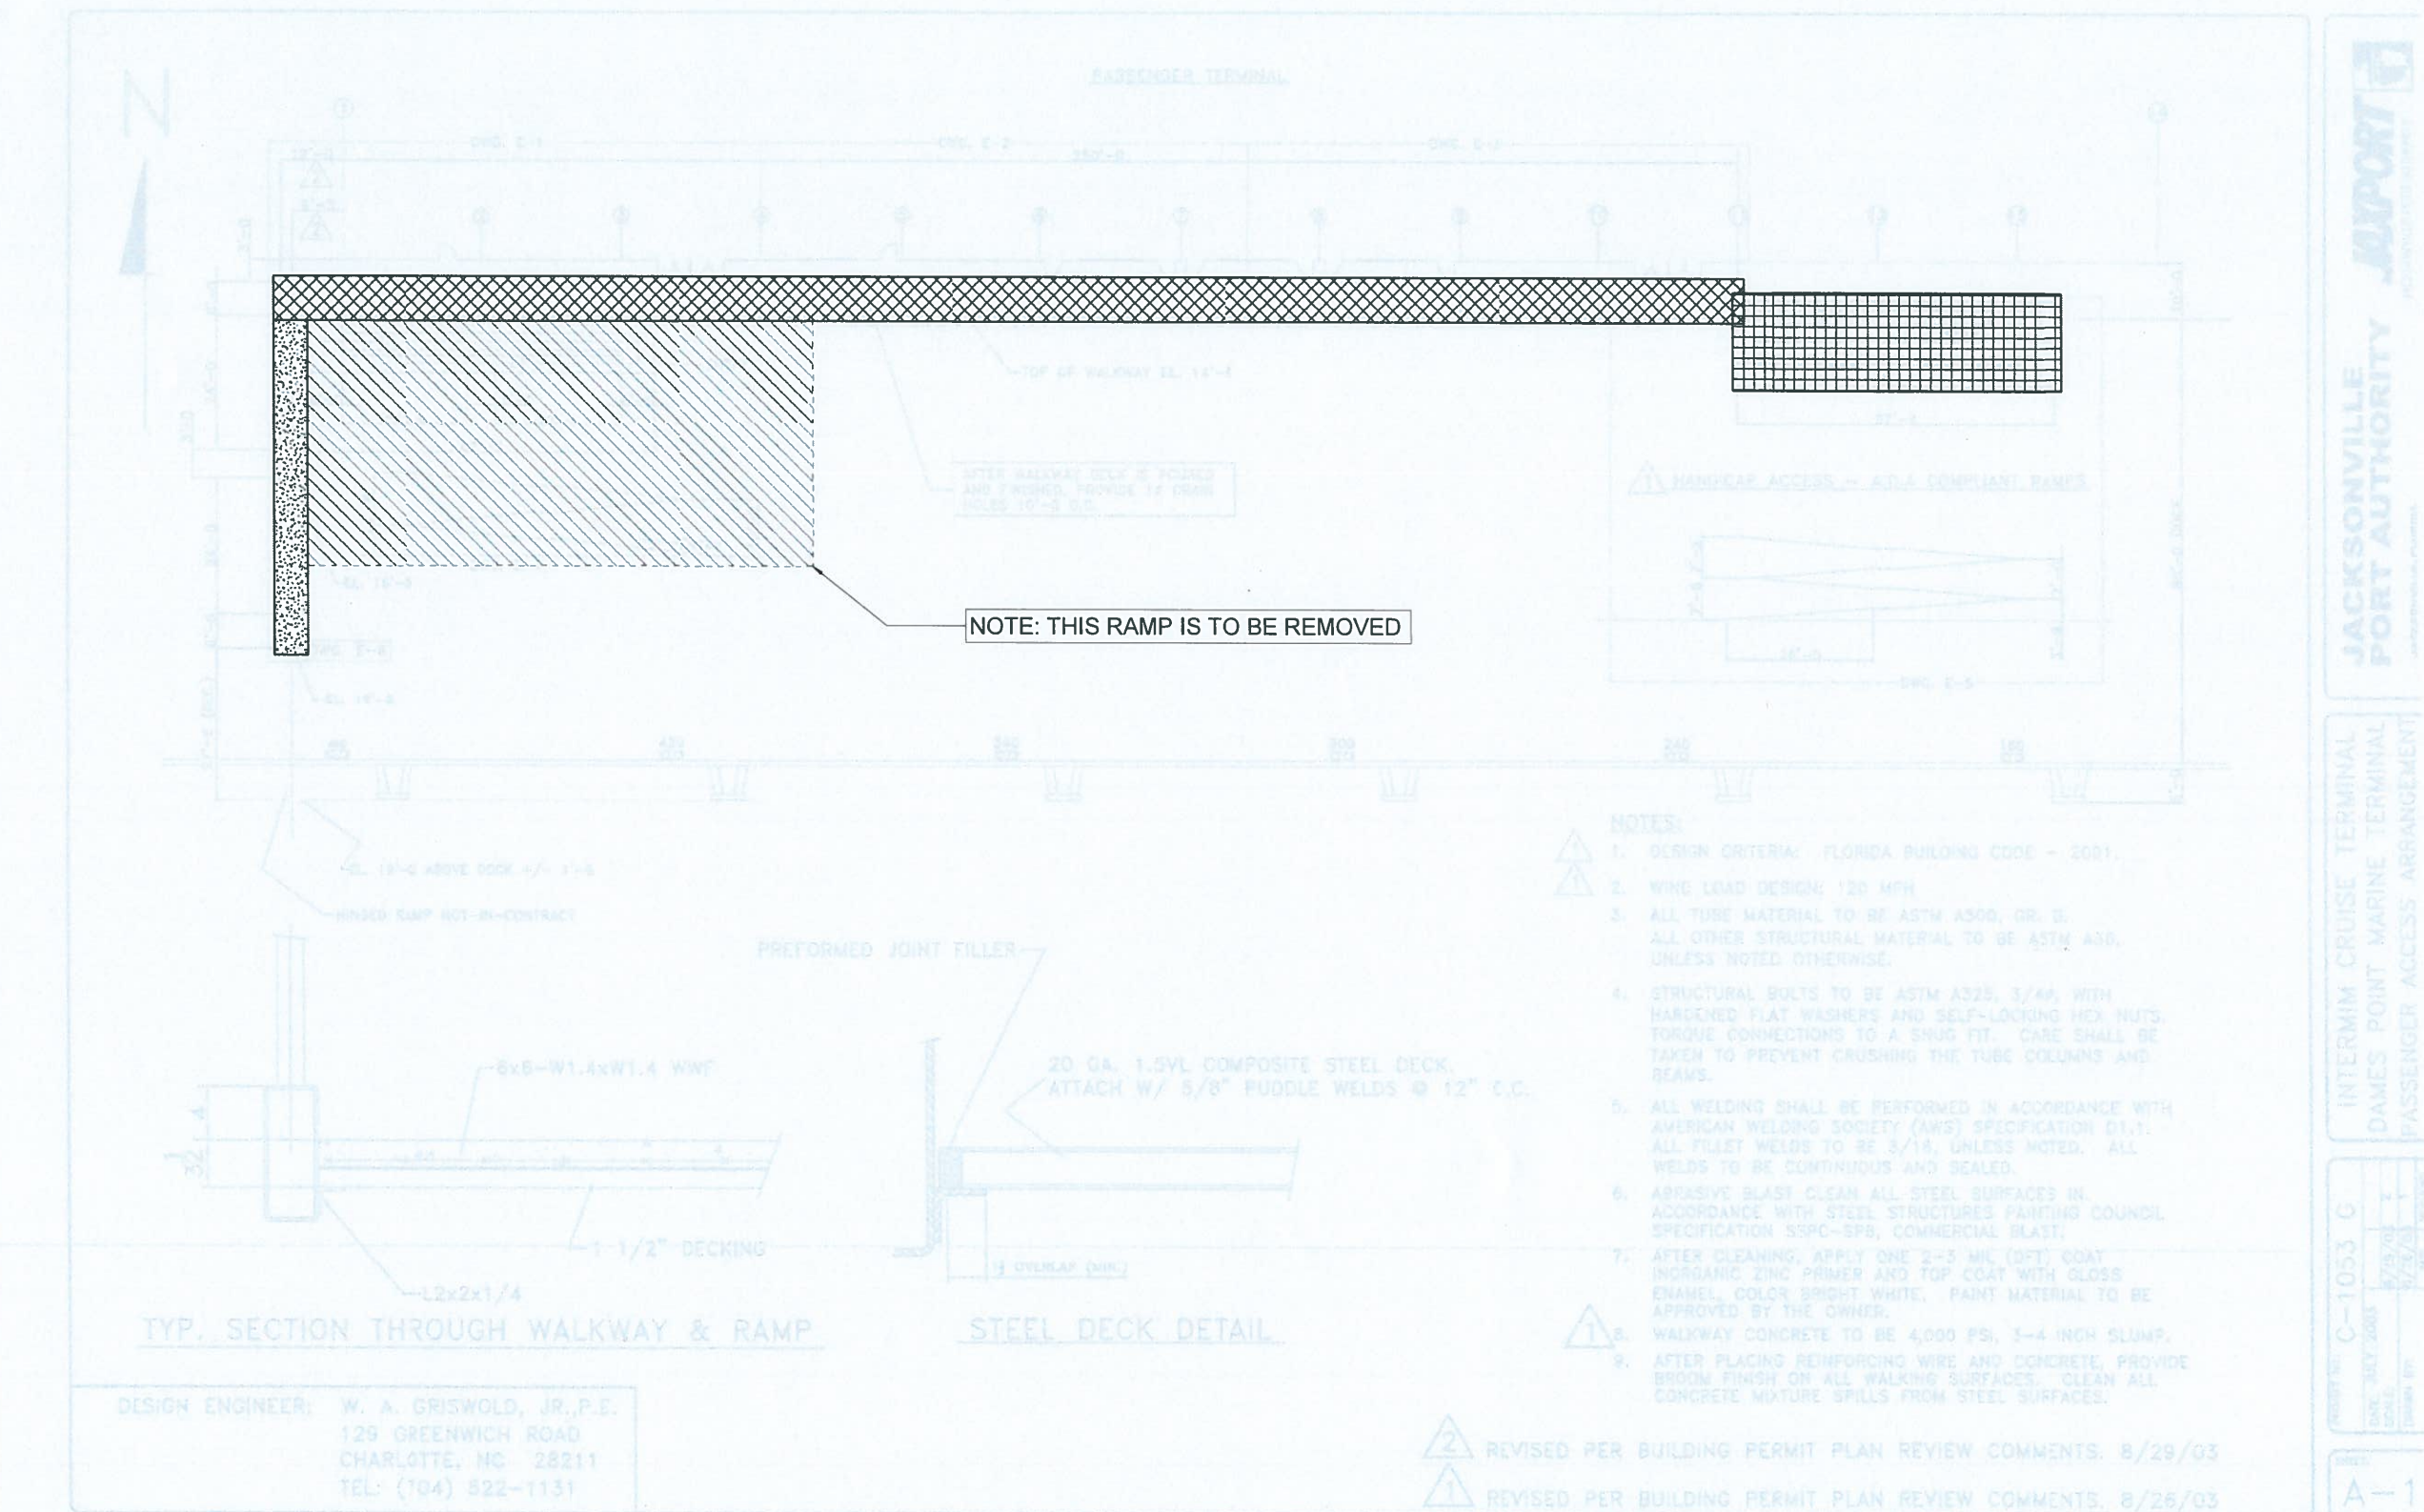

EXIST SHEET A-1

SCALE: 1/16" = 1'-0"

NOTE:

NOTE:
THIS SHEET IS A DUPLICATION OF ORIGINAL CONSTRUCTION DOCUMENTS, AND IS
BEING PROVIDED FOR INFORMATION, ONLY. FIELD VERIFY AS BUILT CONDITIONS.

PATTERN LEGEND:

-  PROVIDE PANEL INFILL, ONLY (NO CANVAS)
 PROVIDE CANVAS, ONLY (NO PANEL INFILL)
 PROVIDE PANEL INFILL & CANVAS

RS&H, Inc.
10748 Deerwood Park Blvd. South
Jacksonville, Florida 32256-0597
904-256-2500 Fax 904-256-2503
www.rsandh.com
FL Cert. Nos. AAC001886 * IB26000956 *
5620 * LCC000210 * GB238



**JAXPORT CRUISE
TERMINAL GANGWAY**

CONSULTANTS

AS-BUILT

TO THE BEST OF OUR KNOWLEDGE
THESE DRAWINGS REPRESENT THE
AS CONSTRUCTED CONDITIONS OF
THIS PROJECT.

ACON CONSTRUCTION CO., INC.

REVISIONS

[illegible]

DATE ISSUED: 8/16/18

REVIEWED BY: REP

DRAWN BY: PFM

DESIGNED BY: DMH

RS&H PROJECT NO.

101-0003-027

© 2017 RS&H, INC.


SHEET TITLE

REFERENCE DRAWING-5

SHEET NUMBER

S805

CONSTRUCTION DOCUMENTS

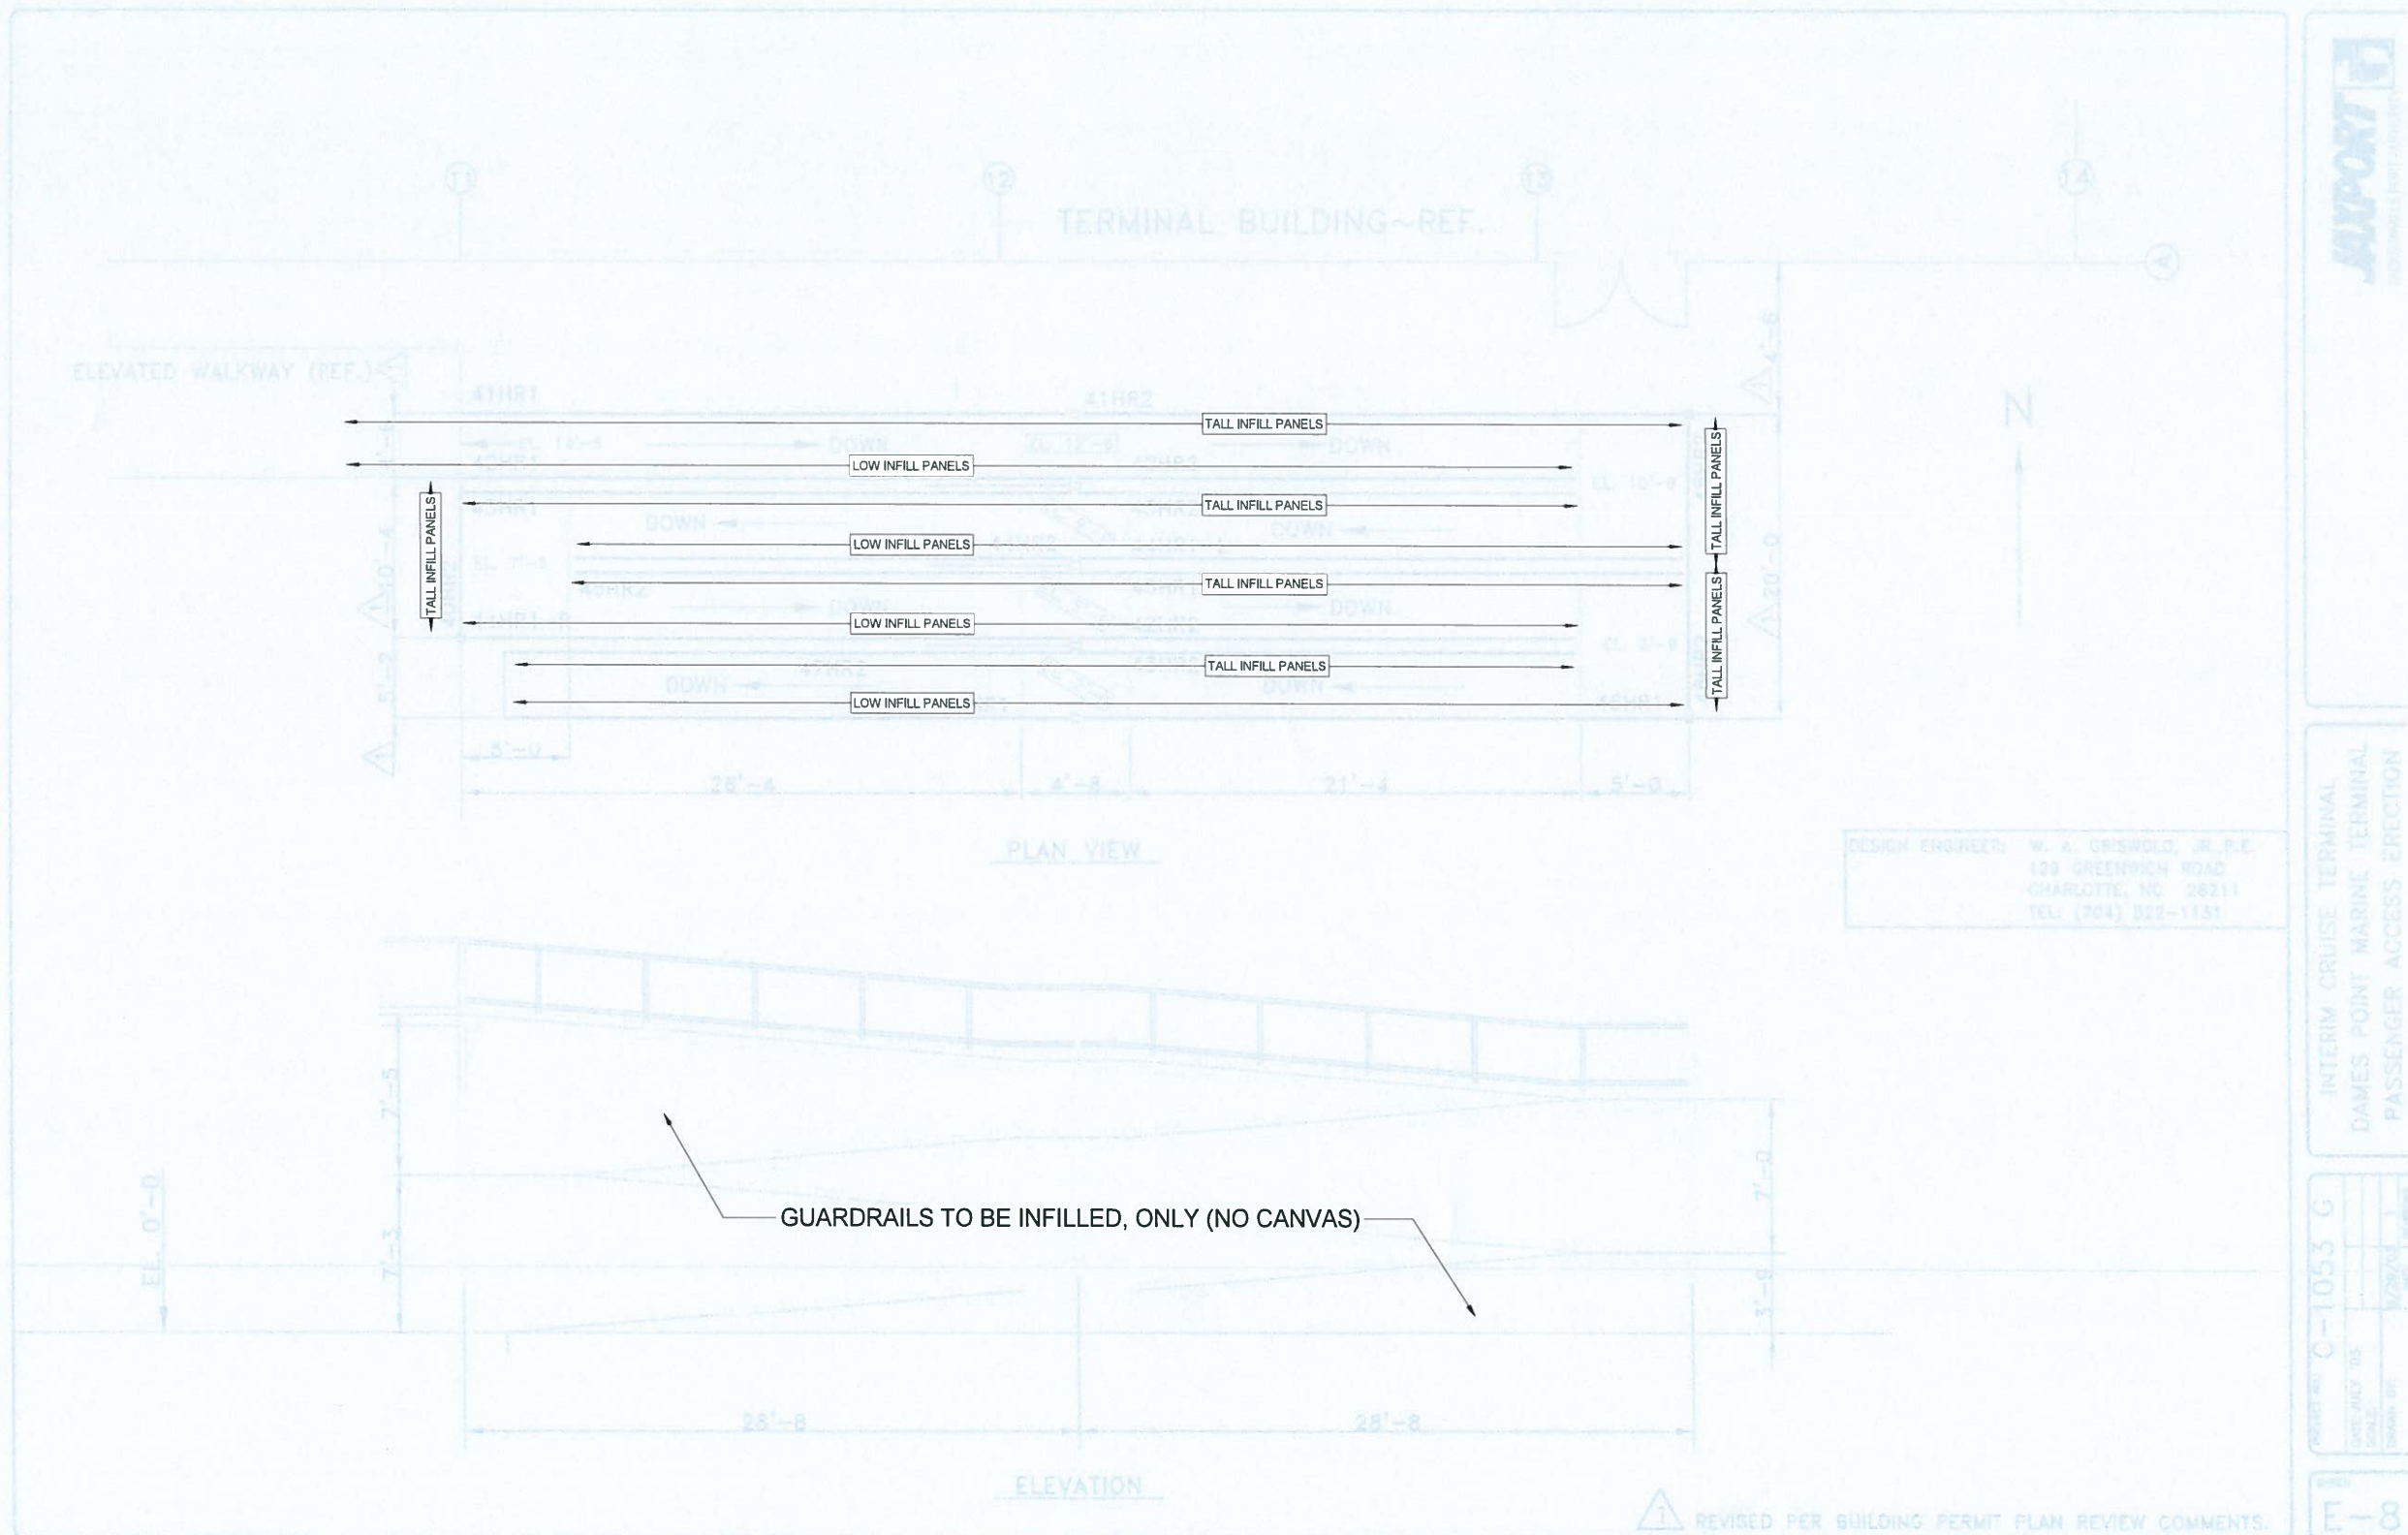

EXIST SHEET E-8
SCALE: NTS

NOTE:

NOTE: THIS SHEET IS A DUPLICATION OF ORIGINAL CONSTRUCTION DOCUMENTS, AND IS BEING PROVIDED FOR INFORMATION, ONLY. FIELD VERIFY AS BUILT CONDITIONS.



Engineer of Record:
Richard E. Peters
P.E. No. 33996

RS&H, Inc.
10748 Deerwood Park Blvd. South
Jacksonville, Florida 32256-0597
904-256-2500 Fax 904-256-2503
www.rsandh.com
FL Cert. Nos. AAC001886 * IB26000956 *
6620 * LCC000210 * GB238



**JAXPORT CRUISE
TERMINAL GANGWAY**

CONSULTANTS

AS-BUILT

TO THE BEST OF OUR KNOWLEDGE
THESE DRAWINGS REPRESENT THE
AS CONSTRUCTED CONDITIONS OF
THIS PROJECT.

ACON CONSTRUCTION CO., INC.

REVISIONS

NO.	DESCRIPTION	DATE

DATE ISSUED: 8/16/18

REVIEWED BY: REP

DRAWN BY: PFM

DESIGNED BY: DMH

RS&H PROJECT NO.

101-0003-027

© 2017 RS&H, INC.

SHEET TITLE

**REFERENCE
DRAWING-6**

SHEET NUMBER

S806

**CONSTRUCTION
DOCUMENTS**

EXIST SHEET E-9

SCALE NTS

NOTE:
THIS SHEET IS A DUPLICATION OF ORIGINAL COSTRUCTION DOCUMENTS, AND IS
BEING PROVIDED FOR INFORMATION, ONLY. FIELD VERIFY AS BUILT CONDITIONS.



PROJECT NOTES

1. WHERE FOOTERS OR FOUNDATIONS ARE INSTALLED BY AUGERING OR DRILLING, SURVEY AND STAKE OR PAINT TO AN ACCURACY OF 0.1' PRIOR TO REQUESTING UTILITY LOCATES. STAKE OR PAINT THE CENTER OF EACH LOCATION AND CLEARLY LABEL WITH STATION, OFFSET, IDENTIFYING STRUCTURE NUMBER, AND DIAMETER OF EXCAVATION IN INCHES.
2. WHERE AUGERING OR DRILLING, EXCAVATE THE FIRST 4 FEET BY NON MECHANICAL AND NON DESTRUCTIVE MEANS.

INDEX OF ELECTRICAL PLANS

SHEET NO.	SHEET DESCRIPTION
E-1	KEY SHEET, PROJECT NOTES, AND LEGEND DESCRIPTION
E-2	ELECTRICAL SITE PLAN
E-3	ONE-LINE DIAGRAM, ELEC. ROOM LAYOUTS, AND PANEL SCHEDULE
E-4	GANGWAY CONDUIT ROUTING ELEVATION DETAILS
E-5	ELECTRICAL SPECIFICATIONS
E-6	ELECTRICAL SPECIFICATIONS

LEGEND DESCRIPTION

PLAN SYMBOLS

	SURFACE MOUNTED CONDUIT WITHIN OPEN CEILING, AS INDICATED ON DRAWINGS.
	(1)-1\"/>
	(1)-2\"/>
	RECESSED IN-GRADE PRECAST PULL BOX (HANDHOLE) FOR FUTURE UNDERGROUND TELECOMMUNICATIONS AND WITH THE FOLLOWING NOMINAL INSIDE DIMENSIONS: 13\"/>
	RECESSED IN-GRADE PRECAST PULL BOX FOR UNDERGROUND ELECTRIC AND WITH THE FOLLOWING NOMINAL INSIDE DIMENSIONS: 24\"/>
	ACCESSIBLE JUNCTION BOX
	CONDUIT RISER (STUB-UP) AND UNDERGROUND TRANSITION.
	ELECTRIC MOTOR (FURNISHED BY OTHERS)
	HOMERUN CIRCUIT, NUMBER REPRESENTS CIRCUIT DESIGNATION, LETTERS REPRESENT PANEL SOURCE.
	SINGLE-POINT TERMINATION TO FURNISHED EQUIPMENT.
	SURFACE MOUNTED FUSED DISCONNECT
	DETAIL CALLOUT

ONE-LINE SYMBOLS

	TRANSFORMER
	PANELBOARD / LOAD CENTER
	CIRCUIT BREAKER
	FUSED DISCONNECT, SIZES AS INDICATED ON DRAWINGS
	KILOWATT DEMAND METER
	ELECTRIC MOTOR
	GENERATOR
	AUTOMATIC TRANSFER SWITCH (ATS)



PROJECT SITE
NOT TO SCALE

AS-BUILT
TO THE BEST OF OUR KNOWLEDGE
THESE DRAWINGS REPRESENT THE
AS CONSTRUCTED CONDITIONS OF
THIS PROJECT.

ACON CONSTRUCTION CO., INC.



REVISIONS				DESIGNED BY:			10748 Deerwood Park Blvd. South Jacksonville, Florida 32256 904-256-2500 Certificate of Authorization No. 5620 Engineer of Record: Stephen Conway, P.E. No.: 53532		DAMES POINT MARINE TERMINAL CRUISE TERMINAL GANGWAY KEY SHEET, PROJECT NOTES, AND LEGEND DESCRIPTION	SHEET	E-1
DESCRIPTION				BY	APVD					DATE	JULY 2018
										CONTRACT NO. C-1575A	

\$USERS

\$DATES

\$TIMES

\$FILES

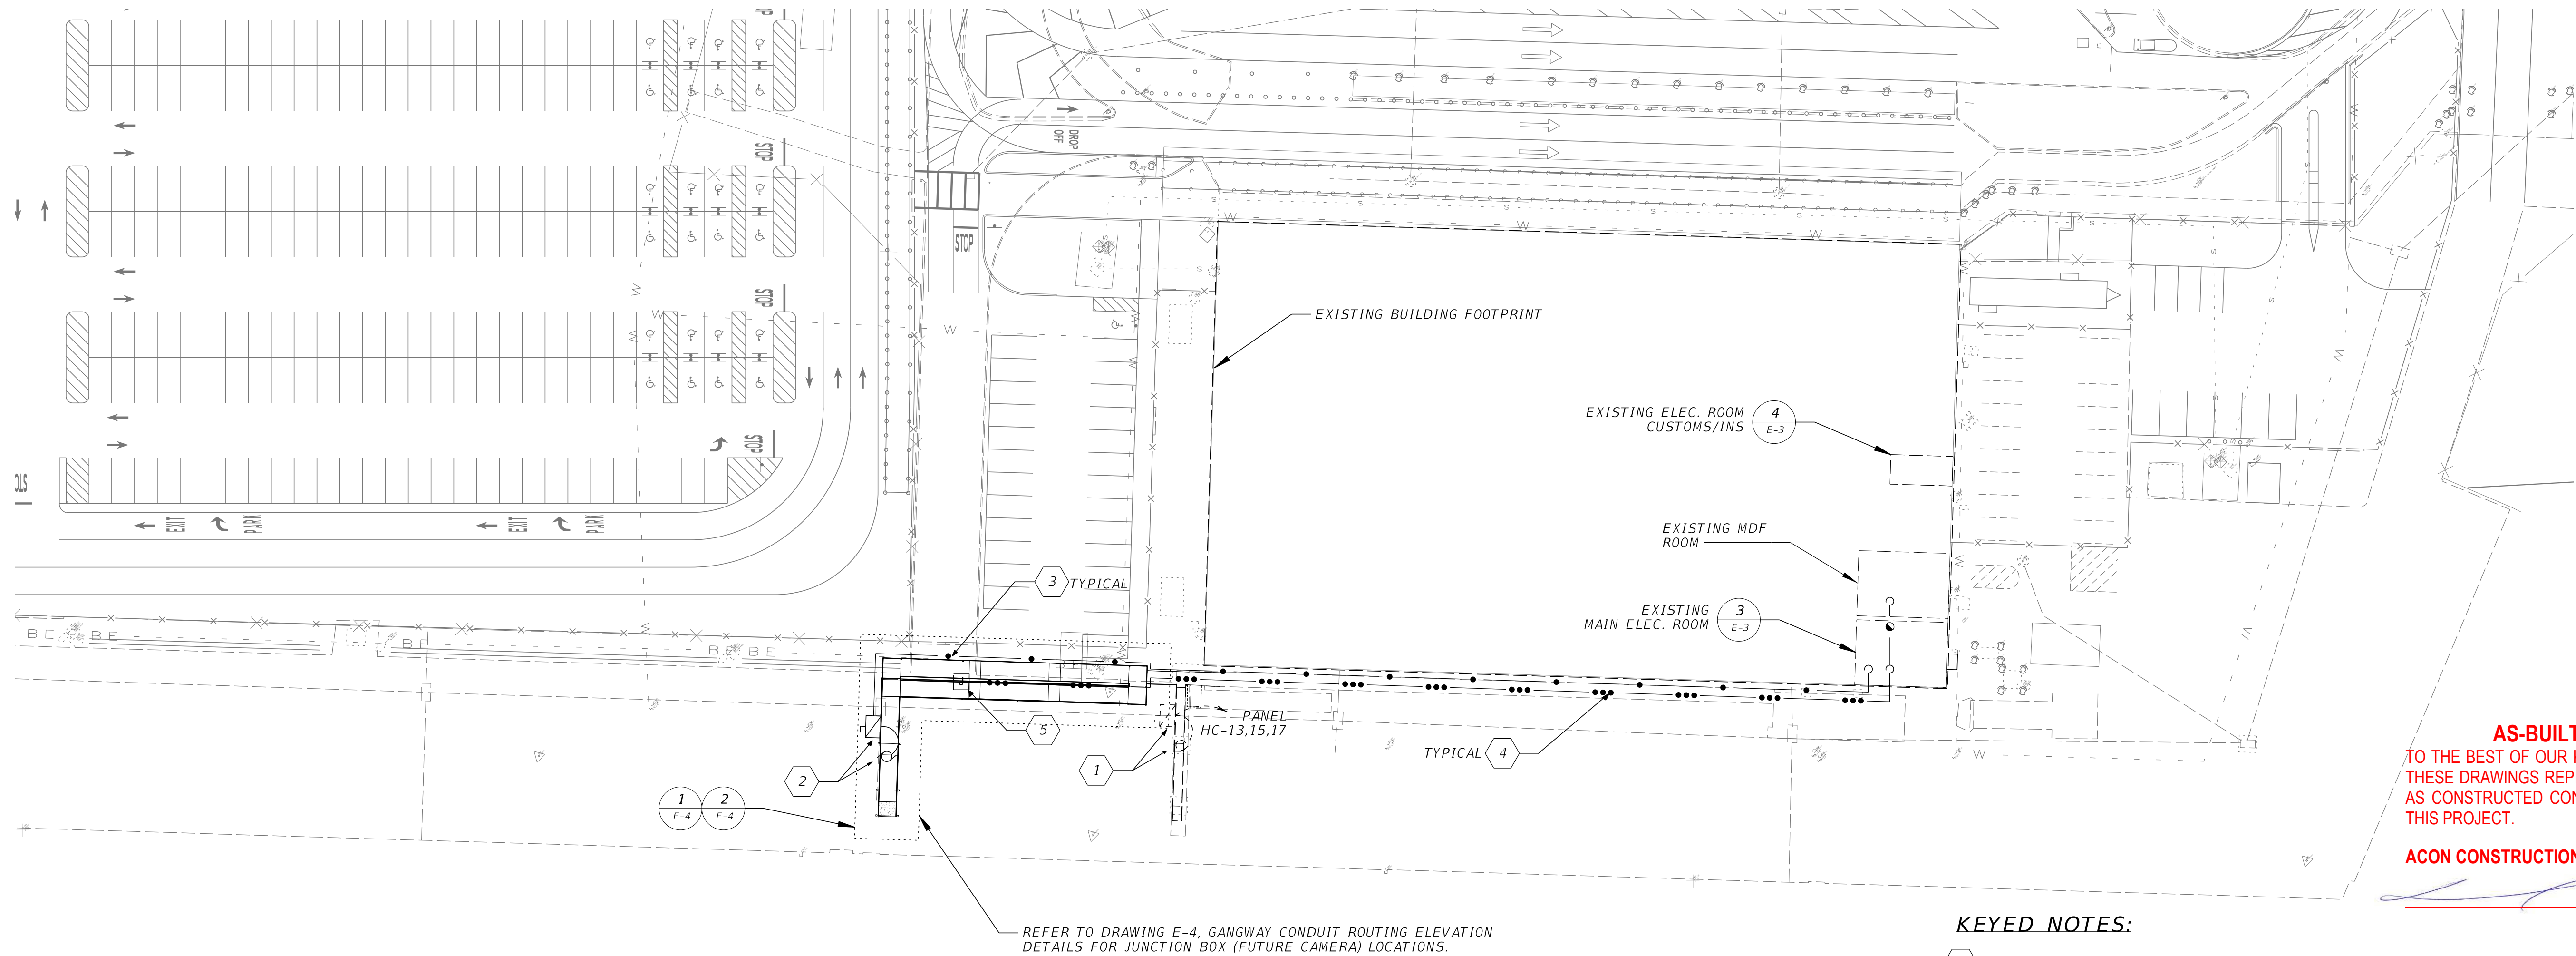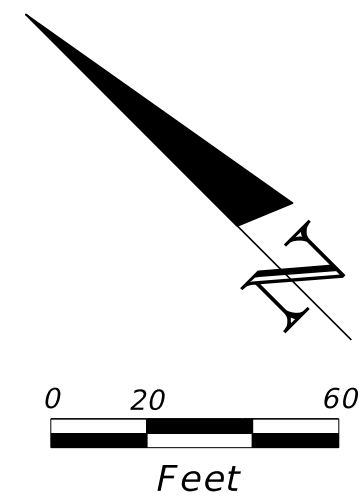

AS-BUILT
TO THE BEST OF OUR KNOWLEDGE
THESE DRAWINGS REPRESENT THE
AS CONSTRUCTED CONDITIONS OF
THIS PROJECT.

ACON CONSTRUCTION CO., INC.

KEYED NOTES:

- 1 DISCONNECT EXISTING JIB CRANE/CHAIN HOIST. DE-ENERGIZE EXISTING CIRCUIT AND REMOVE CONDUCTORS BACK TO SOURCE. REFER TO EXISTING MAIN ELECTRICAL ROOM, DETAIL 3/E-3 FOR SOURCE LOCATION AND DETAIL 2/E-3 FOR EXISTING PANEL SCHEDULE.
- 2 PROPOSED NEW CHAIN HOIST MOTOR AND ASSOCIATED CONTROLS, FURNISHED BY OTHERS AND INSTALLED BY ELECTRICAL CONTRACTOR. COORDINATE EXACT LOCATION WITH STRUCTURAL DRAWINGS, PRIOR TO COMMENCEMENT OF WORK.
- 3 PROVIDE SURFACE MOUNTED RIGID GALVANIZED METAL CONDUIT TO EXISTING AND NEW GANGWAY FOR NEW CHAIN HOIST MOTOR. REFER TO EXISTING PANEL SCHEDULE, DETAIL 2/E-3 FOR CONDUIT AND CONDUCTOR SIZES.
- 4 PROVIDE 2" SURFACE MOUNTED RIGID GALVANIZED METAL CONDUIT WITH PULL CORD TO EXISTING AND NEW GANGWAY FOR FUTURE CAMERAS. PROPOSED CONDUIT ROUTING IS SHOWN ON DRAWING E-4, GANGWAY CONDUIT ROUTING ELEVATION. ROUTING INDICATED IS FOR ILLUSTRATION PURPOSES. COORDINATE EXACT PATHWAY AND ROUTING WITH BEST PRACTICES OF MEANS AND METHODS.
- 5 PROVIDE SURFACE MOUNTED 6"x12"x4" GALVANIZED METAL JUNCTION BOX TO NEW GANGWAY FOR PROPOSED CAMERA(S). QUANTITIES AND LOCATIONS ARE DEFINED ON DRAWING E-4, GANGWAY CONDUIT ROUTING ELEVATION.


REVISIONS				DESIGNED BY: DAO	RS&H 10748 Deerwood Park Blvd. South Jacksonville, Florida 32256 904-256-2500 Certificate of Authorization No. 5620 Engineer of Record: Stephen Conway, P.E. No.: 53532 JAXPORT JACKSONVILLE PORT AUTHORITY	DAMES POINT MARINE TERMINAL CRUISE TERMINAL GANGWAY ELECTRICAL SITE PLAN	SHEET	E-2
DESCRIPTION		BY	APVD				DATE	JULY 2018
				CHECKED BY: SJC			CONTRACT NO.	
				APPROVED BY: JDC			C-1575A	

\$USERS

\$DATES

\$TIMES

\$FILES

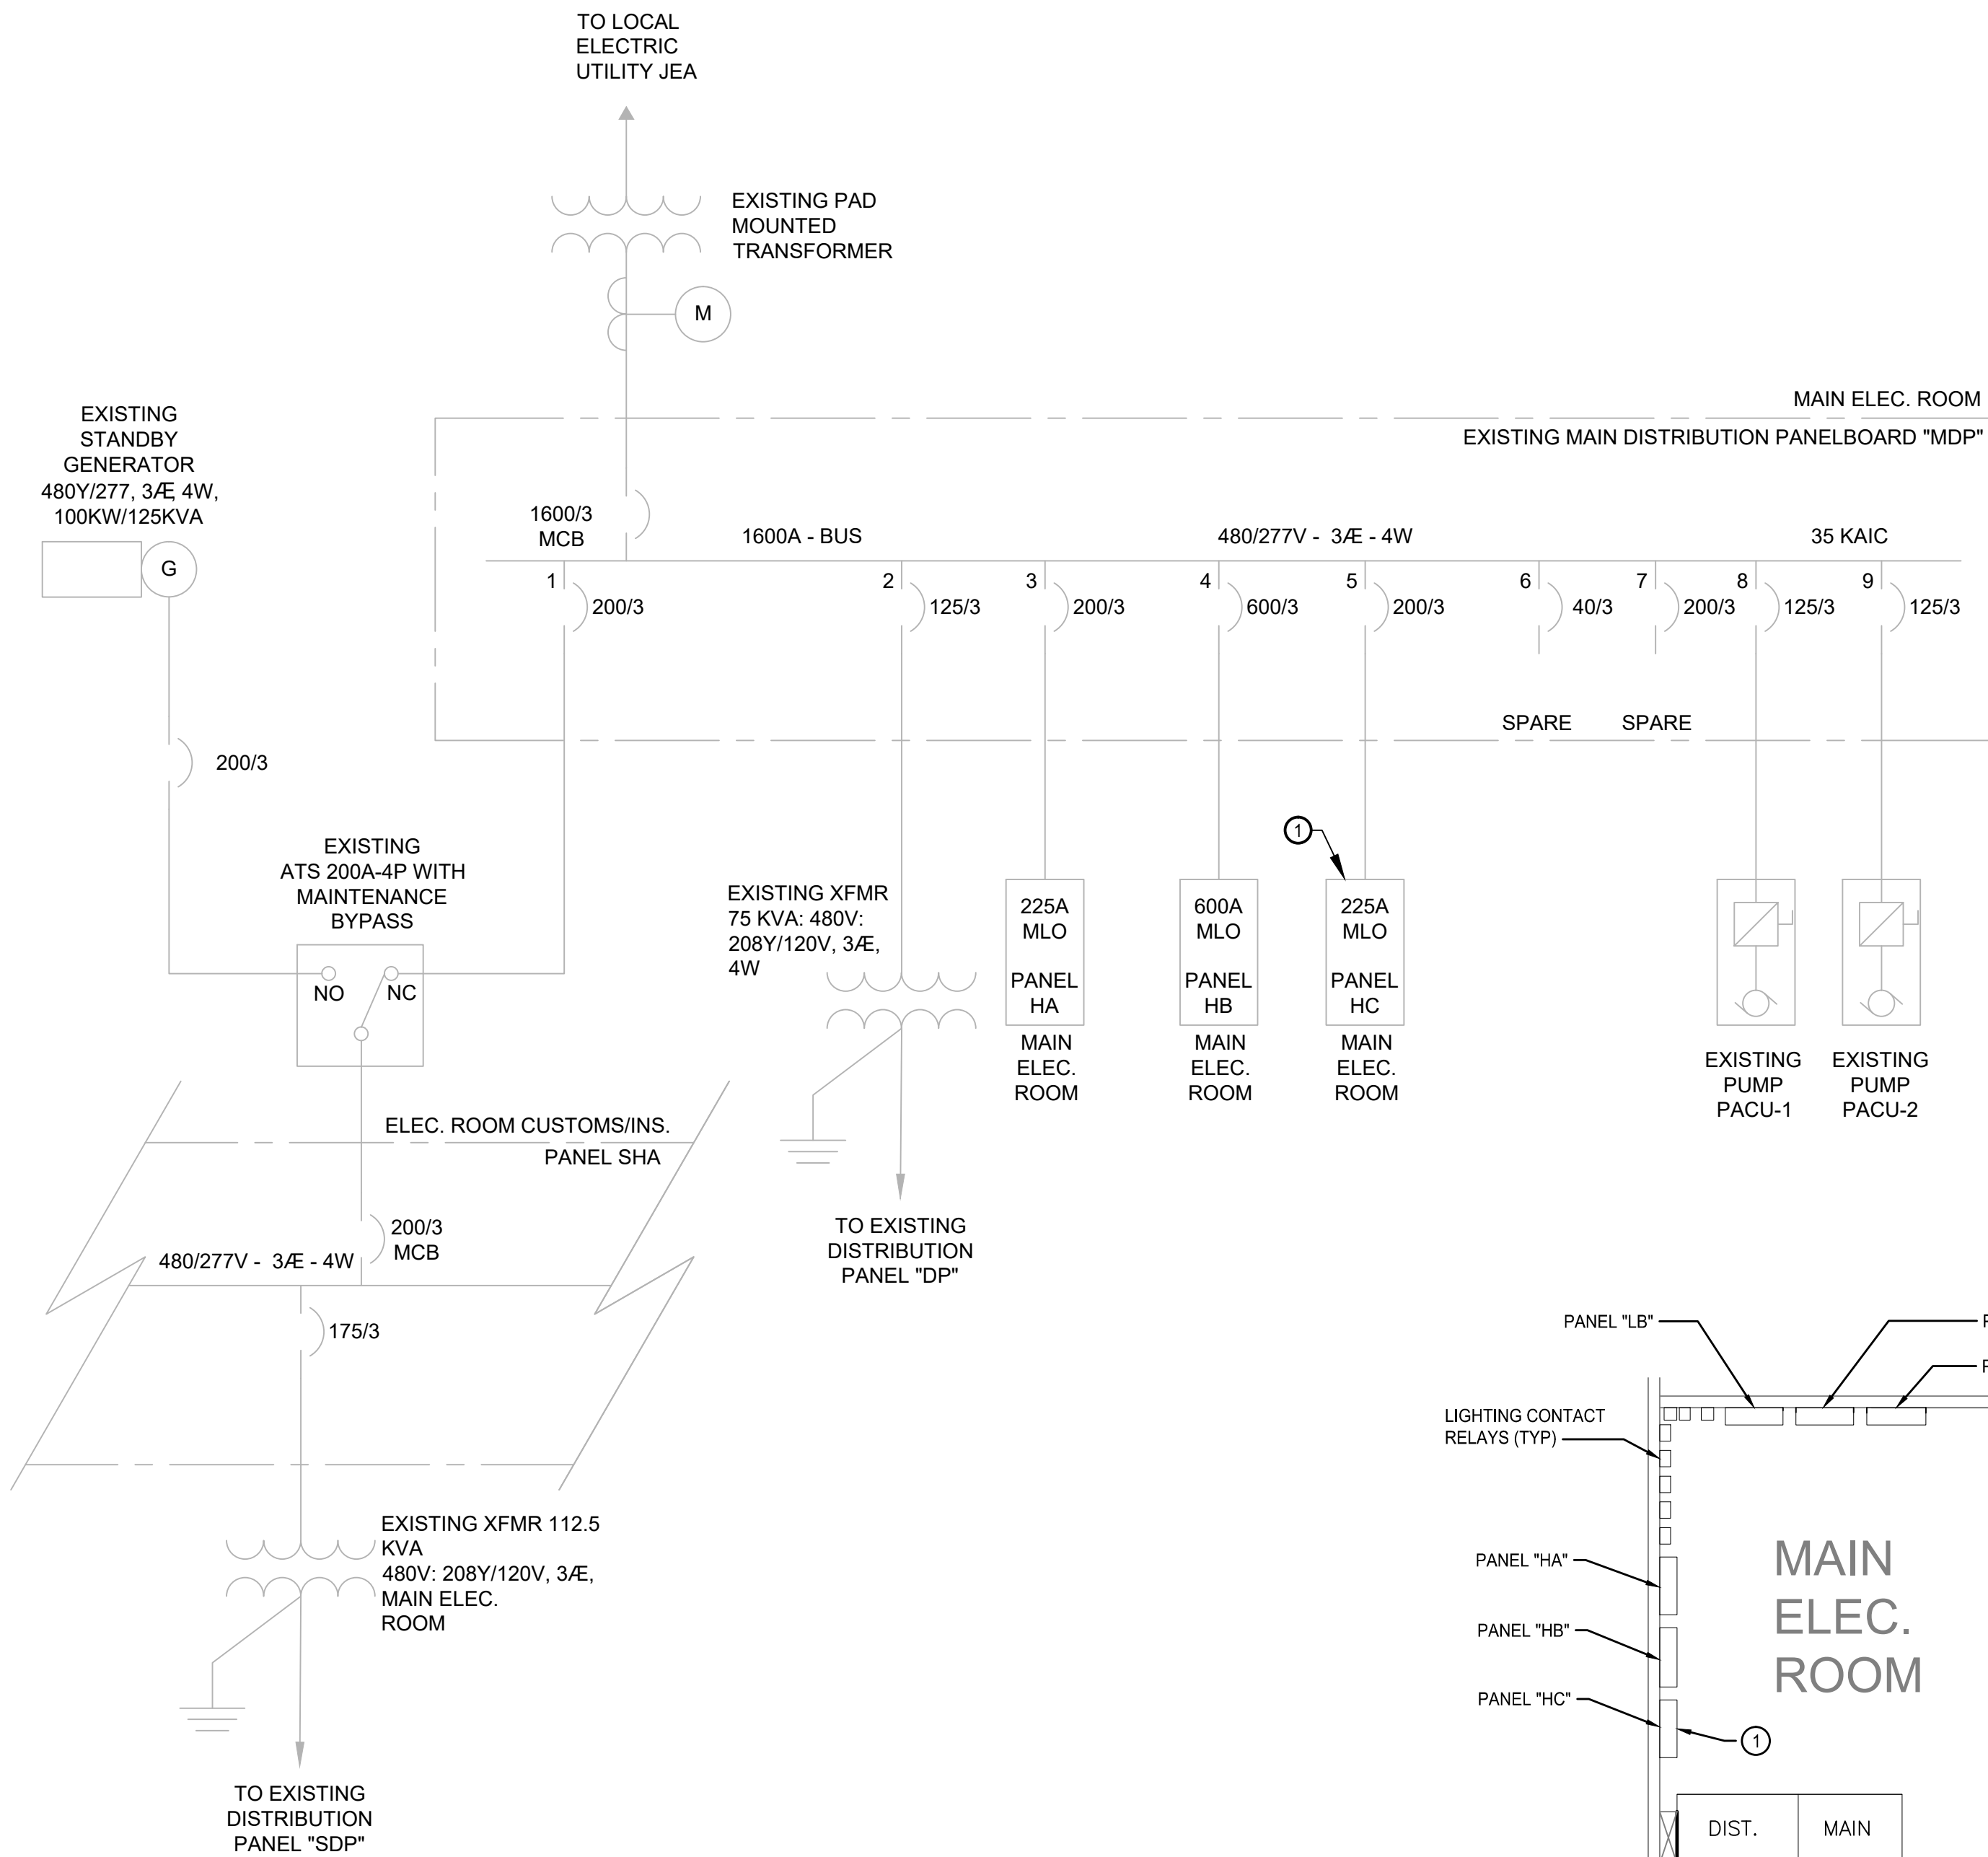


1 **PARTIAL ONE-LINE DIAGRAM-EXISTING BUILDING**
E-3 SCALE: NONE

3 **MAIN ELEC. ROOM-EXISTING LAYOUT**
E-3 SCALE: 1/4"=1'-0"

GRAPHIC SCALE

SCALE: 1/4"= 1'-0"

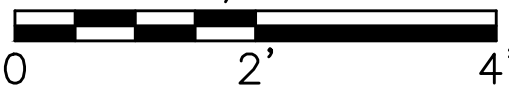

LOCATION: MAIN ELEC. ROOM
277/480Y VOLTS,
3 PHASE, 4 WIRE


EXISTING PANEL 'HC'

AIC: 22,000
SURFACE MOUNTED, NEMA 1
225 AMP, MAIN CIRCUIT BREAKER

CKT	POLES	TRIP	WIRE	GND	COND	KVA	SERVES	CKT	POLES	TRIP	WIRE	GND	COND	KVA	SERVES
1								2							
3	3	30	3#10	#10	1"	7.47	EF-8, EF-9, EF-10	4	3	40	3#6	#6	1"	15.8	AHU-1
5								6							
7								8							
9	3	30	3#10	#10	1"	7.47	EF-5, EF-6, EF-7	10	3	40	3#6	#6	1"	15.8	CU-1
11								12							
13								14							
15	3	30	3#8	#8	1"	11.6	CHAIN HOIST(10 HP)-GANGWAY	16	3	30	3#10	#10	1"	14.1	FORK LIFT
17								18							
19								20							
21	3	30	3#10	#10	1"	14.1	FORK LIFT	22	3	30	3#10	#10	1"	14.1	FORK LIFT
23								24							
25								26							
27	3	30	3#10	#10	1"	14.1	FORK LIFT	28	2	20	2#10	#10	3/4"	1.55	DOCK LIGHTING (SCOUT)
29								30							
31	2	20	2#10	#10	3/4"	1.55	DOCK LIGHTING (5-6)	32	2	20	2#10	#10	3/4"	1.55	DOCK LIGHTING (WALK)
33								34	2	20	2#10	#10	3/4"	1.55	DOCK LIGHTING (1-2)
35	2	20	2#10	#10	3/4"	2.50	CANOPY-WALKWAY LTS & FANS	36							
37								38	2	20	2#10	#10	3/4"	1.55	DOCK LIGHTING (3-4)
39								40							
41								42							

TOTAL CONNECTED LOAD: 126.3 KVA (152.2A)

2 **PANELBOARD SCHEDULE**
E-3 SCALE: NONE

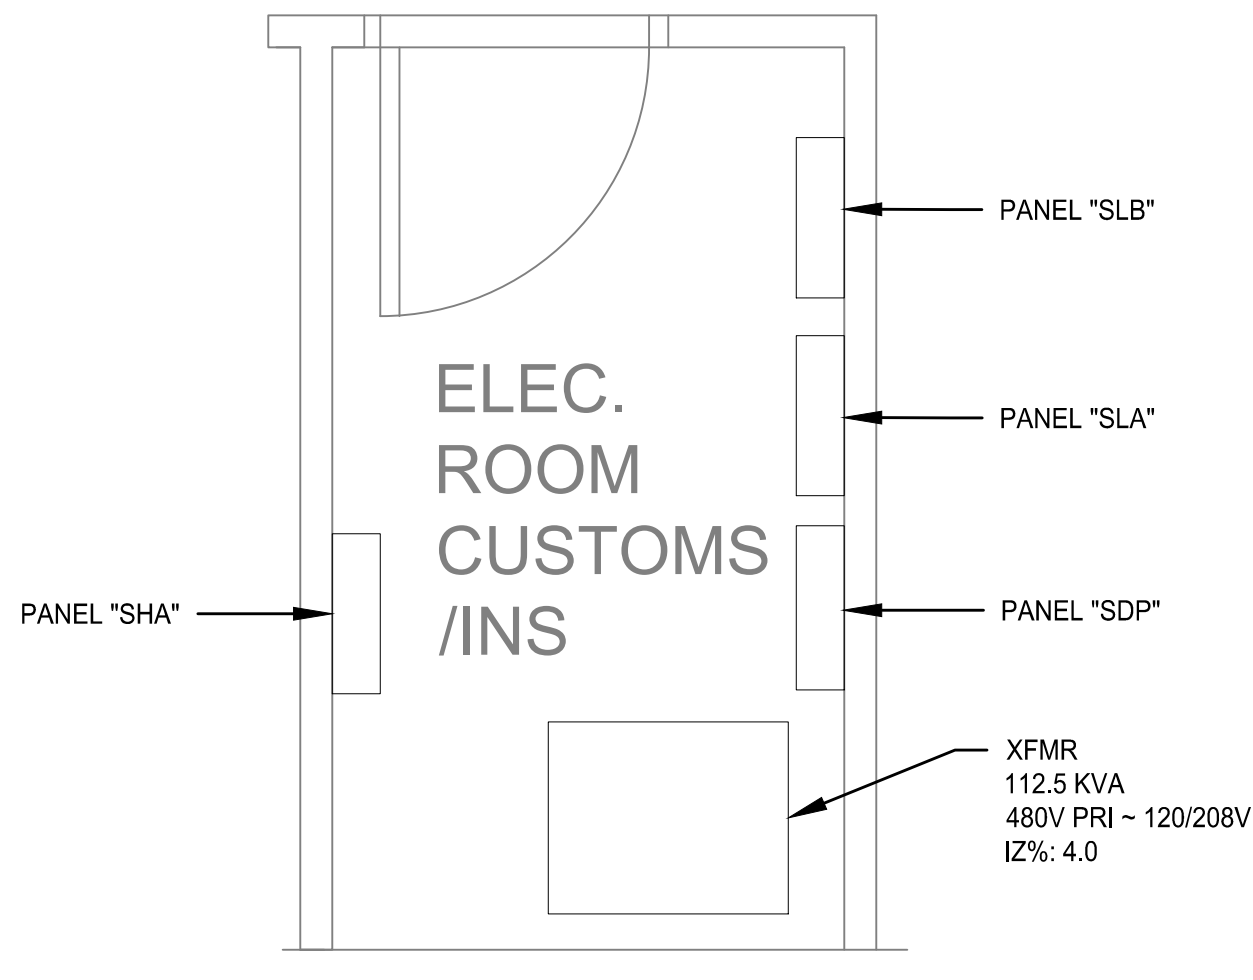


AS-BUILT
TO THE BEST OF OUR KNOWLEDGE
THESE DRAWINGS REPRESENT THE
AS CONSTRUCTED CONDITIONS OF
THIS PROJECT.

ACON CONSTRUCTION CO., INC.


4 **ELEC. ROOM-CUSTOM/INS-EXISTING LAYOUT**
E-3 SCALE: 1/2"=1'-0"

GRAPHIC SCALE


SCALE: 1/2"= 1'-0"

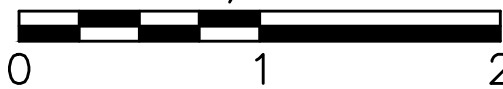

REVISIONS				DESIGNED BY:	RS&H	10748 Deerwood Park Blvd. South Jacksonville, Florida 32256 904-256-2500 Certificate of Authorization No. 5620 Engineer of Record: Stephen Conway, P.E. No.: 53532	JAXPORT JACKSONVILLE PORT AUTHORITY	DAMES POINT MARINE TERMINAL CRUISE TERMINAL GANGWAY ONE-LINE DIAGRAM, ELEC. ROOM LAYOUTS, AND PANEL SCHEDULE	SHEET	E-3
DESCRIPTION				DRAWN BY:					DATE	JULY 2018
				CHECKED BY:					CONTRACT NO. C-1575A	
				APPROVED BY:						

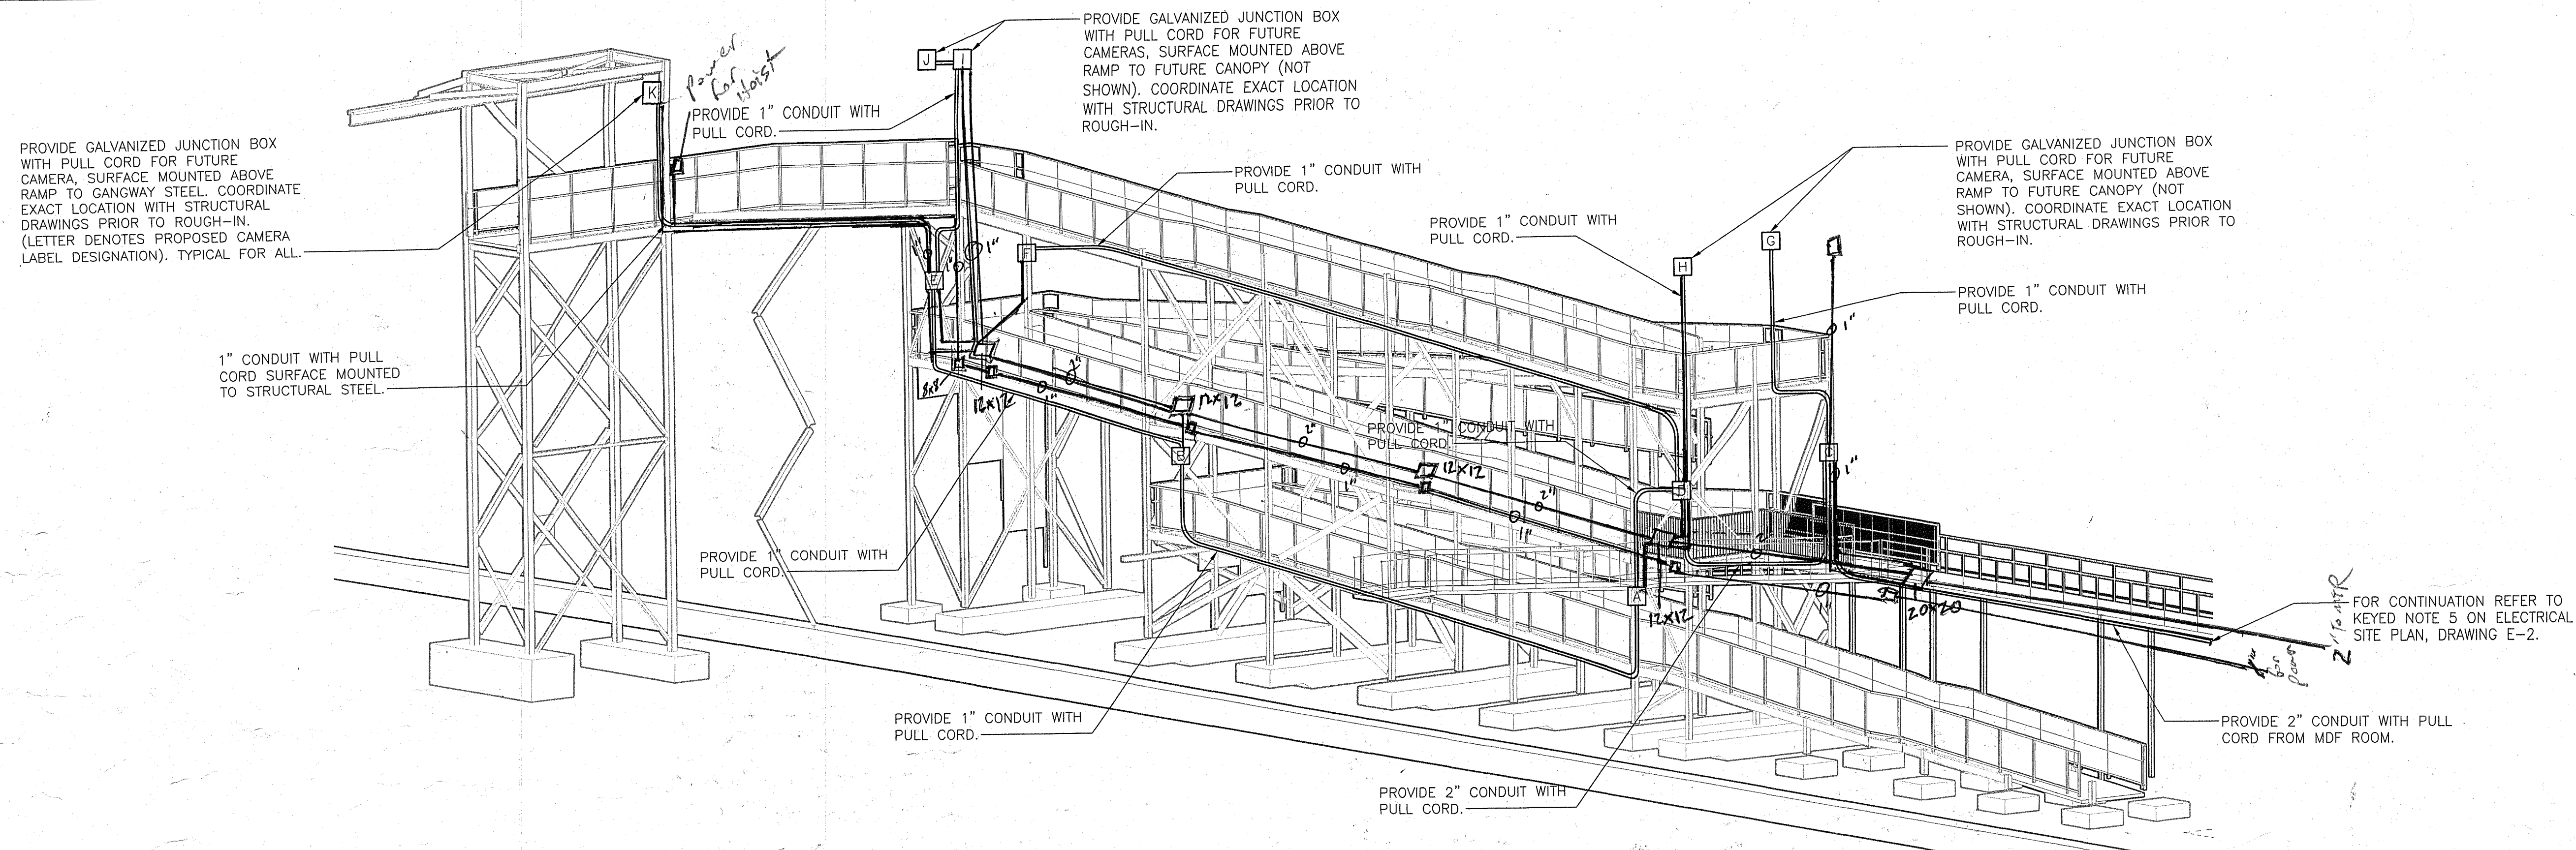

1 **GANGWAY CONDUIT ROUTING - NORTHWEST ELEVATION**
E-4 SCALE: NONE

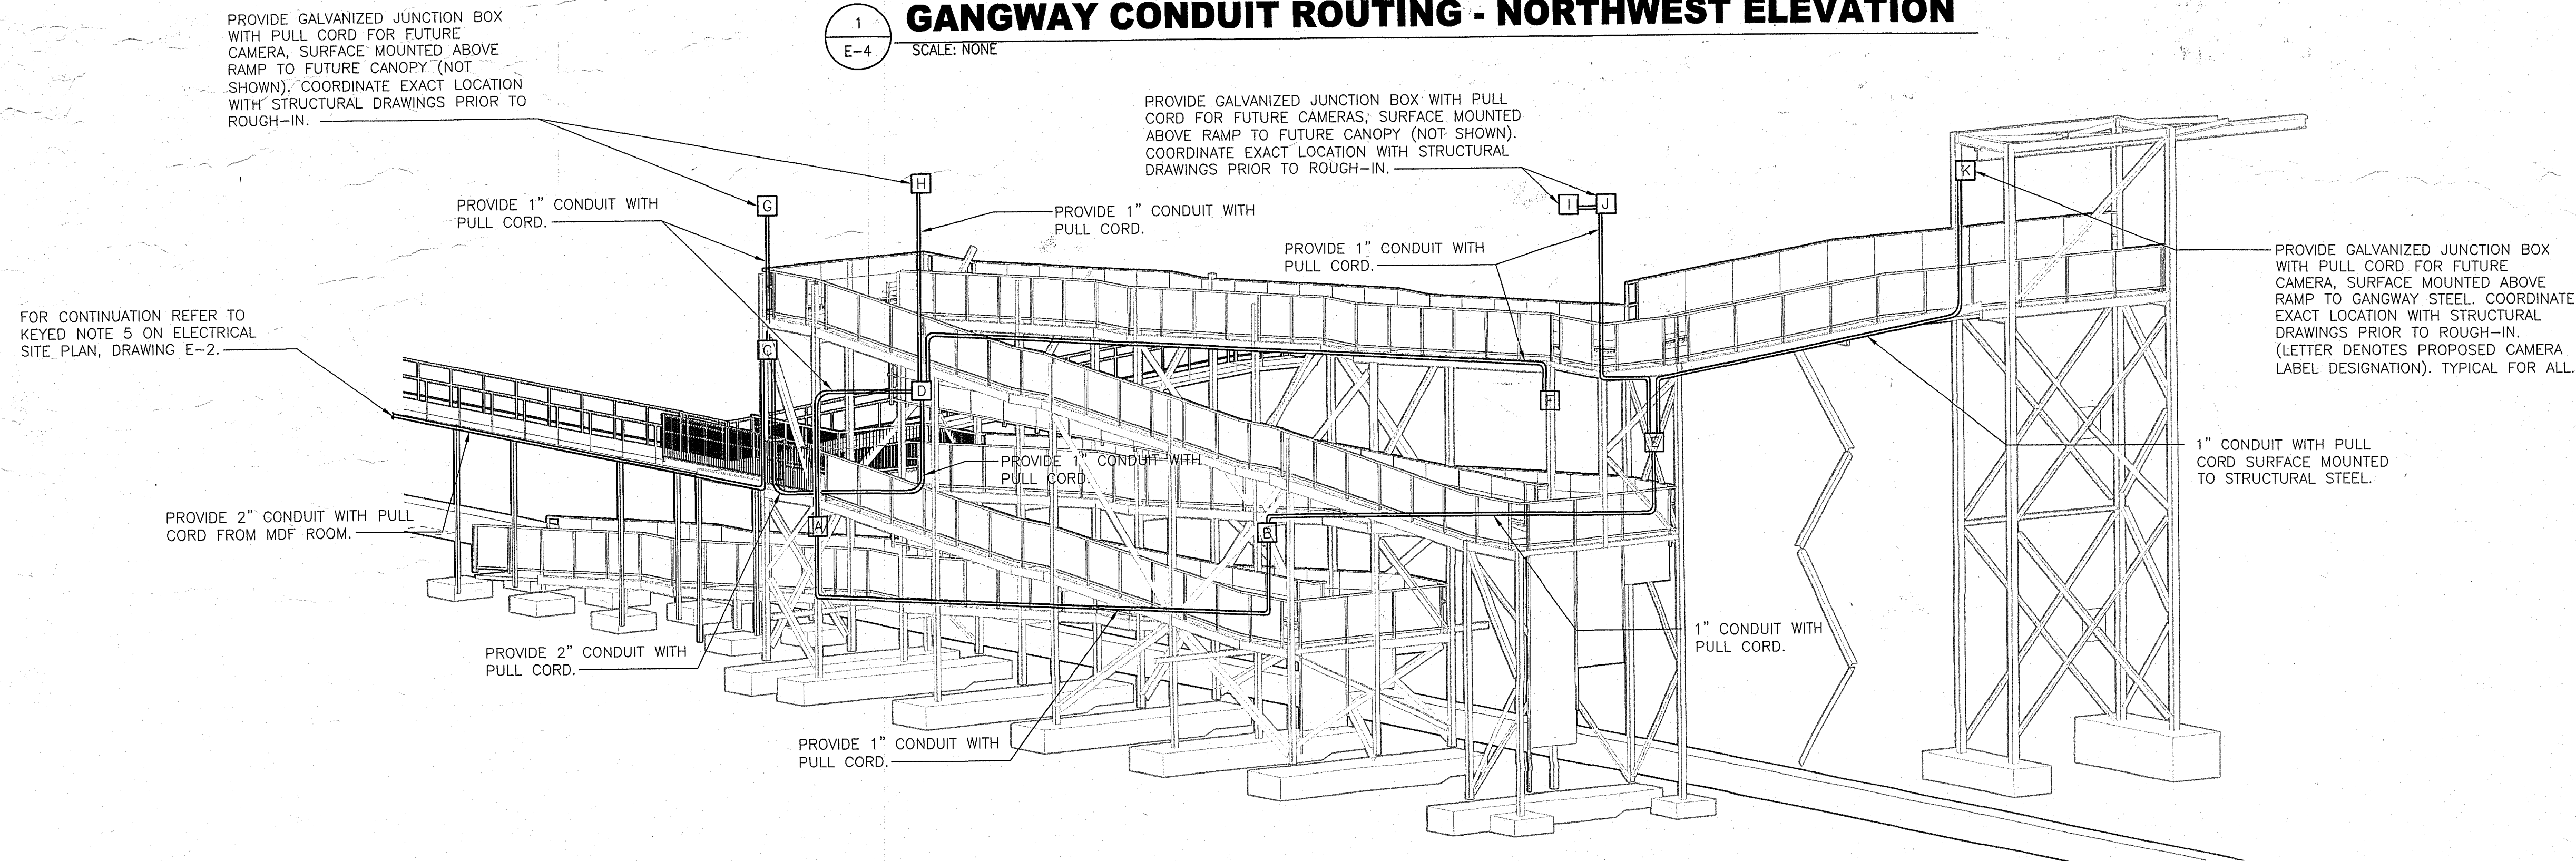

2 **GANGWAY CONDUIT ROUTING - SOUTHEAST ELEVATION**
E-4 SCALE: NONE

AS-BUILT
TO THE BEST OF OUR KNOWLEDGE
THESE DRAWINGS REPRESENT THE
AS CONSTRUCTED CONDITIONS OF
THIS PROJECT.
ACON CONSTRUCTION CO., INC.

REVISIONS				DESIGNED BY:		DRAWN BY:		CHECKED BY:		APPROVED BY:		DATE		CONTRACT NO.	
DESCRIPTION				BY	APVD	DAO	CDM	SJC	JDC						

10748 Deerwood Park Blvd. South
Jacksonville, Florida 32256
904-256-2500
Certificate of Authorization No. 5620
Engineer of Record: Stephen Conway, P.E. No.: 53532

JACKSONVILLE PORT AUTHORITY

**DAMES POINT MARINE TERMINAL
CRUISE TERMINAL GANGWAY
GANGWAY CONDUIT ROUTING
ELEVATION DETAILS**

SHEET **E-4**
DATE **JULY 2018**
CONTRACT NO. **C-1575A**

MillerBE

7/10/2018

2:17:31 PM

\\JAXFILE01\Transportation\N\1010003027 - DPMT Cruise Term

BASIC ELECTRICAL MATERIALS AND METHODS

PART 1 – GENERAL

1.1 SUMMARY

A. DIVSION 26 OF THE SPECIFICATIONS COVERS ALL ELECTRICAL WORK FOR THE PROJECT. WORK SHALL INCLUDE LABOR, MATERIAL, AND ACCESSORIES REQUIRED TO ACCOMPLISH THE WORK.

1.2 SUBMITTALS

A. SHOP DRAWINGS AND PRODUCT DATA:

1. SHOP DRAWINGS SHALL BE SUBMITTED AS INDICATED UNDER EACH SECTION. PROVIDE DIMENSIONED PLANS AND SECTIONS OR ELEVATION LAYOUTS. INCLUDE SUFFICIENT INFORMATION TO INDICATE COMPLETE COMPLIANCE WITH THE SPECIFICATIONS.
2. PRODUCT DATA: SHALL INCLUDE ILLUSTRATIONS, CATALOG SHEETS, INSTALLATION INSTRUCTIONS, DRAWINGS, AND CERTIFICATIONS AS NECESSARY. EACH SHEET SHALL SHOW MANUFACTURER'S NAME OR TRADEMARK.
3. AT THE TIME OF EACH SUBMISSION, ANY DEVIATIONS FROM THE CONTRACT DOCUMENTS SHALL BE CALLED TO THE ATTENTION OF THE OWNER IN WRITING, AND BE PLAINLY MARKED ON THE SHOP DRAWINGS AND PRODUCT DATA.
4. WHERE CATALOG SHEETS SUBMITTED INCLUDE MULTIPLE PRODUCTS NOT DIRECTLY ASSOCIATED WITH THE SPECIFIED PROJECT, THE PRODUCTS SOLELY PERTAINING TO THE SPECIFIED PROJECT SHALL BE PLAINLY MARKED.

B. RECORD DRAWINGS:

1. PROVIDE ONE COMPLETE SET OF CONTRACT DRAWINGS IN CLEAN, UNDAMAGED CONDITION, INDICATING ALL SIGNIFICANT CHANGES FROM THE WORK AS SHOWN. USE MULTIPLE PENCIL COLORS TO AID IN THE DISTINCTION BETWEEN WORK OF SEPARATE ELECTRICAL SYSTEMS. IN GENERAL, RECORD EVERY SUBSTANTIVE INSTALLATION OF ELECTRICAL WORK WHICH PREVIOUSLY IS EITHER NOT SHOWN OR FIELD MODIFIED.
- a. SHOW EXACT LOCATIONS OF UNDERGROUND CABLE AND CONDUITS INCLUDING PULL BOXES AND HANDHOLES, BOTH INTERIOR AND EXTERIOR, DRAWN TO SCALE AND FULLY DIMENSIONED FROM BUILDING COLUMN LINES.
- b. INDICATE MAINS AND BRANCHES OF WIRING SYSTEMS, WITH PANELBOARDS AND CONTROL DEVICES LOCATED AND NUMBERED. LOCATE DEVICES REQUIRING MAINTENANCE.

1.3 CODES, PERMITS AND INSPECTIONS

A. INSTALLATION SHALL COMPLY WITH ALL LAWS APPLYING TO ELECTRICAL INSTALLATION IN EFFECT, WITH THE REGULATIONS OF THE INTERNATIONAL BUILDING CODE (IBC), NATIONAL ELECTRICAL SAFETY CODE, NATIONAL ELECTRICAL CODE (NEC, NFPA-70), OTHER APPLICABLE PUBLICATIONS OF THE NATIONAL FIRE PROTECTION ASSOCIATION, ALL LOCAL GOVERNING CODES AND ORDINANCES AND WITH THE REGULATIONS OF THE SERVING UTILITY COMPANY. PROVIDE REQUIRED PERMITS.

1.4 DEFINITIONS

- A. EMT: ELECTRICAL METALLIC TUBING.
- B. FMC: FLEXIBLE METAL CONDUIT.
- C. IMC: INTERMEDIATE METAL CONDUIT.
- D. LFMC: LIQUDTIGHT FLEXIBLE METAL CONDUIT.
- E. RGS: GALVANIZED RIGID STEEL CONDUIT.

1.5 QUALITY ASSURANCE

A. ELECTRICAL COMPONENTS, DEVICES, AND ACCESSORIES: LISTED AND LABELED AS DEFINED IN NFPA 70, ARTICLE 100, BY A TESTING AGENCY ACCEPTABLE TO AUTHORITIES HAVING JURISDICTION, AND MARKED FOR INTENDED USE.

B. COMPLY WITH NFPA 70.

C. MANUFACTURERS' NAMES AND CATALOG NUMBERS

1. IN SOME INSTANCES, SPECIFIC REFERENCES HAVE BEEN MADE TO ONE OR MORE MANUFACTURER'S NAMES AND MODEL OR CATALOG NUMBERS. USE OF NAMES AND CATALOG NUMBERS DOES NOT INDICATE THAT THE EQUIPMENT SPECIFIED IS NECESSARILY AN "OFF THE SHELF" ITEM. VARIANCES MAY BE DUE TO REQUIREMENT OF A DESIRED FINISH, MATERIAL, OR OTHER MODIFICATION.

2. IN THE CASE OF PANELBOARDS, SAFETY SWITCHES AND OTHER EQUIPMENT REQUIRING WIRE AND CABLE TERMINATIONS, ASCERTAIN THAT LUG SIZES AND WIRING GUITERS OR SPACE ALLOWED FOR PROPER ACCOMMODATION AND TERMINATION OF THE WIRES AND CABLES ARE ADEQUATE.

D. DRAWINGS ARE DIAGRAMMATIC AND INDICATE THE GENERAL ARRAGEMENT OF SYSTEMS AND WORK. EXACT LOCATIONS ARE SUBJECT TO APPROVAL BY OWNER, WHO RESERVES THE RIGHT TO MAKE REASONABLE CHANGES IN THE LOCATION INDICATED WITHOUT CHANGE IN CONTRACT AMOUNT.

1.6 COORDINATION

A. COORDINATE CHASES, SLOTS, INSERTS, SLEEVES, AND OPENINGS WITH GENERAL CONSTRUCTION WORK AND ARRANGE IN BUILDING STRUCTURE DURING PROGRESS OF CONSTRUCTION TO FACILITATE THE ELECTRICAL INSTALLATIONS THAT FOLLOW.

B. SEQUENCE, COORDINATE, AND INTEGRATE INSTALLING ELECTRICAL MATERIALS AND EQUIPMENT FOR EFFICIENT FLOW OF THE WORK. COORDINATE INSTALLATION OF EQUIPMENT WITH OTHER TRADES.

C. COORDINATE ELECTRICAL SERVICE CONNECTIONS TO COMPONENTS FURNISHED BY UTILITY COMPANIES.

1. COORDINATE INSTALLATION AND CONNECTION OF EXTERIOR UNDERGROUND AND OVERHEAD UTILITIES AND SERVICES.

2. COMPLY WITH REQUIREMENTS OF AUTHORITIES HAVING JURISDICTION AND OF UTILITY COMPANY PROVIDING ELECTRICAL POWER AND OTHER SERVICES.

D. WHERE ELECTRICAL IDENTIFICATION DEVICES ARE APPLIED TO FIELD-FINISHED SURFACES, COORDINATE INSTALLATION OF IDENTIFICATION DEVICES WITH COMPLETION OF FINISHED SURFACE.

E. WHERE ELECTRICAL IDENTIFICATION MARKINGS AND DEVICES WILL BE CONCEALED BY ACOUSTICAL CEILINGS AND SIMILAR FINISHES, COORDINATE INSTALLATION OF THESE ITEMS BEFORE CEILING INSTALLATION.

1.7 PROTECTION OF ELECTRICAL EQUIPMENT

- A. ELECTRICAL EQUIPMENT SHALL BE PROTECTED FROM THE WEATHER, IN PARTICULAR, DRIPPING OR SPLASHING WATER, AT ALL TIMES DURING SHIPMENT, STORAGE AND CONSTRUCTION. MANUFACTURER'S RECOMMENDATIONS WITH REGARD TO STORAGE AND PROTECTION SHALL BE FOLLOWED. SHOULD ANY APPARATUS BE SUBJECTED TO POSSIBLE DAMAGE BY WATER, IT SHALL BE THOROUGHLY DRIED AND PUT THROUGH A DIELECTRIC TEST, AT THE EXPENSE OF THE CONTRACTOR, TO ASCERTAIN THE SUITABILITY OF THE APPARATUS OR IT SHALL BE REPLACED WITHOUT ADDITIONAL COST TO THE OWNER.
- B. DAMAGED OR DEFECTIVE EQUIPMENT: INSPECT ALL ELECTRICAL EQUIPMENT AND MATERIALS PRIOR TO INSTALLATION. DAMAGED EQUIPMENT AND MATERIALS SHALL NOT BE INSTALLED OR PLACED IN SERVICE. REPLACE OR REPAIR TO NEW CONDITION AND TEST REPAIRED EQUIPMENT IN COMPLIANCE WITH INDUSTRY STANDARDS AT NO ADDITIONAL COST TO THE OWNER. EQUIPMENT REQUIRED FOR THE TEST SHALL BE PROVIDED BY THE CONTRACTOR.

PART 2 – PRODUCTS

2.1 RACEWAYS

- A. EMT: ANSI C80.3, ZINC-COATED STEEL, WITH SET-SCREW OR COMPRESSION FITTINGS.
- B. FMC: ZINC-COATED STEEL.
- C. IMC: ANSI C80.6, ZINC-COATED STEEL, WITH THREADED FITTINGS.
- D. LFMC: ZINC-COATED STEEL WITH SUNLIGHT-RESISTANT AND MINERAL-OIL-RESISTANT PLASTIC JACKET.

1. MANUFACTURED BY HOFFMAN, SQUARE D, OR APPROVED EQUAL.
2. MATERIAL AND CONSTRUCTION: SHEET METAL SIZED AND SHAPED AS INDICATED, NEMA 3R AND 4X.
3. FITTINGS AND ACCESSORIES: INCLUDE COUPLINGS, OFFSETS, ELBOWS, EXPANSION JOINTS, ADAPTERS, HOLD-DOWN STRAPS, END CAPS, AND OTHER FITINGS TO MATCH AND MATE WITH WIREWAYS AS REQUIRED FOR COMPLETE SYSTEM.
4. SELECT FEATURES, UNLESS OTHERWISE INDICATED, AS REQUIRED TO COMPLETE WIRING SYSTEM AND TO COMPLY WITH NFPA 70.
5. FINISH: MANUFACTURER'S STANDARD ENAMEL FINISH.

E. PVC SCHEDULE 40: POLY (VINYL CHLORIDE), ATSM D 2466

F. RNC: NEMA TC 2, SCHEDULE 40 PVC, WITH NEMA TC3 FITTINGS.

G. RACEWAY FITTINGS: SPECIFICALLY DESIGNED FOR THE RACEWAY TYPE WITH WHICH USED.

2.2 CONDUCTORS

- A. CONDUCTORS, NO. 10 AWG AND SMALLER: SOLID OR STRANDED COPPER.
- B. CONDUCTORS, LARGER THAN NO. 10 AWG: STRANDED COPPER.
- C. INSULATION: 600V, THWN-2
- D. WIRE CONNECTORS AND SPLICES: UNITS OF SIZE, AMPACITY RATING, MATERIAL, TYPE, AND CLASS SUITABLE FOR SERVICE INDICATED.

2.3 BOXES, ENCLOSURES, AND CABINETS

- A. SHEET METAL OUTLET AND DEVICE BOXES: NEMA OS 1.
- B. CAST-METAL OUTLET AND DEVICE BOXES: NEMA FB 1, TYPE FD, WITH GASKETED COVER.
- C. SMALL SHEET METAL PULL AND JUNCTION BOXES: NEMA OS 1.
- D. CAST-METAL PULL AND JUNCTION BOXES: NEMA FB 1, CAST ALUMINUM WITH GASKETED COVER UNLESS OTHERWISE SPECIFIED ON DRAWINGS.
- E. HINGED-COVER ENCLOSURES: NEMA 250, TYPE 4X, WITH CONTINUOUS HINGE COVER AND FLUSH LATCH.
1. METAL ENCLOSURES: STEEL, FINISHED INSIDE AND OUT WITH MANUFACTURER'S STANDARD ENAMEL.
- F. FINISH: FOR ENCLOSURE OR CABINET COMPONENTS, PROVIDE MANUFACTURER'S STANDARD COLOR PAINT APPLIED AFTER FABRICATION TO FACTORY-ASSEMBLED SURFACE RACEWAYS, ENCLOSURES, AND CABINETS BEFORE SHIPPING.

2.4 SUPPORTING DEVICES

- A. MATERIAL: COLD-FORMED STEEL WITH CORROSION-RESISTANT COATING ACCEPTABLE TO AUTHORITIES HAVING JURISDICTION.
- B. METAL ITEMS FOR USE OUTDOORS OR IN DAMP LOCATIONS: HOT-DIP GALVANIZED STEEL.
- C. SLOTTED-STEEL CHANNEL SUPPORTS: FLANGE EDGES TURNED TOWARD WEB, AND 9/16-INCH DIAMETER SLOTTED HOLES AT A MAXIMUM OF 2 INCHES O.C., IN WEBS.
- D. SLOTTED-STEEL CHANNEL SUPPORTS:
1. CHANNEL THICKNESS: SELECTED TO SUIT STRUCTURAL LOADING.
2. FITTINGS AND ACCESSORIES: PRODUCTS OF THE SAME MANUFACTURER AS CHANNEL SUPPORTS.
- E. NONMETALLIC CHANNEL AND ANGLE SYSTEMS: STRUCTURAL-GRADE, FACTORY-FORMED, GLASS-FIBER-RESIN CHANNELS AND ANGLES WITH 9/16-INCH DIAMETER HOLES AT A MAXIMUM OF 8 INCHES O.C., IN AT LEAST ONE SURFACE.
1. FITTINGS AND ACCESSORIES: PRODUCTS OF THE SAME MANUFACTURER AS CHANNELS AND ANGLES.
2. FITTINGS AND ACCESSORY MATERIALS: SAME AS CHANNELS AND ANGLES, EXCEPT METAL ITEMS MAY BE STAINLESS STEEL.

F. RACEWAY AND CABLE SUPPORTS: MANUFACTURED CLEVIS HANGERS, RISER CLAMPS, STRAPS, THREADED C-CLAMPS WITH RETAINERS, CEILING TRAPEZE HANGERS, WALL BRACKETS, AND SPRING-STEEL CLAMPS OR CLICK-TYPE HANGERS.

G. PIPE SLEEVES: ASTM A53, TYPE E, GRADE A, SCHEDULE 40, GALVANIZED STEEL, PLAIN ENDS.

I. EXPANSION ANCHORS: CARBON-STEEL WEDGE OR SLEEVE TYPE.

J. TOGGLE BOLTS: ALL-STEEL SPRINGHEAD TYPE.

K. POWDER-DRIVEN THREADED STUDS: HEAT-TREATED STEEL.

2.5 ELECTRICAL IDENTIFICATION

- A. IDENTIFICATION DEVICES: A SINGLE TYPE OF IDENTIFICATION PRODUCT FOR EACH APPLICATION CATEGORY. USE COLORS PRESCRIBED BY ANSI A13.1, NFPA 70, AND THESE SPECIFICATIONS.
- B. RACEWAY AND CABLE LABELS: COMPLY WITH ANSI A13.1, TABLE 3, FOR MINIMUM SIZE OF LETTERS FOR LEGEND AND MINIMUM LENGTH OF COLOR FIELD FOR EACH RACEWAY AND CABLE SIZE.
- C. COLORED ADHESIVE MARKING TAPE FOR RACEWAYS, WIRES, AND CABLES: SELF-ADHESIVE VINYL TAPE, NOT LESS THAN 1 INCH WIDE BY 3 MILS THICK.
- E. TAPE MARKERS FOR WIRE: VINYL OR VINYL-CLOTH, SELF-ADHESIVE, WRAPAROUND TYPE WITH PREPRINTED NUMBERS AND LETTERS.
- F. ENGRAVED-PLASTIC LABELS, SIGNS, AND INSTRUCTION PLATES: ENGRAVING STOCK, MELAMINE PLASTIC LAMINATE PUNCHED OR DRILLED FOR MECHANICAL FASTENERS 1/16-INCH MINIMUM THICKNESS FOR SIGNS UP TO 20 SQ. IN. AND 1/8-INCH MINIMUM THICKNESS FOR LARGER SIZES. LABELS SHALL BE COLOR CODED ACCORDING TO SERVICE/USE OR VOLTAGE AS SCHEDULED HEREIN. LETTERS SHALL BE ENGRAVED, 5/32-INCH HIGH AND ALL CAPITALS.

SERVICE	SURFACE COLOR	LETTER COLOR
POWER: 480 V	WHITE	BLACK
POWER: 240 V (208 V)	YELLOW	BLACK
SECURITY	GREEN	WHITE OR YELLOW
TELEVISION/VIDEO	PURPLE	WHITE

G. INTERIOR WARNING AND CAUTION SIGNS: COMPLY WITH 29 CFR, CHAPTER XVII, PART 1910.145. PREPRINTED, ALUMINUM, BAKED-ENAMEL-FINISH SIGNS, PUNCHED OR DRILLED FOR MECHANICAL FASTENERS, WITH COLORS, LEGEND, AND SIZE APPROPRIATE TO THE APPLICATION.

H. FASTENERS FOR NAMEPLATES AND SIGNS: SELF-TAPPING, STAINLESS-STEEL SCREWS OR NO. 10/32 STAINLESS-STEEL MACHINE SCREWS WITH NUTS AND FLAT AND LOCK WASHERS.

I. RECEPTACLES: TRANSPARENT, VINYL OR MYLAR, ADHESIVE-BACKED LABELS HAVING MACHINE PRINTING WITH BLACK NUMBERS AND LETTERS.

2.6 TOUCHUP PAINT

A. FOR EQUIPMENT: EQUIPMENT MANUFACTURER'S PAINT SELECTED TO MATCH INSTALLED EQUIPMENT FINISH.

PART 3 – EXECUTION

3.1 ELECTRICAL EQUIPMENT INSTALLATION

A. HEADROOM MAINTENANCE: IF MOUNTING HEIGHTS OR OTHER LOCATION CRITERIA ARE NOT INDICATED, ARRANGE AND INSTALL COMPONENTS AND EQUIPMENT TO PROVIDE THE MAXIMUM POSSIBLE HEADROOM.

B. MATERIALS AND COMPONENTS: INSTALL LEVEL, PLUMB, AND PARALLEL AND PERPENDICULAR TO OTHER BUILDING SYSTEMS AND COMPONENTS, UNLESS OTHERWISE INDICATED.

C. EQUIPMENT: INSTALL TO FACILITATE SERVICE, MAINTENANCE, AND REPAIR OR REPLACEMENT OF COMPONENTS. CONNECT FOR EASE OF DISCONNECTING, WITH MINIMUM INTERFERENCE WITH OTHER INSTALLATIONS.

D. RIGHT OF WAY: GIVE TO RACEWAYS AND PIPING SYSTEMS INSTALLED AT A REQUIRED SLOPE.

E. WORKING CLEARANCE: WORKING CLEARANCES AROUND EQUIPMENT REQUIRING ELECTRICAL SERVICE SHALL COMPLY WITH NEC REQUIREMENTS. NOTIFY THE OWNER OF VIOLATIONS BEFORE PROCEEDING WITH CONNECTION OR PLACEMENT OF EQUIPMENT.

3.2 RACEWAY APPLICATION

A. USE THE FOLLOWING RACEWAYS FOR OUTDOOR INSTALLATIONS:

1. EXPOSED: RGS.
2. CONNECTION TO VIBRATING EQUIPMENT: LFMC.
3. BOXES AND MW: NEMA 250, TYPE 4X, UNLESS OTHERWISE SPECIFIED
4. ENCLOSURES: NEMA 250, TYPE 4X, UNLESS OTHERWISE SPECIFIED

B. USE THE FOLLOWING RACEWAYS FOR INDOOR INSTALLATIONS:

1. EXPOSED: RGS.
2. CONCEALED: RGS.
3. CONNECTION TO VIBRATING EQUIPMENT: FMC; EXCEPT IN WET OR DAMP LOCATIONS, USE LFMC.
4. DAMP OR WET LOCATIONS: IMC OR LFMC.
5. BOXES, SMR, AND ENCLOSURES: NEMA 250, TYPE 1, UNLESS OTHERWISE INDICATED.
- C. MINIMUM RACEWAY SIZE: FOR POWER AND CONTROL: 3/4-INCH TRADE SIZE. FOR TELECOMMUNICATIONS (COMM): 3/4-INCH TRADE SIZE.

3.3 RACEWAY AND CABLE INSTALLATION

- A. INSTALL RACEWAYS AND CABLES AT LEAST 6 INCHES AWAY FROM PARALLEL RUNS OF FLUES AND STEAM OR HOT-WATER PIPES. LOCATE HORIZONTAL RACEWAY RUNS ABOVE WATER AND STEAM PIPING.
- B. USE TEMPORARY RACEWAY CAPS TO PREVENT FOREIGN MATTER FROM ENTERING.
- C. MAKE CONDUIT BENDS AND OFFSETS SO INTERIOR DIAMETER IS NOT REDUCED. KEEP LEGS OF BENDS IN THE SAME PLANE AND STRAIGHT LEGS OF OFFSETS PARALLEL, UNLESS OTHERWISE INDICATED.
- D. USE RACEWAY AND CABLE FITTINGS COMPATIBLE WITH RACEWAYS AND CABLES AND SUITABLE FOR USE AND LOCATION.
1. USE INSULATING BUSHINGS TO PROTECT CONDUCTORS.

E. INSTALL RACEWAYS EMBEDDED IN SLABS IN MIDDLE THIRD OF SLAB THICKNESS WHERE PRACTICAL, AND LEAVE AT LEAST 1-INCH CONCRETE COVER.

1. SECURE RACEWAYS TO REINFORCING RODS TO PREVENT SAGGING OR SHIFTING DURING CONCRETE PLACEMENT.

2. SPACE RACEWAYS Laterally TO PREVENT VOIDS IN CONCRETE.

3. INSTALL CONDUIT LARGER THAN 1-INCH TRADE SIZE PARALLEL TO OR AT RIGHT ANGLES TO MAIN REINFORCEMENT. WHERE CONDUIT IS AT RIGHT ANGLES TO REINFORCEMENT, PLACE CONDUIT CLOSE TO SLAB SUPPORT.

4. TRANSITION FROM NONMETALLIC CONDUIT TO RIGID STEEL CONDUIT OR IMC BEFORE RISING ABOVE GRADE.

5. MAKE BENDS IN EXPOSED PARALLEL OR BANKED RUNS FROM SAME CENTERLINE TO MAKE BENDS PARALLEL. USE FACTORY ELBOWS ONLY WHERE ELBOWS CAN BE INSTALLED PARALLEL; OTHERWISE, PROVIDE FIELD BENDS FOR EXPOSED PARALLEL RACEWAYS.

F. INSTALL PULL WIRES IN EMPTY RACEWAYS. USE NO. 14 AWG ZINC-COATED STEEL OR MONOFILAMENT PLASTIC LINE WITH NOT LESS THAN 200-LB TENSILE STRENGTH. LEAVE AT LEAST 2 FEET OF SLACK AT EACH END OF THE PULL WIRE.

G. INSTALL OCTV RACEWAYS, 2-INCH TRADESIZE AND SMALLER, IN MAXIMUM LENGTHS OF 150 FEET (INDOOR), 325 (OUTDOOR) AND WITH A MAXIMUM OF TWO 90-DEGREE BENDS OR EQUIVALENT. SEPARATE LENGTHS WITH PULL BOXES WHERE NECESSARY TO COMPLY WITH THESE REQUIREMENTS, IN ADDITION TO REQUIREMENTS ABOVE.

H. CONNECT MOTORS AND EQUIPMENT SUBJECT TO VIBRATION, NOISE TRANSMISSION, OR MOVEMENT WITH A MAXIMUM OF 72-INCH FLEXIBLE CONDUIT. INSTALL LFMC IN WET OR DAMP LOCATIONS. INSTALL SEPARATE GROUND CONDUCTOR ACROSS FLEXIBLE CONNECTIONS.

I. INSTALL EXPOSED RACEWAYS PARALLEL OR AT RIGHT ANGLES TO NEARBY SURFACES OR STRUCTURAL MEMBERS AND FOLLOW SURFACE CONTOURS AS MUCH AS POSSIBLE.

1. RUN PARALLEL OR BANKED RACEWAYS TOGETHER ON COMMON.
2. MAKE PARALLEL BENDS IN PARALLEL OR BANKED RUNS. USE FACTORY ELBOWS ONLY WHERE ELBOWS CAN BE INSTALLED PARALLEL; OTHERWISE, PROVIDE FIELD BENDS FOR PARALLEL RACEWAYS.

J. TERMINATIONS:

1. WHERE RACEWAYS ARE TERMINATED WITH LOCKNUTS AND BUSHINGS, ALIGN RACEWAYS TO ENTER SQUARELY AND INSTALL LOCKNUTS WITH DISHED PART AGAINST BOX. USE TWO LOCKNUTS, ONE INSIDE AND ONE OUTSIDE BOX.

2. WHERE RACEWAYS ARE TERMINATED WITH THREADED HUBS, SCREW RACEWAYS OR FITTINGS TIGHTLY INTO HUB SO END BEARS AGAINST WIRE PROTECTION SHOULDER. WHERE CHASE NIPPLES ARE USED, ALIGN RACEWAYS SO COUPLING IS SQUARE TO BOX; TIGHTEN CHASE NIPPLE SO NO THREADS ARE EXPOSED.

K. SURFACE RACEWAYS: INSTALL A SEPARATE, GREEN, GROUND CONDUCTOR IN RACEWAYS FROM JUNCTION BOX SUPPLYING RACEWAYS TO RECEPTACLE OR FIXTURE GROUND TERMINALS.

L. INSTALL HINGED-COVER ENCLOSURES AND CABINETS PLUMB. SUPPORT AT EACH CORNER.

AS-BUILT
TO THE BEST OF OUR KNOWLEDGE
THESE DRAWINGS REPRESENT THE
AS CONSTRUCTED CONDITIONS OF
THIS PROJECT.


ACON CONSTRUCTION CO., INC.

REVISIONS			DESIGNED BY: DAO	DRAWN BY: CDM	CHECKED BY: SJC	APPROVED BY: JDC
DESCRIPTION	BY	APVD				

RS&H

10748 Deerwood Park Blvd. South
Jacksonville, Florida 32256
904-256-2500
Certificate of Authorization No. 5620
Engineer of Record: Stephen Conway, P.E. No.: 53532

JAXPORT
JACKSONVILLE PORT AUTHORITY

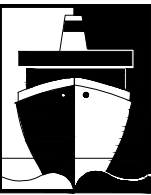

DAMES POINT MARINE TERMINAL
CRUISE TERMINAL GANGWAY

ELECTRICAL SPECIFICATIONS

SHEET	E-5
DATE	JULY 2018
CONTRACT NO.	C-1575A

